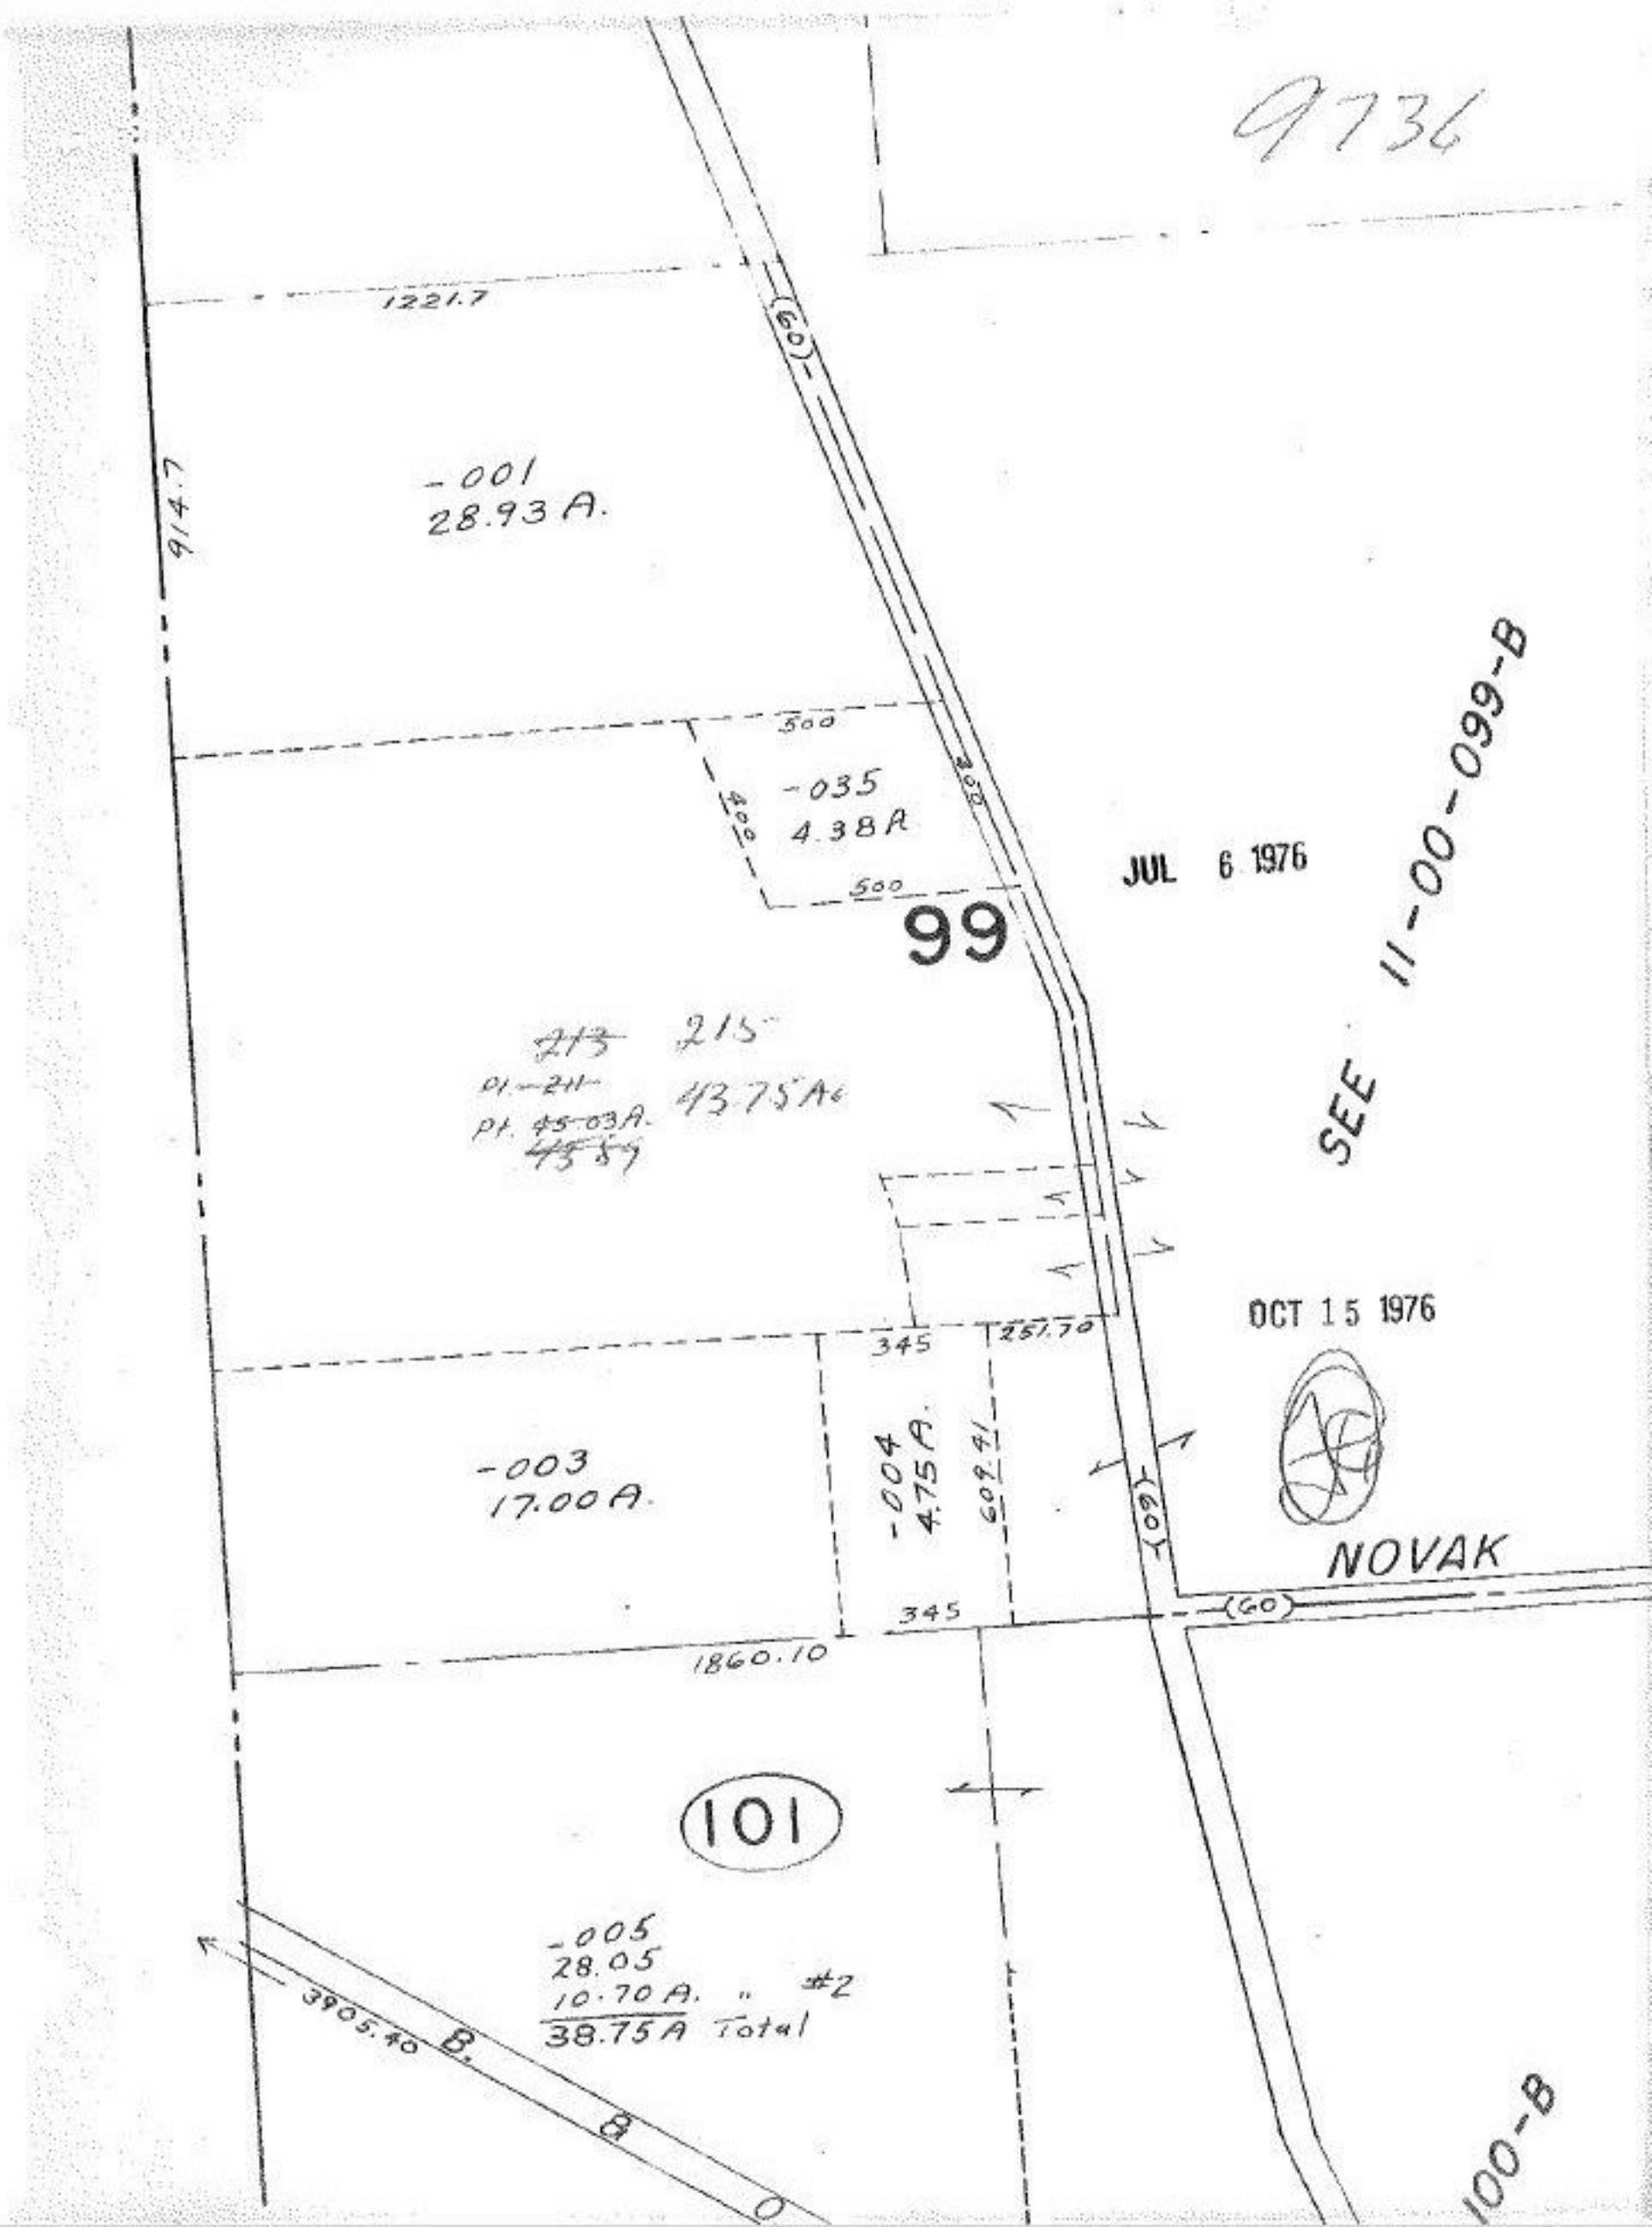
9736
1221.7
(60)
914.7
-001
28.93 A.
500
-035
4.38 A
400
400
500
99
JUL 6 1976
SEE 11-00-099-B
~~213~~ 215
Pt. ~~211~~
Pt. ~~45.03A.~~
~~43.59~~
43.75 A
OCT 15 1976
345
251.70
-003
17.00 A.
-004
4.75 A.
609.41
(60)
NOVAK
(60)
345
1860.10
101
-005
28.05
10.70 A. " #2
38.75 A Total
3905.40
B.
B
O
100-B