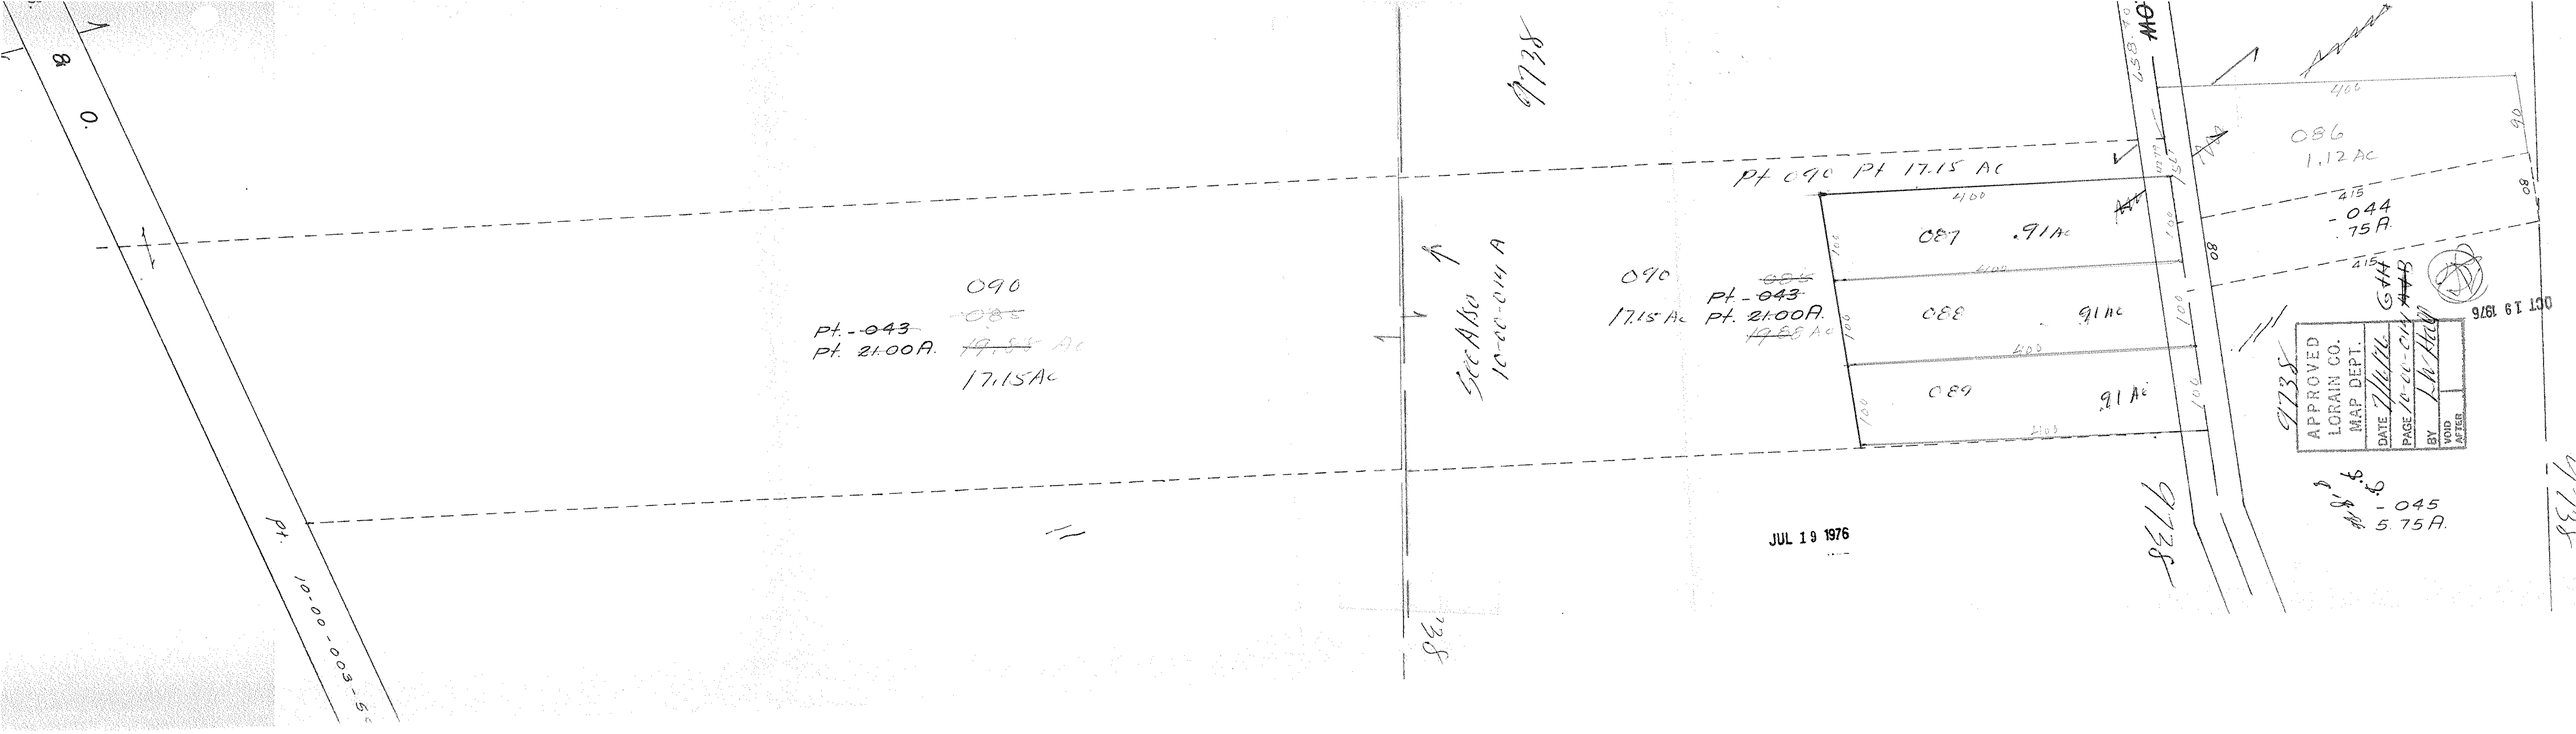
Pt. 10-00-003-5
090
Pt.-043
Pt. 21.00A.
17.15Ac
See Ab 10-00-044 A
090
17.15 Ac
Pt.-043
Pt. 21.00A.
Pt 090 Pt 17.15 Ac
087 .91Ac
088 .91Ac
089 .91Ac
086
1.12 Ac
-044
.75A.
-045
5.75A.
JUL 19 1976
APPROVED
LORAIN CO.
MAP DEPT.
DATE
PAGE
BY
VOID AFTER