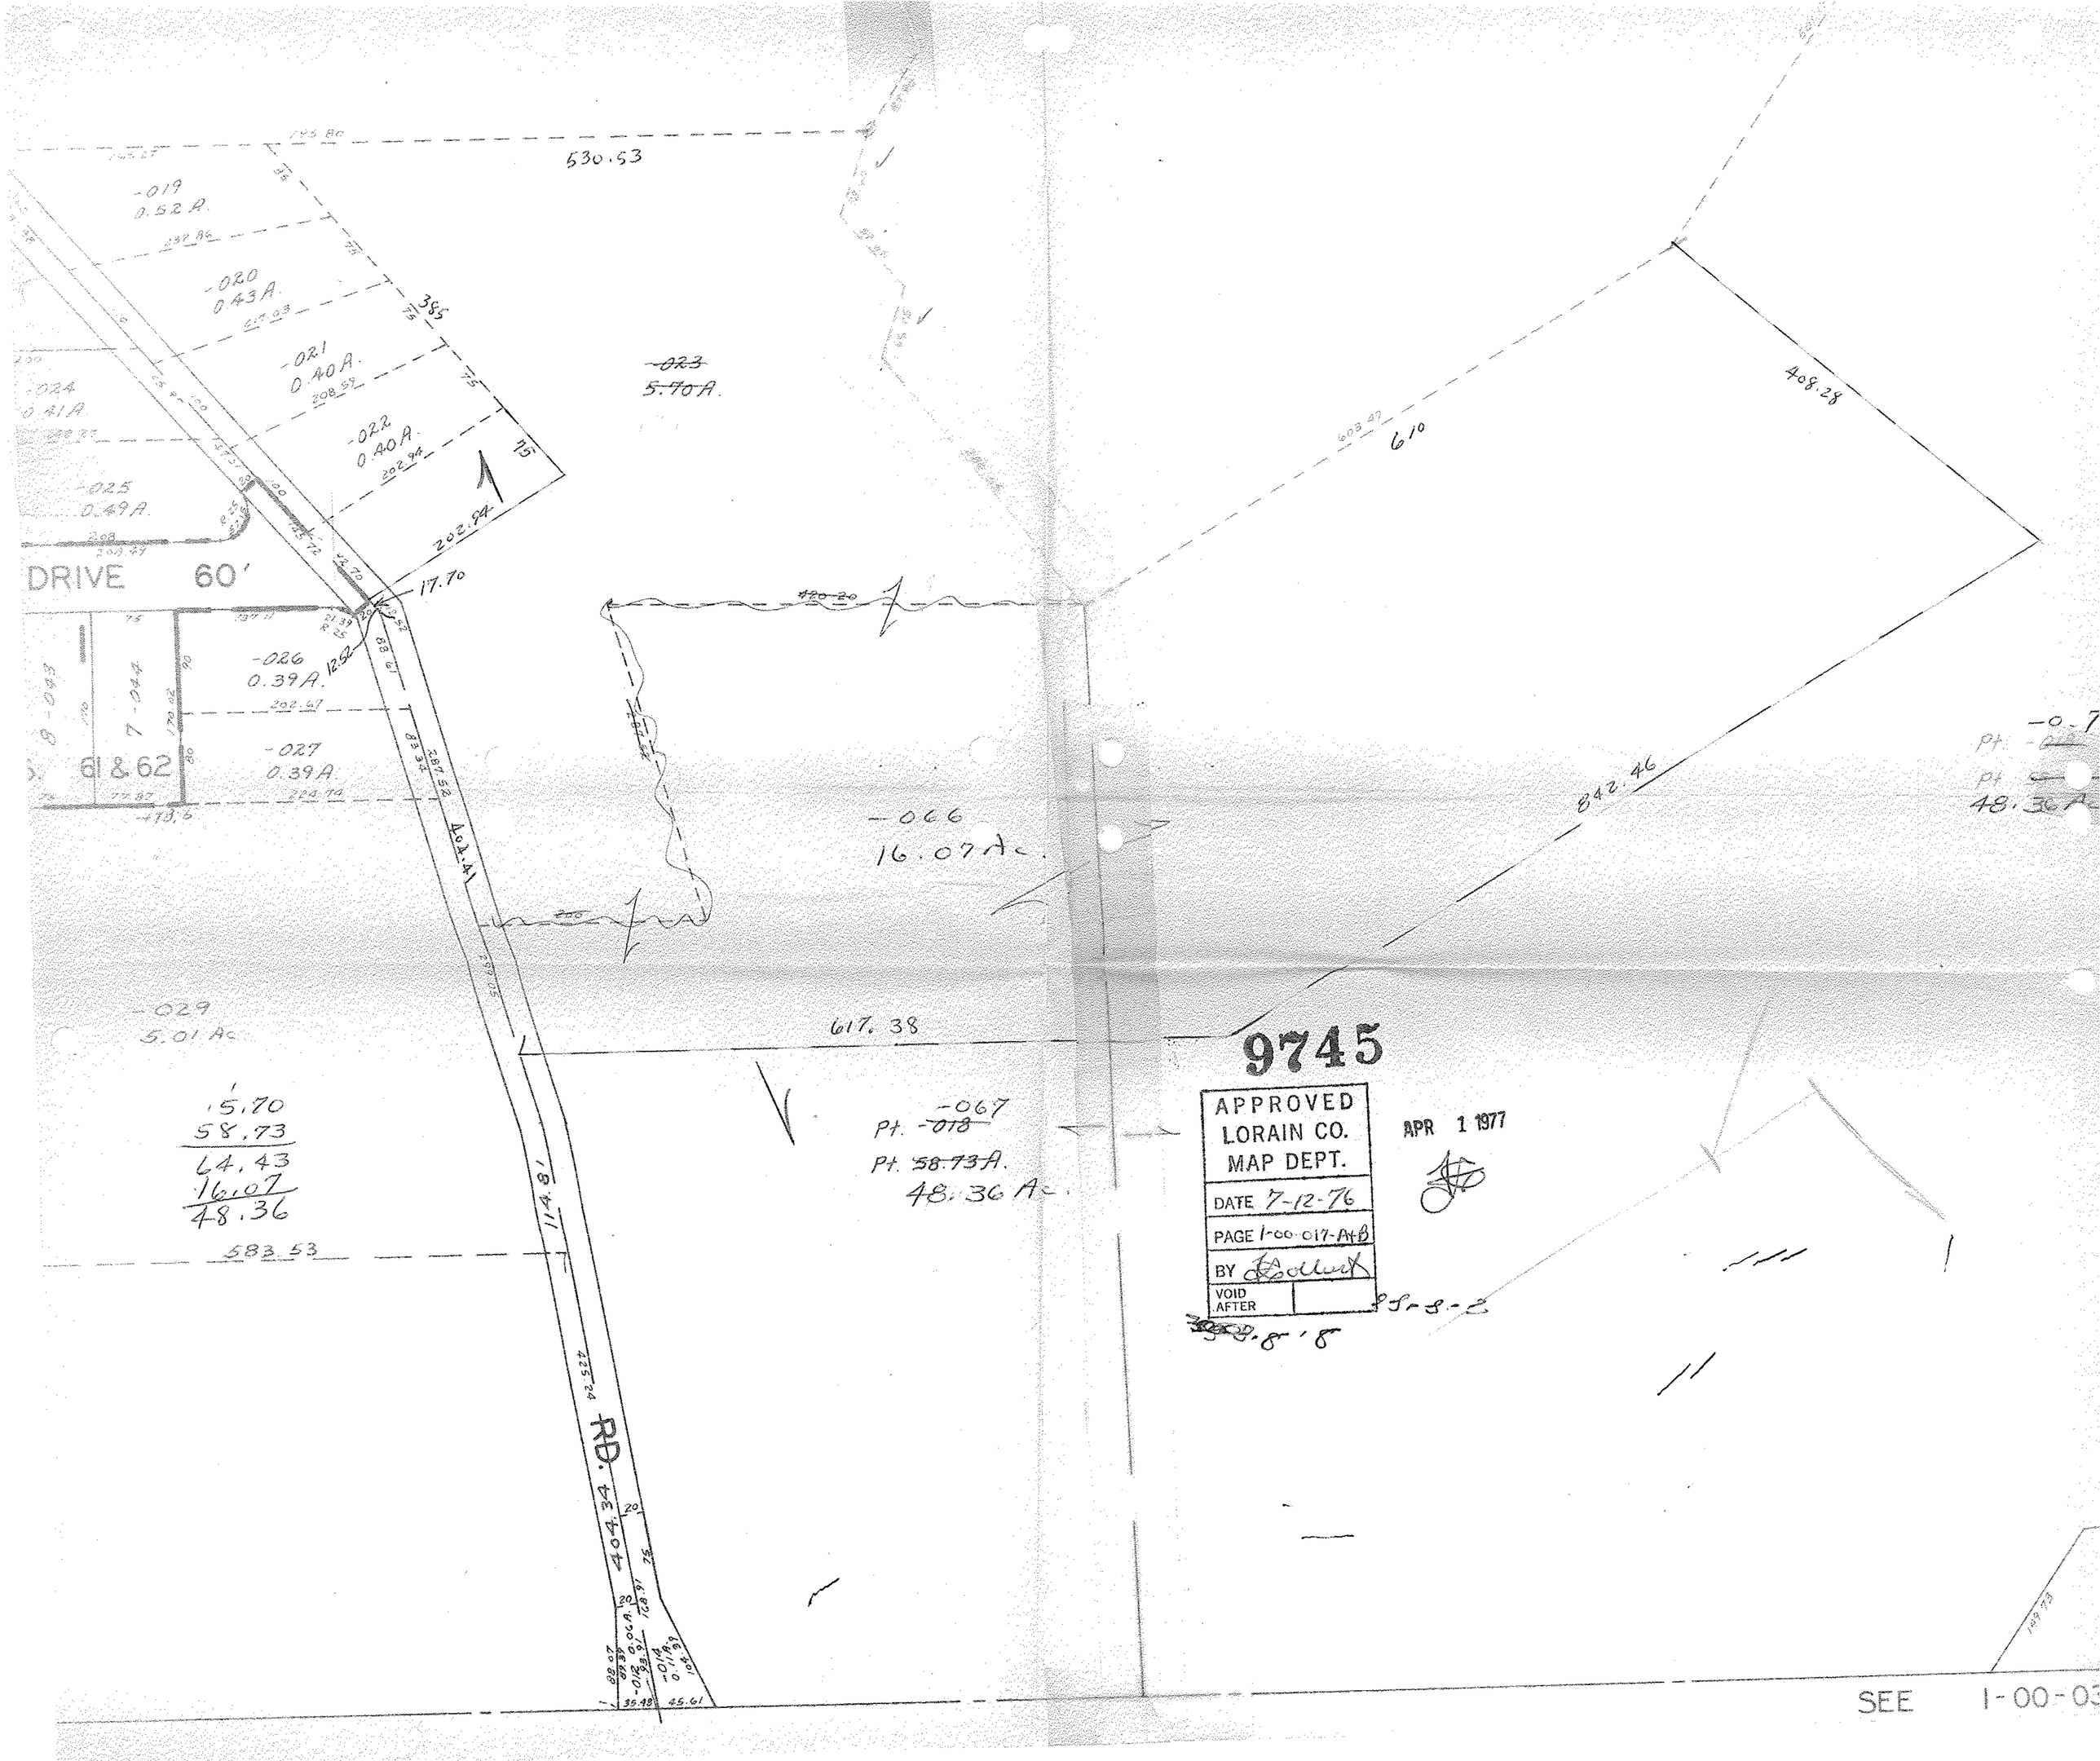

530.53
-019
0.52 A.
-020
0.43 A.
-021
0.40 A.
-022
0.40 A.
-023
5.70 A.
-024
0.41 A.
-025
0.49 A.
DRIVE 60'
-026
0.39 A.
-027
0.39 A.
61 & 62
17.70
12.52
202.94
385
75
610
408.28
842.46
-066
16.07 Ac.
-029
5.01 Ac.
617.38
5.70
58.73
64.43
16.07
48.36
583.53
-067
Pt. -018
Pt. 58.73 A.
48.36 Ac.
114.81
RD.
404.34
9745
APPROVED
LORAIN CO.
MAP DEPT.
DATE 7-12-76
PAGE 1-00-017-A+B
BY
VOID AFTER
APR 1 1977
SEE 1-00-03