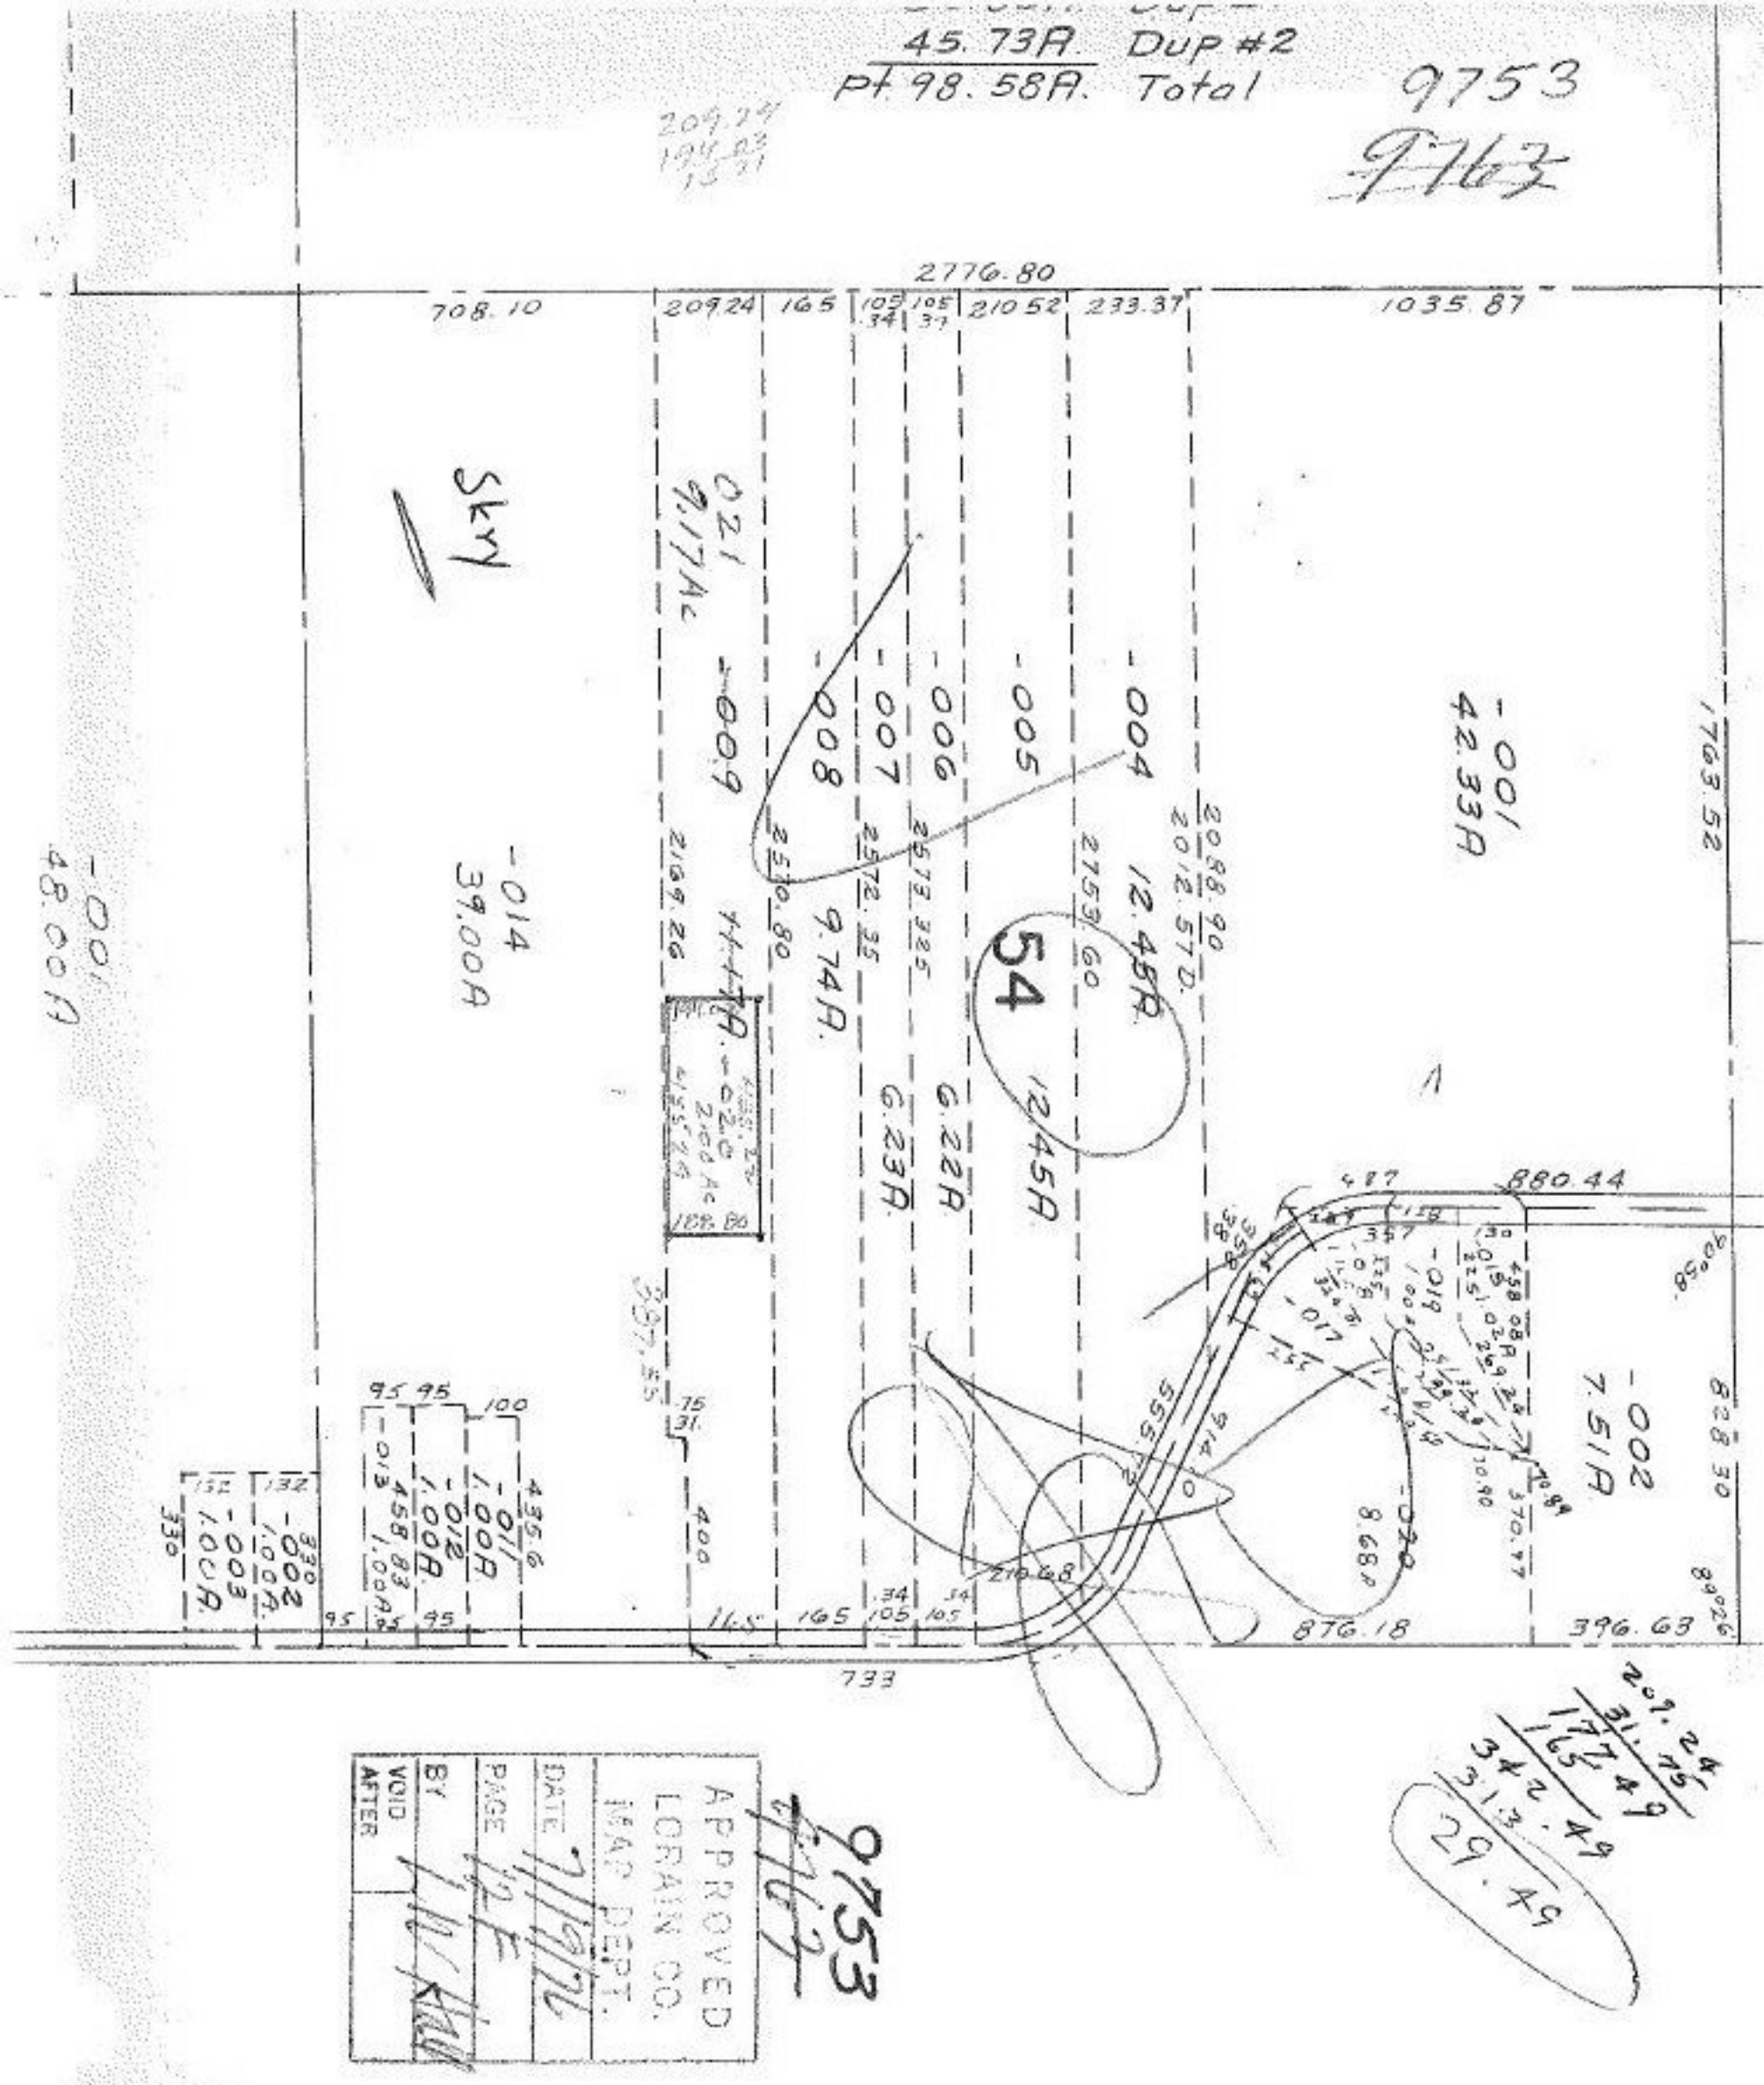
45.73A. Dup #2
Pt. 98.58A. Total
9753
9763
2776.80
708.10
209.24
165
105.34
105.37
210.52
233.37
1035.87
Sky
021
9.17Ac
-009
-008
-007
-006
-005
-004
-001
42.33A
1763.52
-014
39.00A
-001
48.00A
2169.26
2570.80
2572.35
2573.325
2753.60
2088.90
2012.57D.
9.74A.
12.45A.
54
6.23A.
6.22A.
12.45A.
880.44
-002
7.51A
828.30
-011
1.00A.
-012
1.00A.
-013
1.00A.
-002
1.00A.
-003
1.00A.
435.6
458.83
400
210.68
876.18
396.63
733
209.24
31.75
177.49
165
342.49
313
29.49
9753
9763
APPROVED
LORAIN CO.
MAP DEPT.
DATE
PAGE
BY
VOID
AFTER