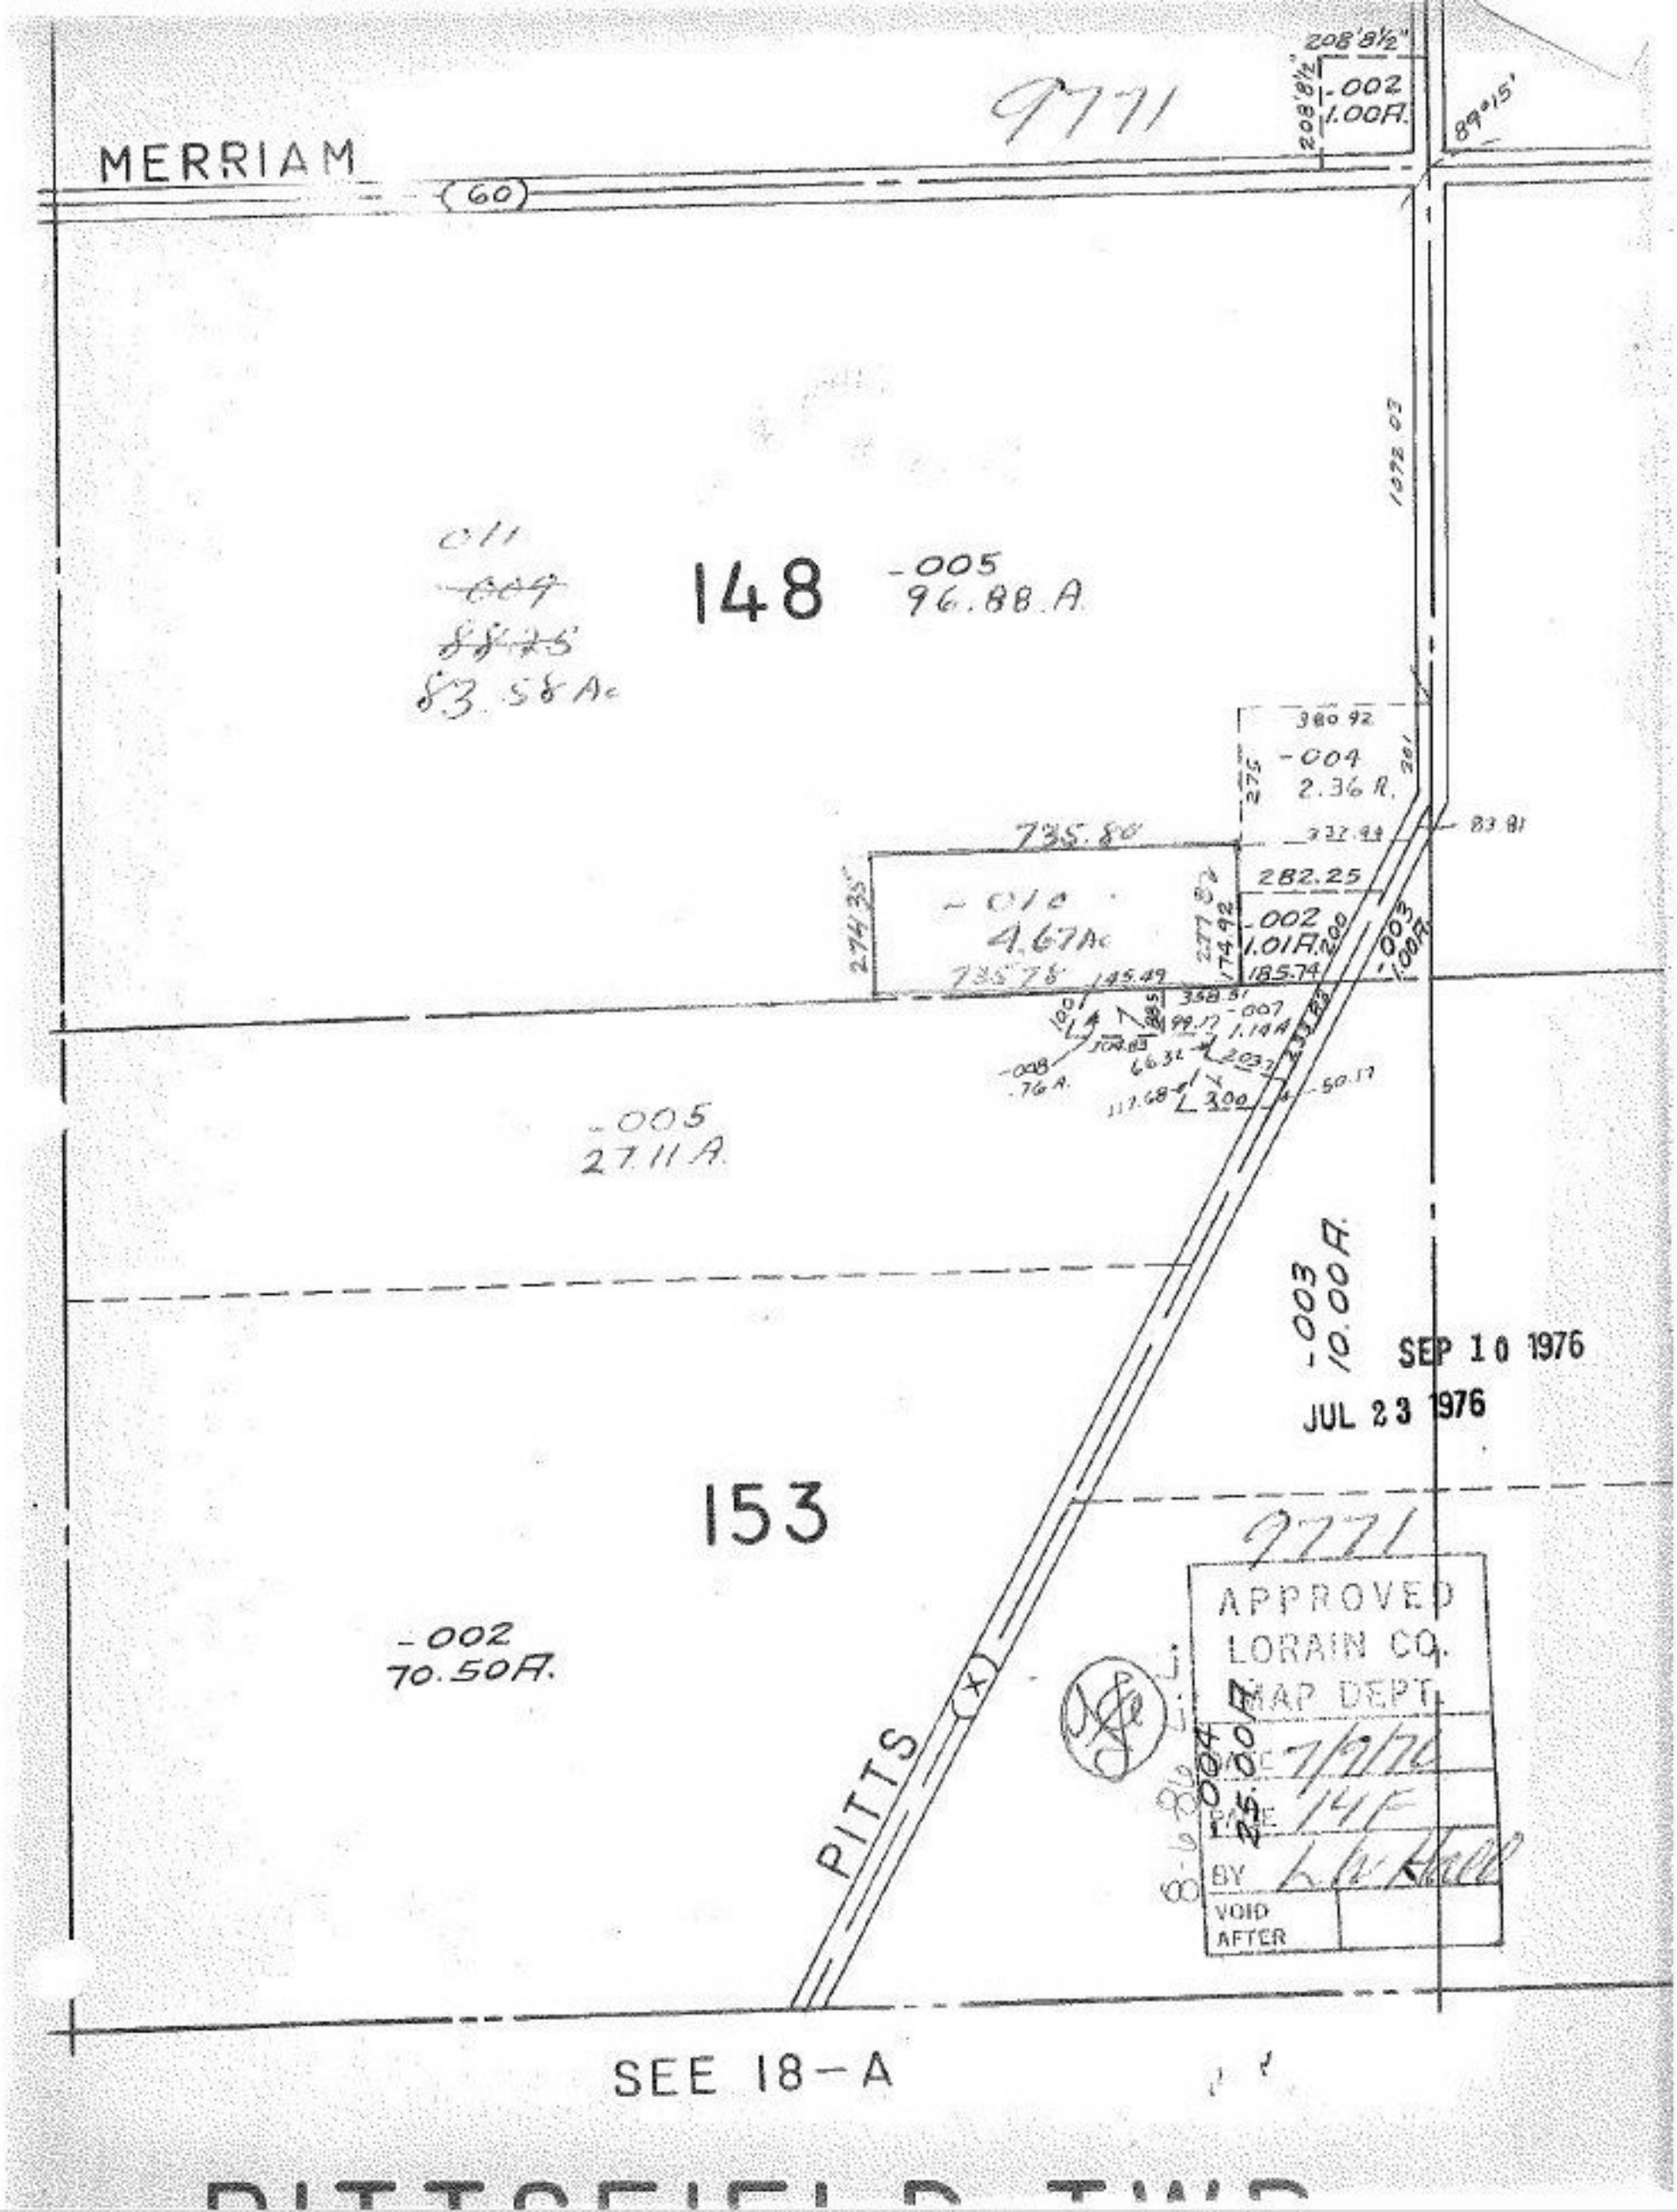

MERRIAM
(60)
9771
208'8½"
-002
1.00A.
89°15'
148
-005
96.88 A.
011
~~-009~~
~~88.25~~
83.58 Ac
380.92
-004
2.36 A.
735.80
282.25
-010
4.67Ac
735.78
-002
1.01A.
185.74
-003
1.00A.
-005
27.11 A.
-003
10.00A.
SEP 10 1976
JUL 23 1976
153
-002
70.50A.
PITTS
(X)
9771
APPROVED
LORAIN CO.
MAP DEPT.
DATE 7/9/76
PAGE 14F
BY L.W. Hall
VOID
AFTER
SEE 18-A