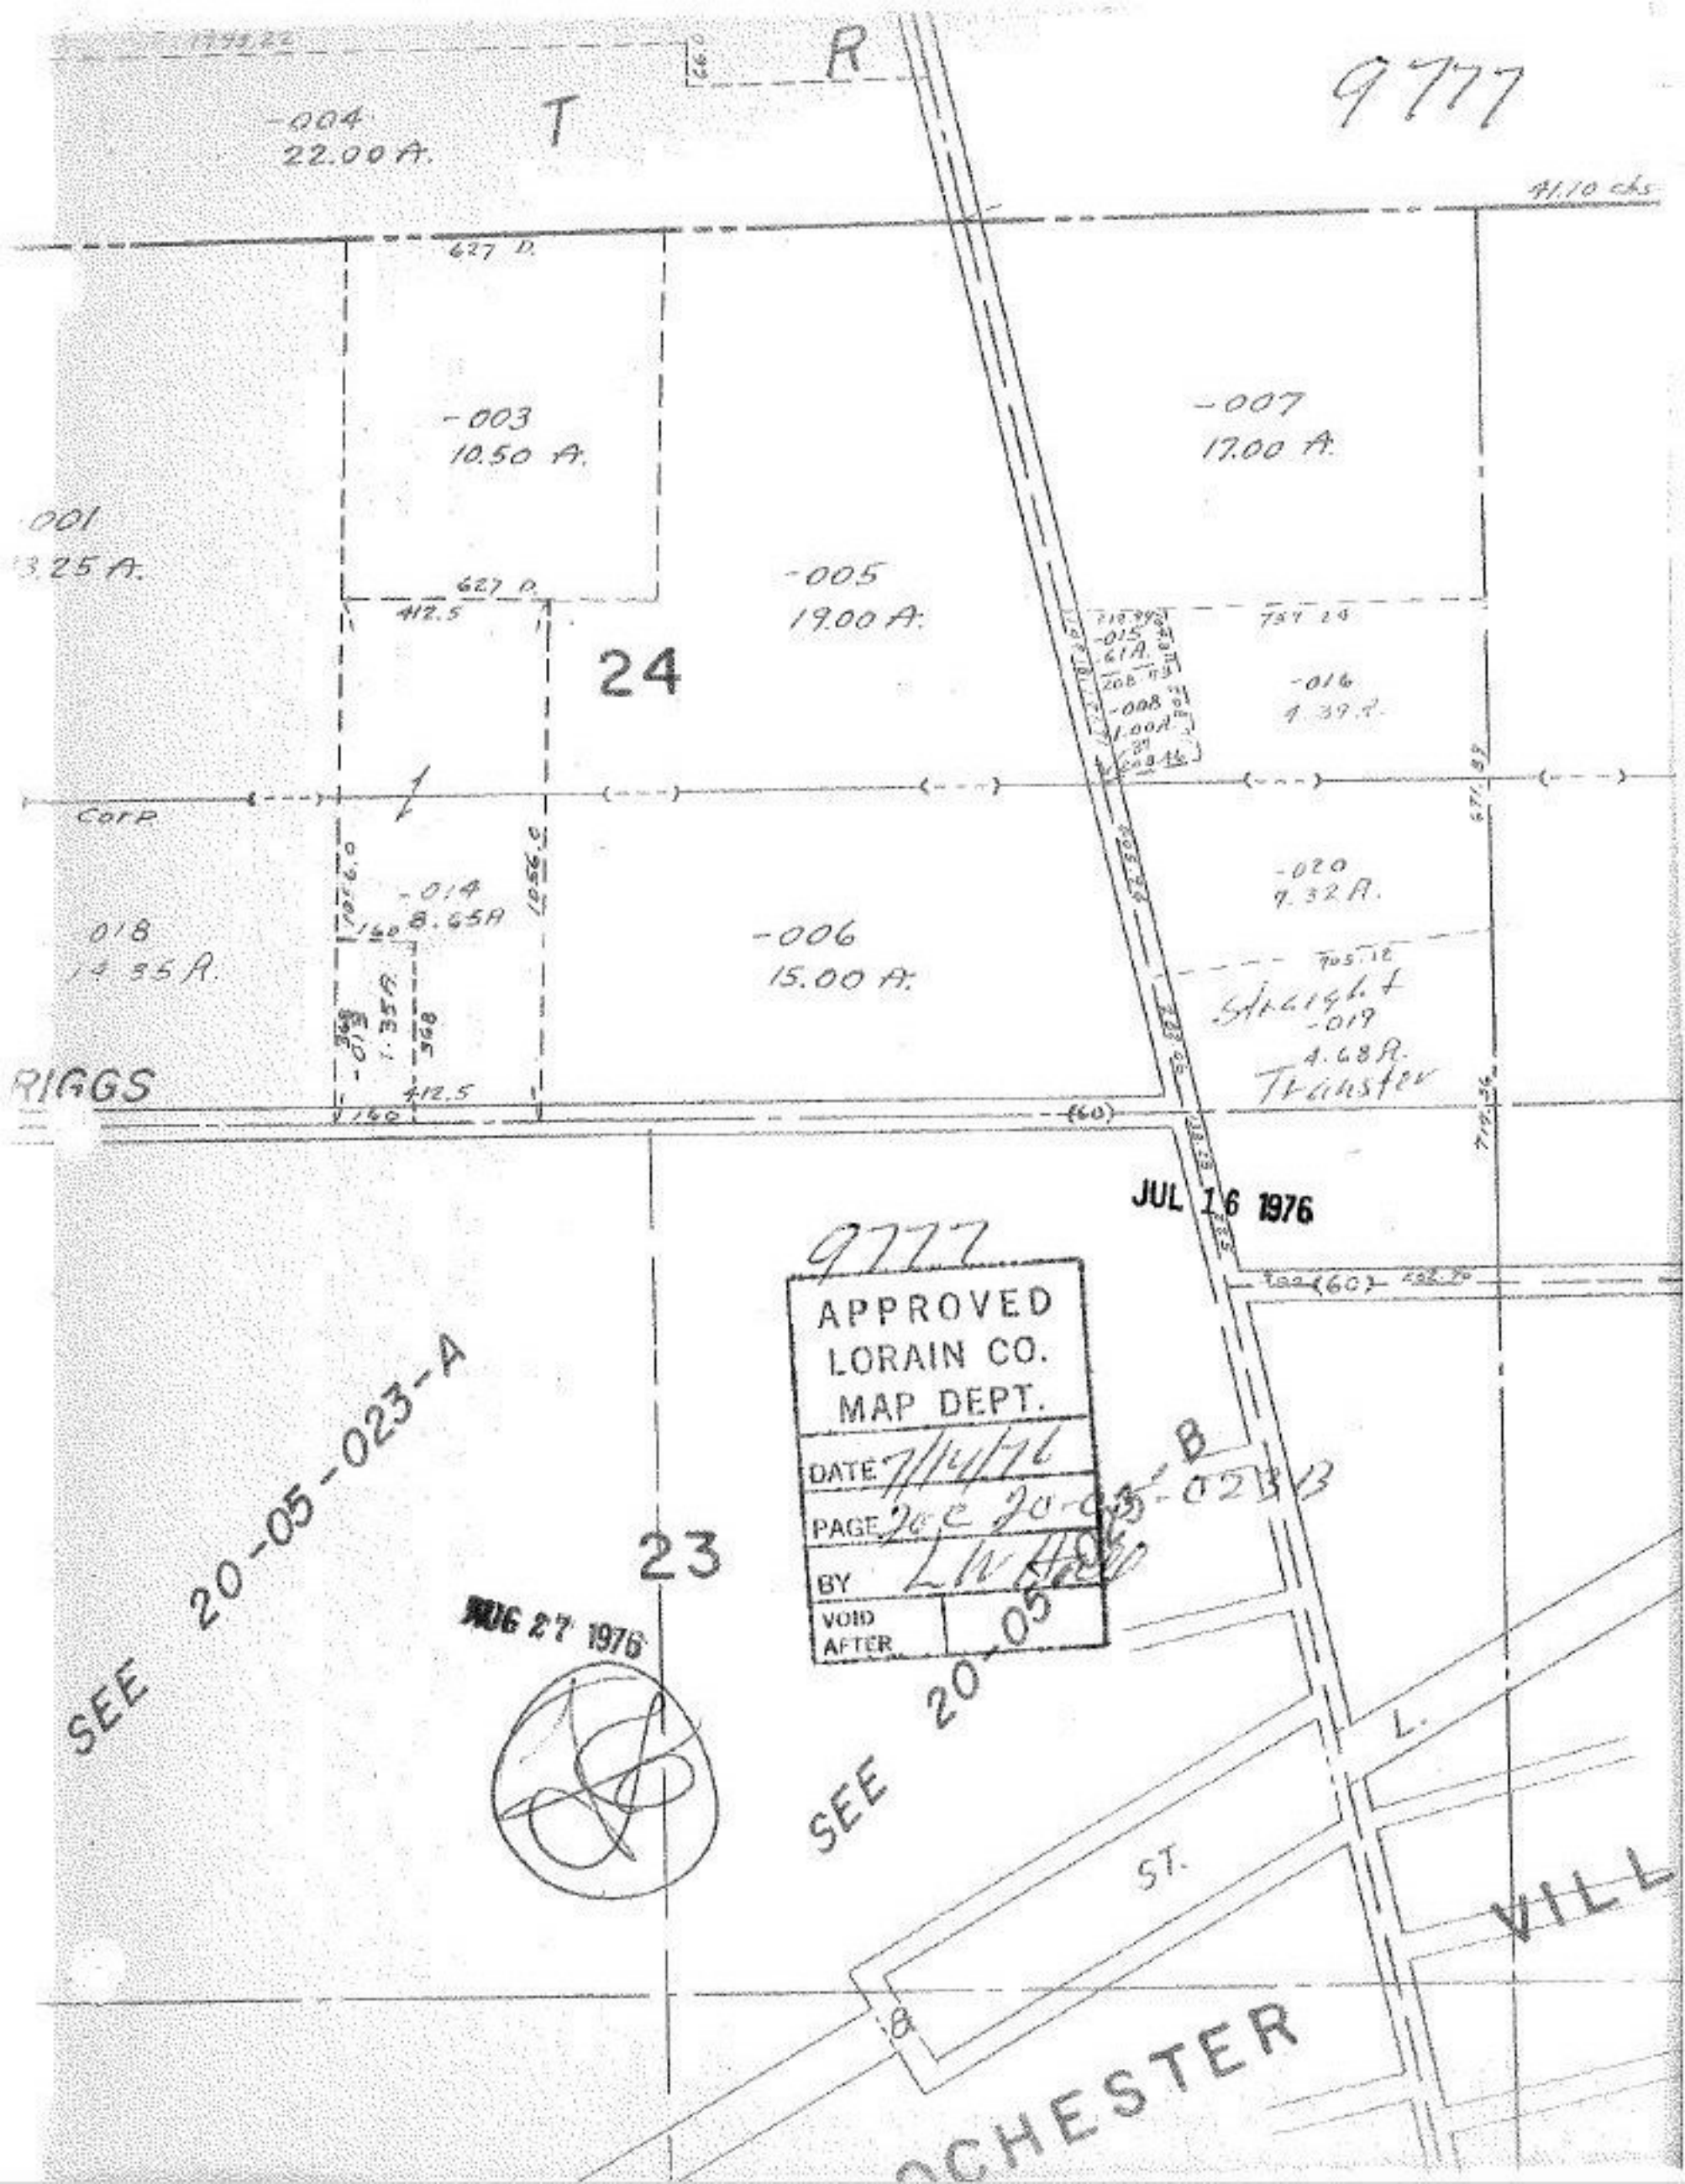
9777
R
T
-004
22.00 A.
41.10 chs
627 D.
-003
10.50 A.
-007
17.00 A.
-001
3.25 A.
627 D.
412.5
-005
19.00 A.
24
-015
.61 A.
-008
1.00 A.
-016
4.39 A.
Corp.
-014
8.65 A
-020
7.32 A.
-018
14.35 A.
-006
15.00 A.
Straight
-019
4.68 A.
Transfer
RIGGS
412.5
160
(60)
JUL 16 1976
9777
APPROVED
LORAIN CO.
MAP DEPT.
DATE 7/14/76
PAGE 20C 20-05-023B
BY
VOID AFTER
SEE 20-05-023-A
23
AUG 27 1976
SEE 20-05-023-B
L.
ST.
VILL
OCHESTER