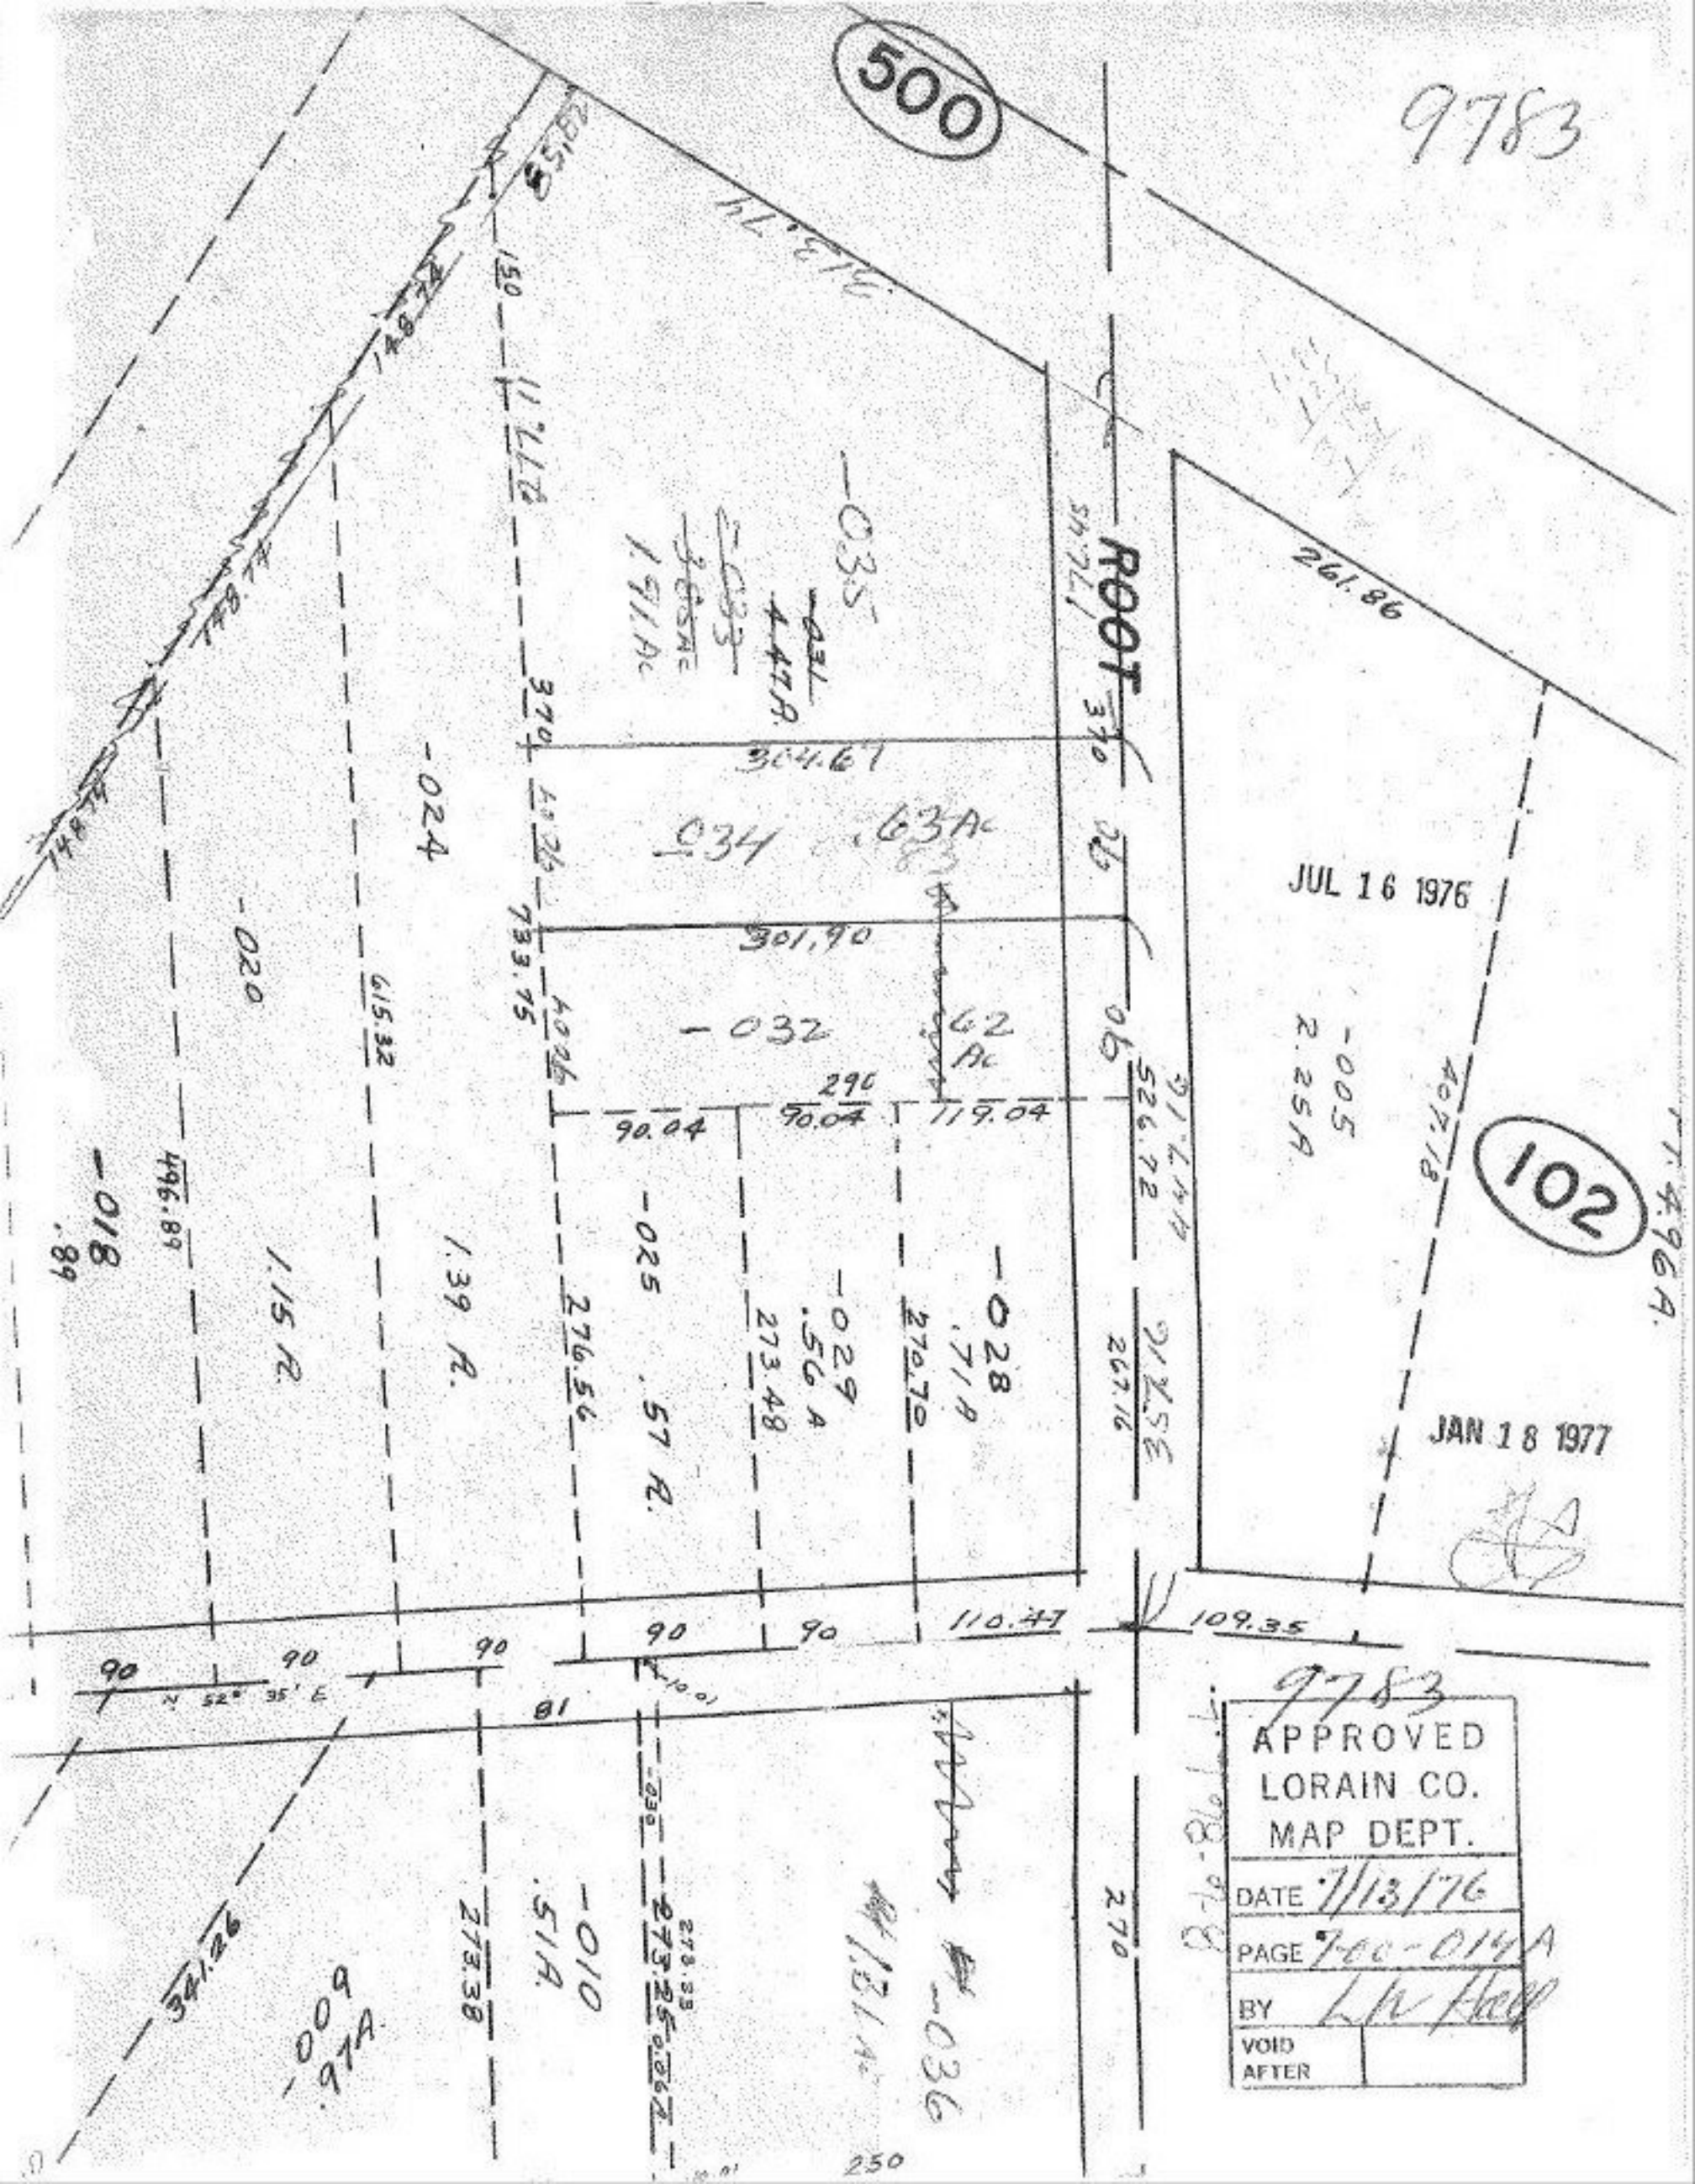

APPROVED
LORAIN CO.
MAP DEPT.
DATE 7/13/76
PAGE 700-014A
BY LW Hall
VOID AFTER