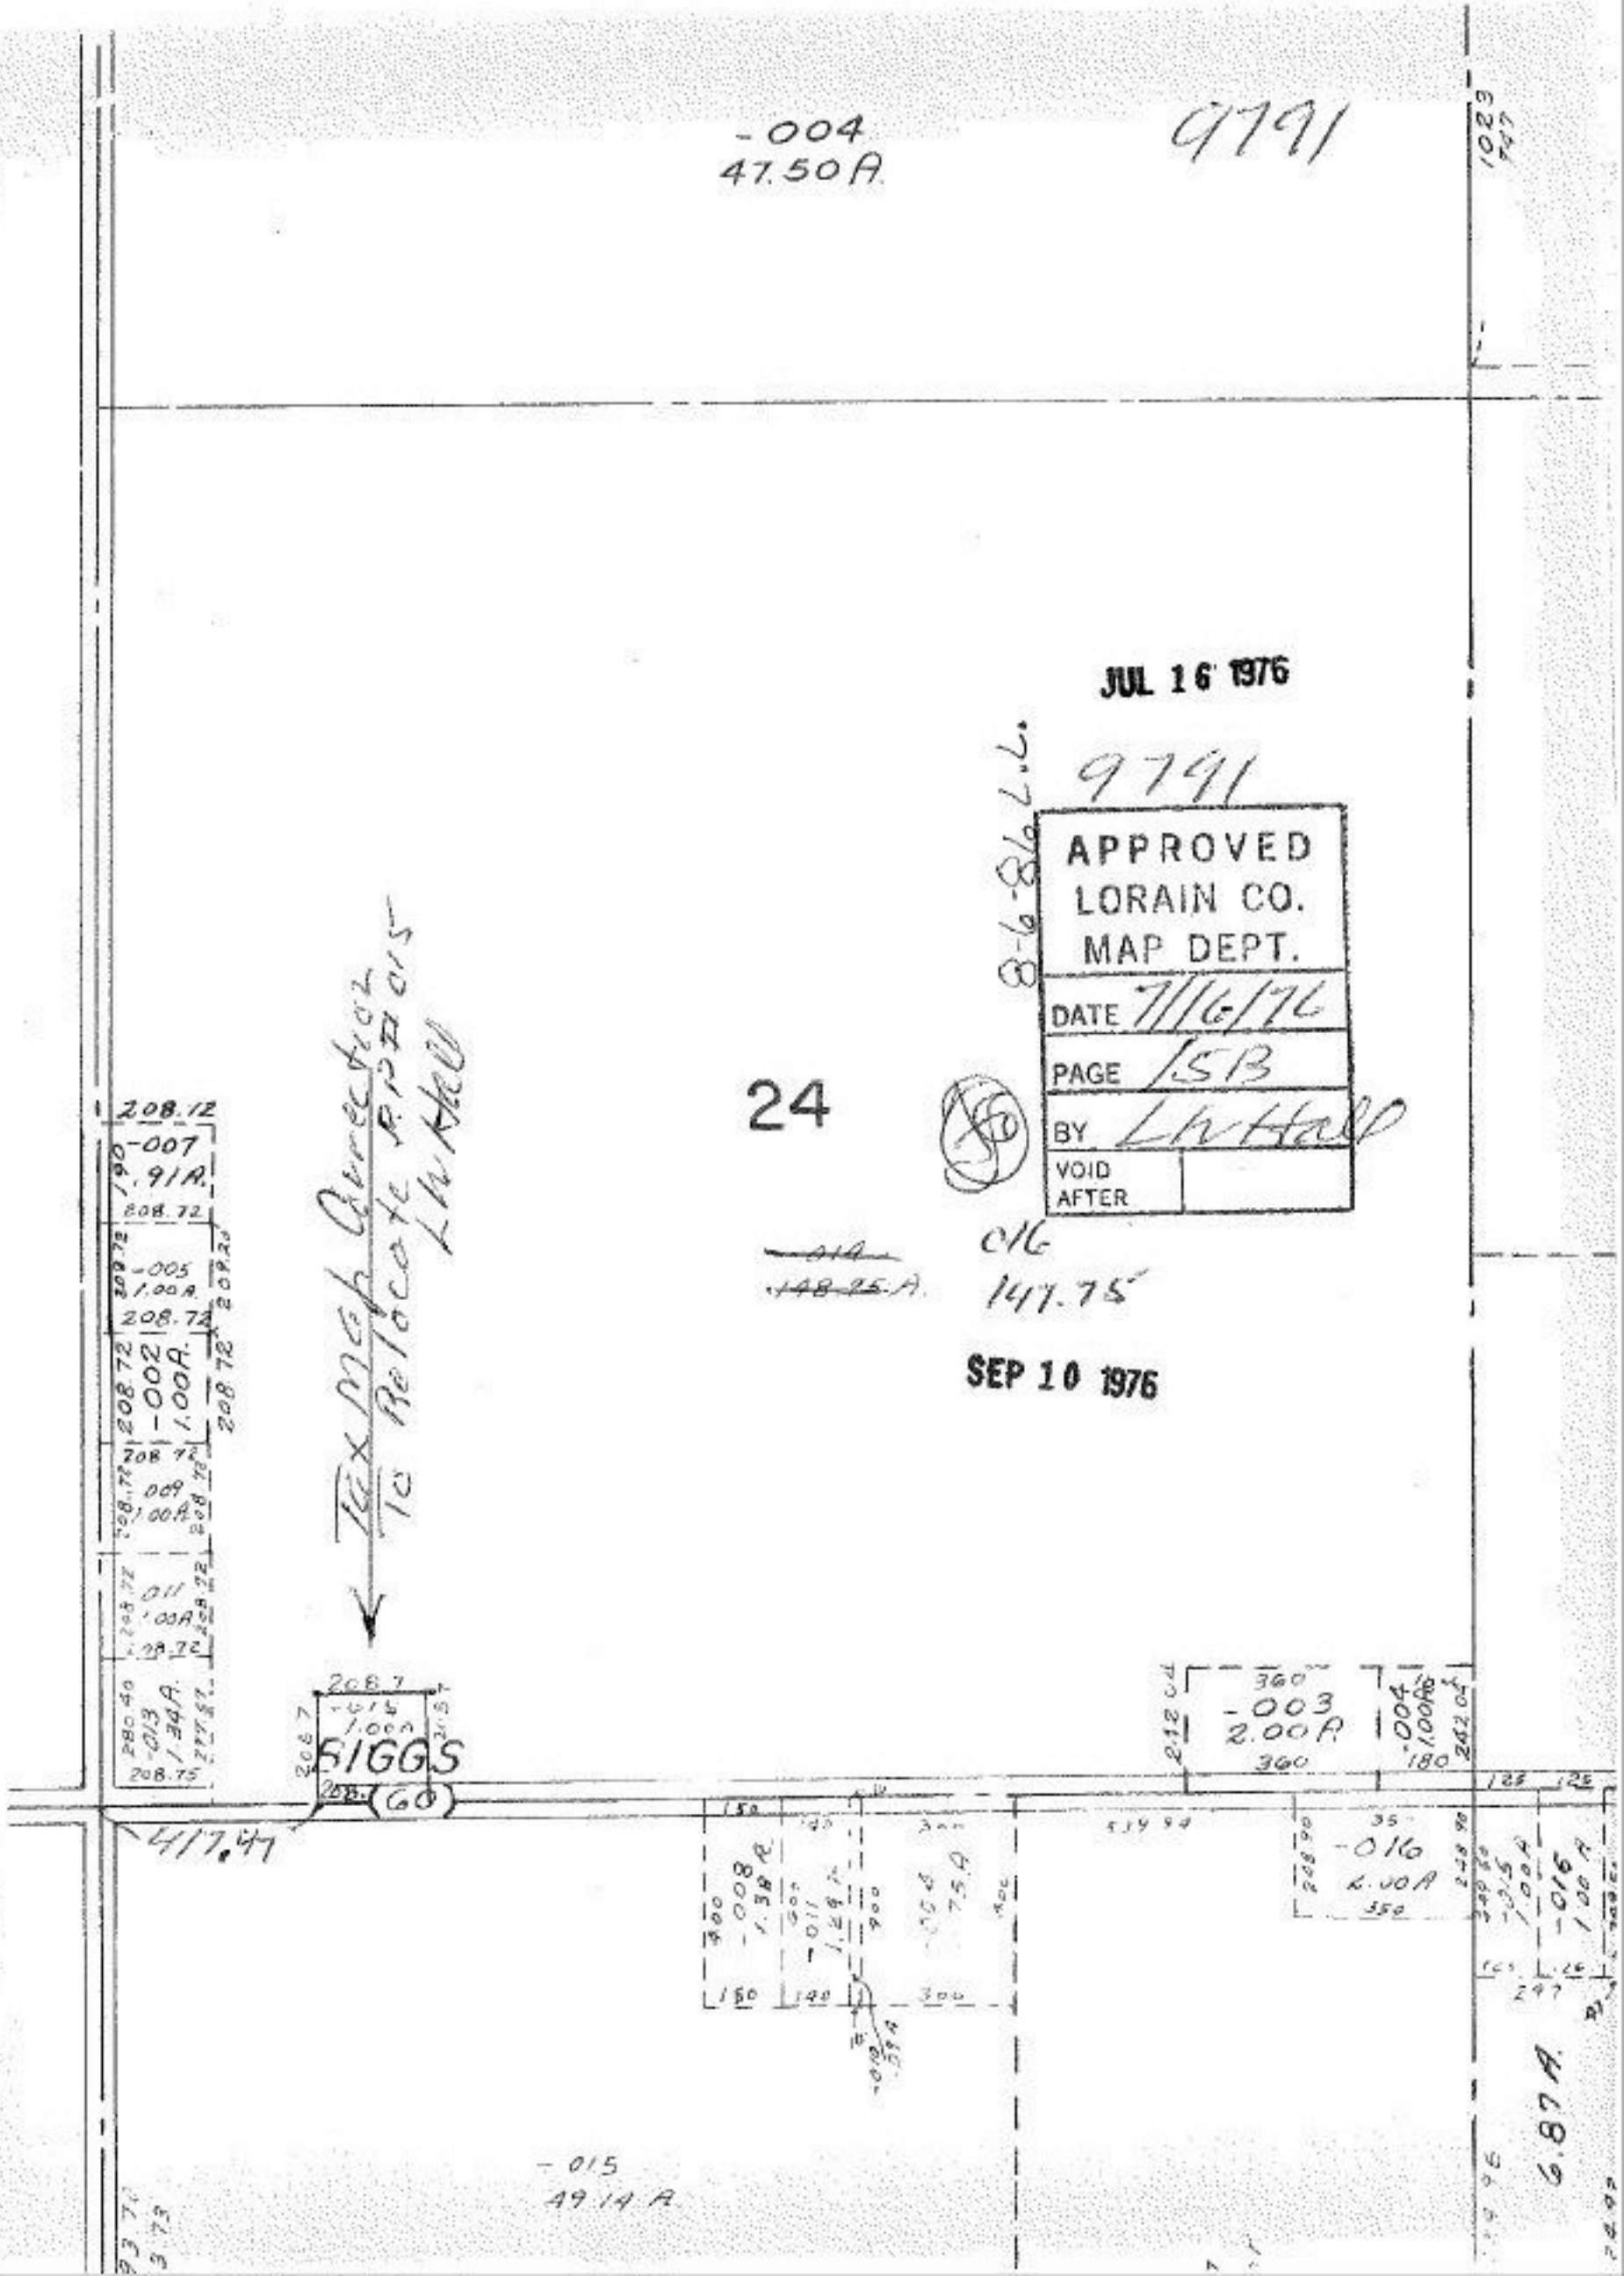

-004
47.50A.
9791
JUL 16 1976
9791
APPROVED
LORAIN CO.
MAP DEPT.
DATE 7/16/76
PAGE 15B
BY LW Hall
VOID AFTER
8-6-86 L.L.
24
-014
148.25 A.
016
147.75
SEP 10 1976
Tax Map Correction
To Relocate P.P. #015
LW Hall
208.12
-007
.91A.
208.72
-005
1.00A.
208.72
-002
1.00A.
208.72
-009
1.00A.
-011
1.00A.
208.72
-013
1.34A.
208.75
208.7
-015
1.00A
FIGGS
60
417.47
360
-003
2.00A
360
-004
1.00A
180
-016
2.00A
350
-008
1.38A.
-011
1.29A.
-015
49.14 A.
6.87 A.