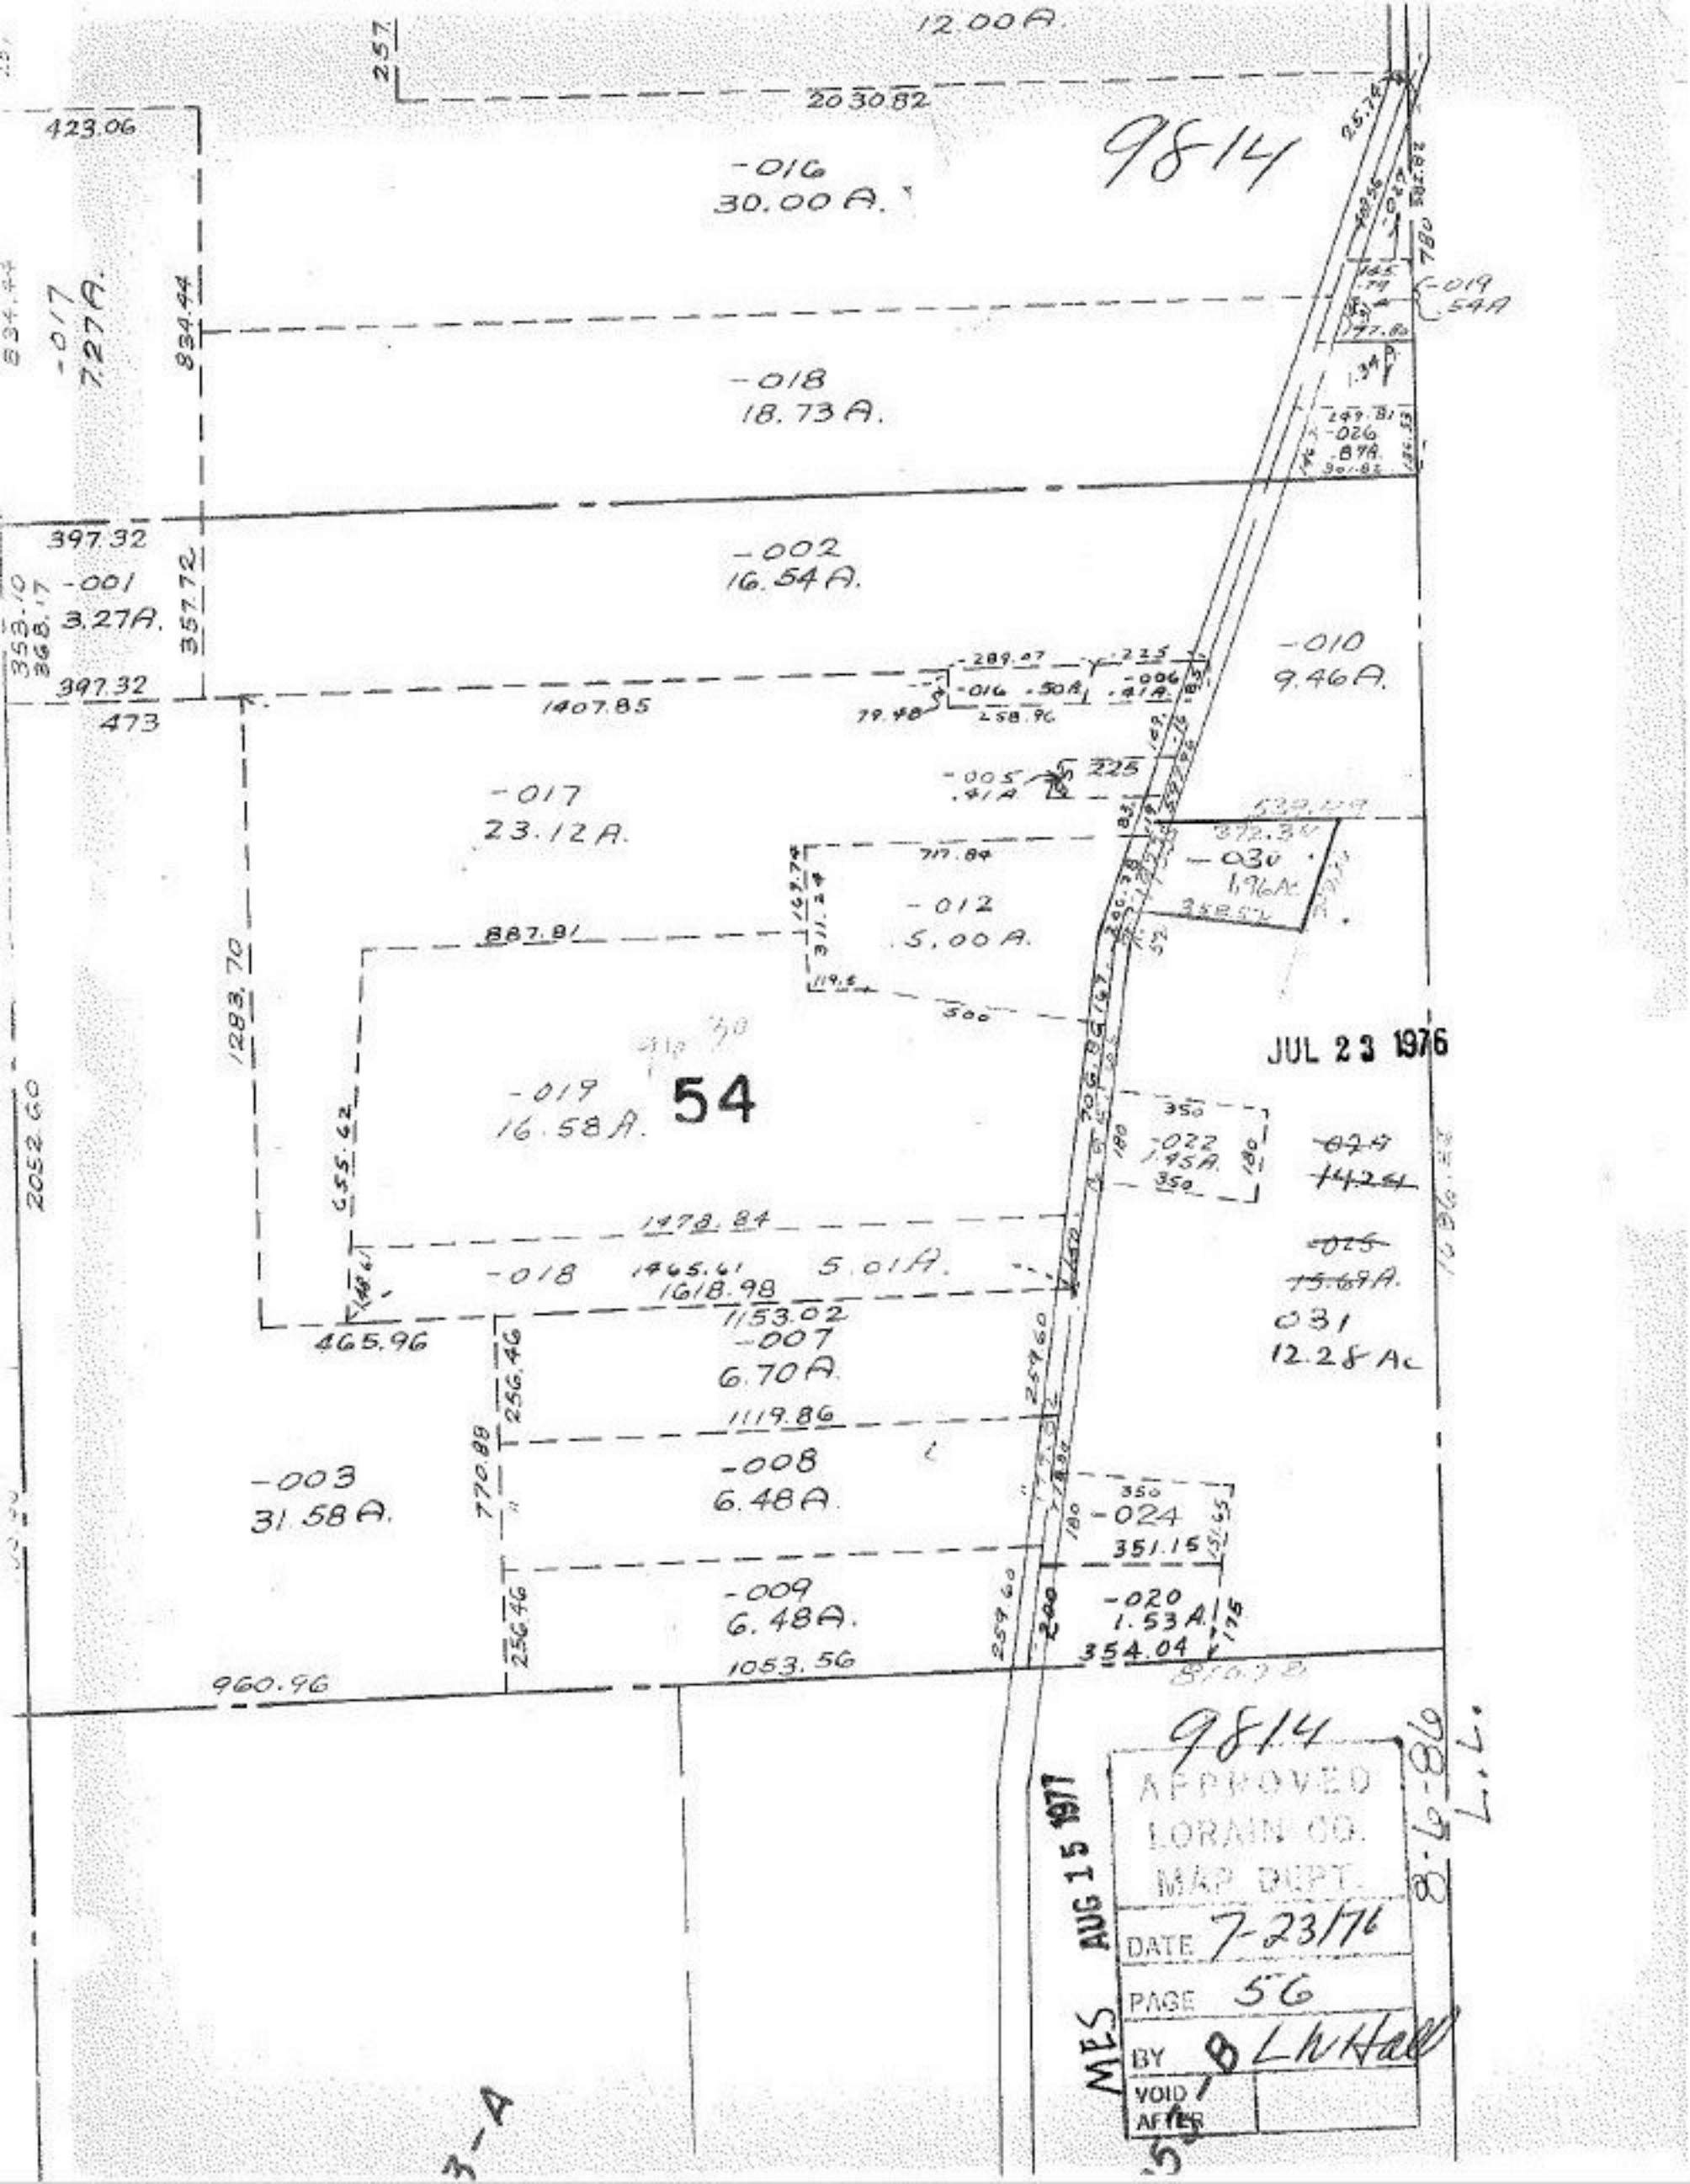

12.00A.
2030.82
9814
423.06
-016
30.00A.
-017
7.27A.
834.44
-018
18.73A.
-019
.54A
397.32
-001
3.27A.
357.72
-002
16.54A.
-010
9.46A.
397.32
473
1407.85
-017
23.12A.
-005
.41A
225
-030
1.96Ac
717.84
-012
5.00A.
887.81
1283.70
-019
16.58A.
54
JUL 23 1976
-022
1.45A.
-024
1424
-025
15.69A.
031
12.28 Ac
2052.60
655.62
1478.84
-018
1465.61
5.01A.
1618.98
1153.02
-007
6.70A.
465.96
256.46
1119.86
-003
31.58A.
770.88
-008
6.48A.
-024
351.15
-009
6.48A.
-020
1.53A.
354.04
1053.56
960.96
9814
APPROVED
LORAIN CO.
MAP DEPT.
DATE 7-23/76
PAGE 56
BY LWHall
VOID AFTER
MES AUG 15 1977
8-6-86
L.L.