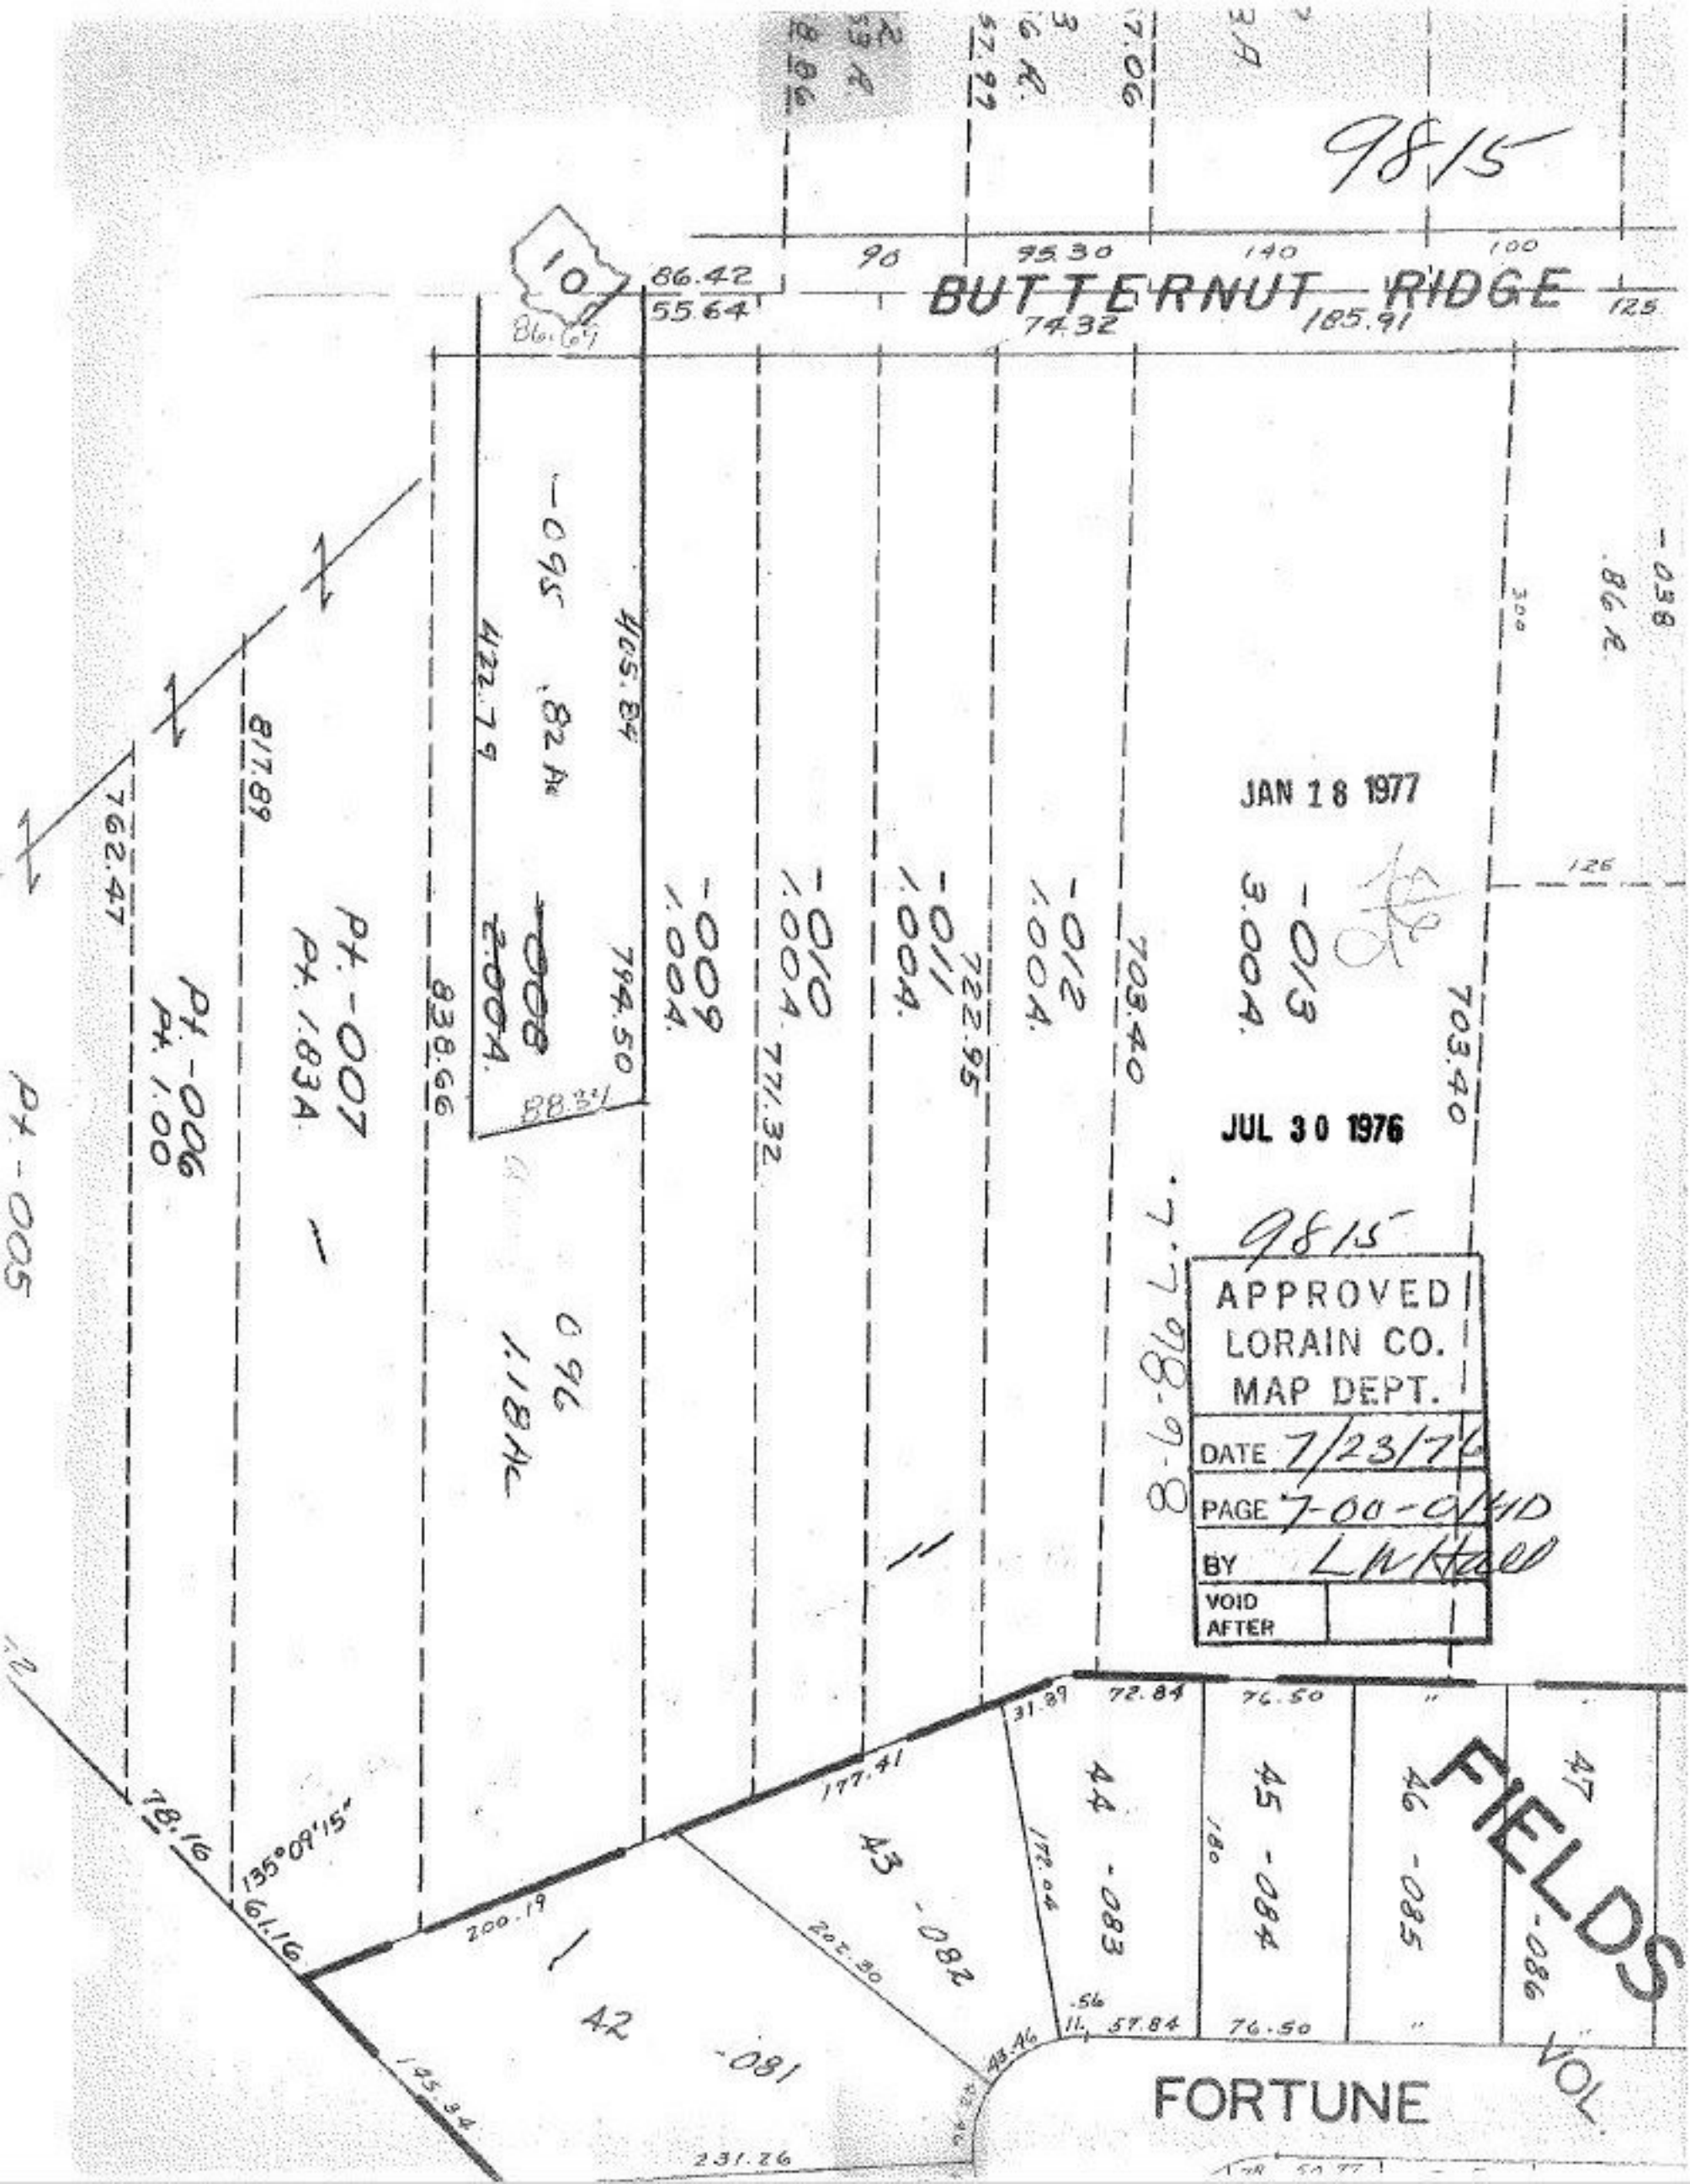
9815
BUTTERNUT RIDGE
10
86.42
55.64
90
95.30
140
100
74.32
185.91
125
JAN 18 1977
JUL 30 1976
-013
3.00A.
-012
1.00A.
-011
1.00A.
-010
1.00A.
-009
1.00A.
-095
.82 Ac
422.79
405.84
794.50
838.66
88.34
-008
2.00A.
-007
Pt. 1.83A.
Pt. -006
Pt. 1.00
Pt. -005
762.47
817.89
096
1.18Ac
-038
.86 R.
703.40
703.40
722.95
771.32
8-6-86 L.L.
9815
APPROVED
LORAIN CO.
MAP DEPT.
DATE 7/23/76
PAGE 7-00-014D
BY LWHall
VOID
AFTER
FIELDS
VOL.
FORTUNE
72.84
76.50
31.89
177.41
200.19
202.30
145.34
231.26
78.16
61.16
135°09'15"
42
-081
43
-082
44
-083
45
-084
46
-085
47
-086
57.84
76.50
43.46