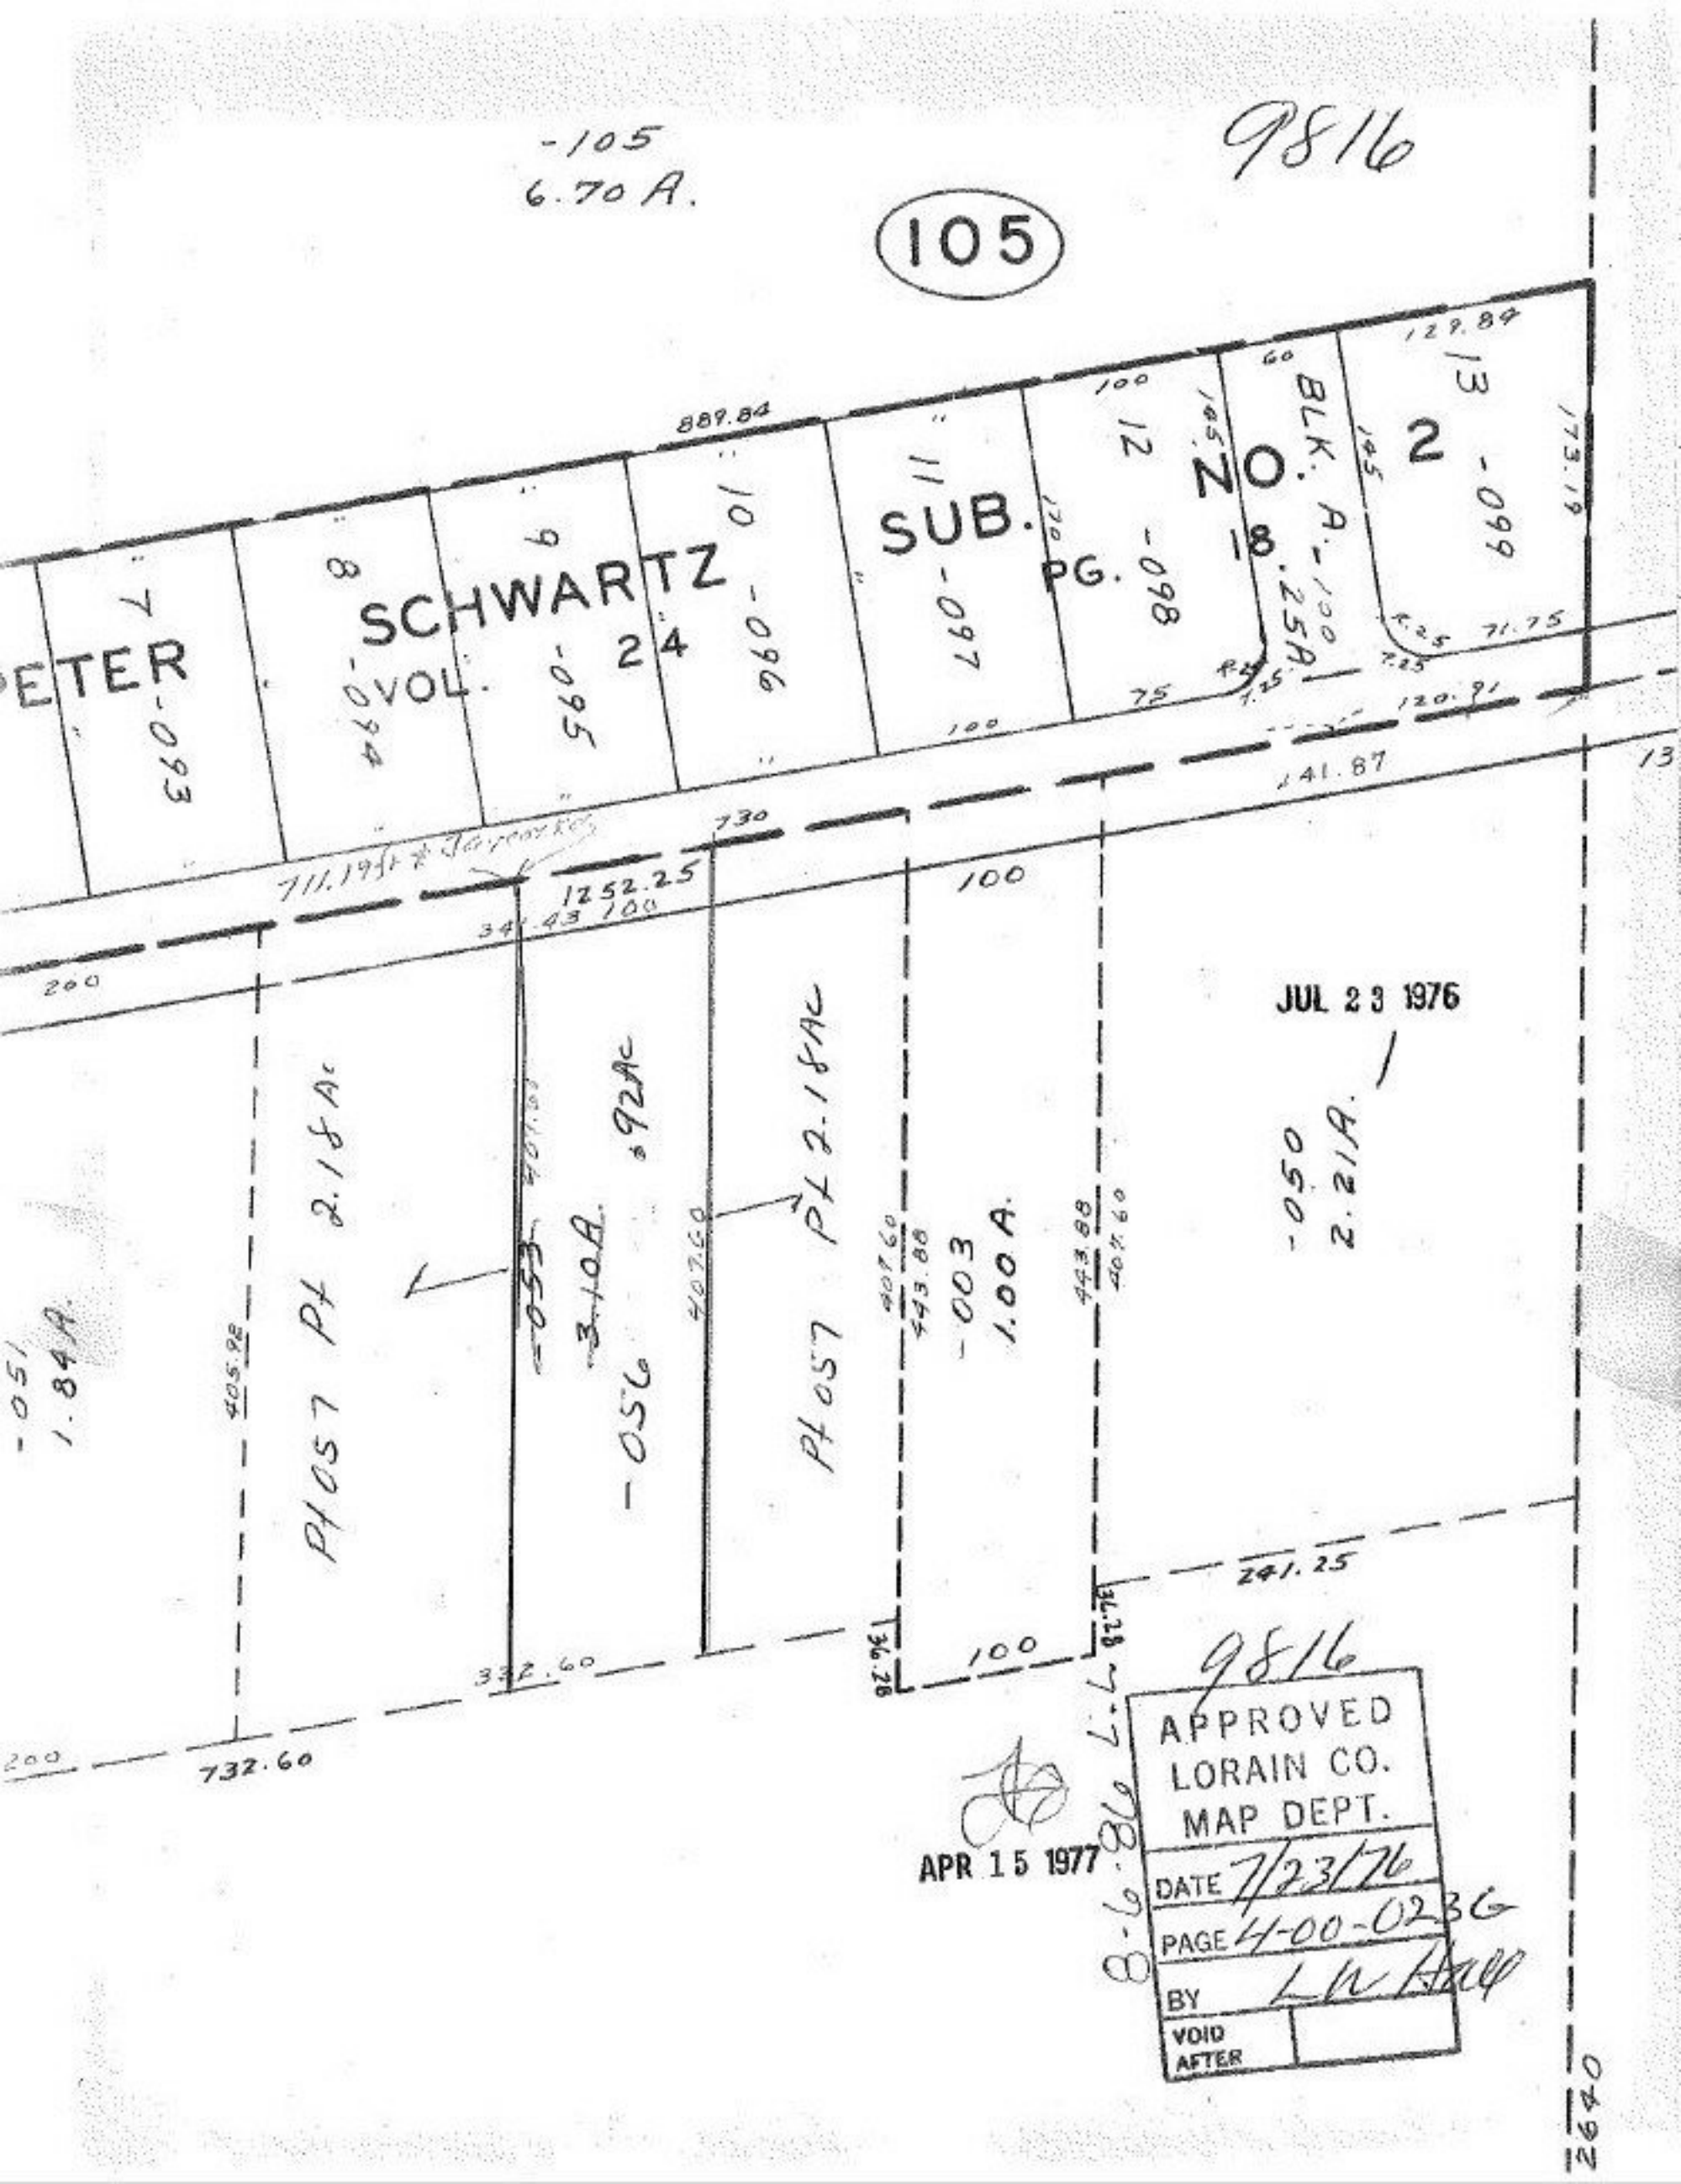

-105
6.70 A.
9816
105
PETER
SCHWARTZ
VOL. 24
SUB. NO. 2
PG. 18
BLK. A.
-093
-094
-095
-096
-097
-098
-099
-100
-25A
-051
1.84 A.
Pt 057 Pt 2.18 Ac
-053
3.10 A.
-056
.92 Ac
Pt 057 Pt 2.18 Ac
-003
1.00 A.
-050
2.21 A.
889.84
129.84
173.19
71.75
120.91
241.87
241.25
732.60
332.60
1252.25
JUL 23 1976
APR 15 1977
9816
APPROVED
LORAIN CO.
MAP DEPT.
DATE 7/23/76
PAGE 4-00-023G
BY L.W. Hall
VOID AFTER
8-6-86 L.L.
2640