


5-00-019-4

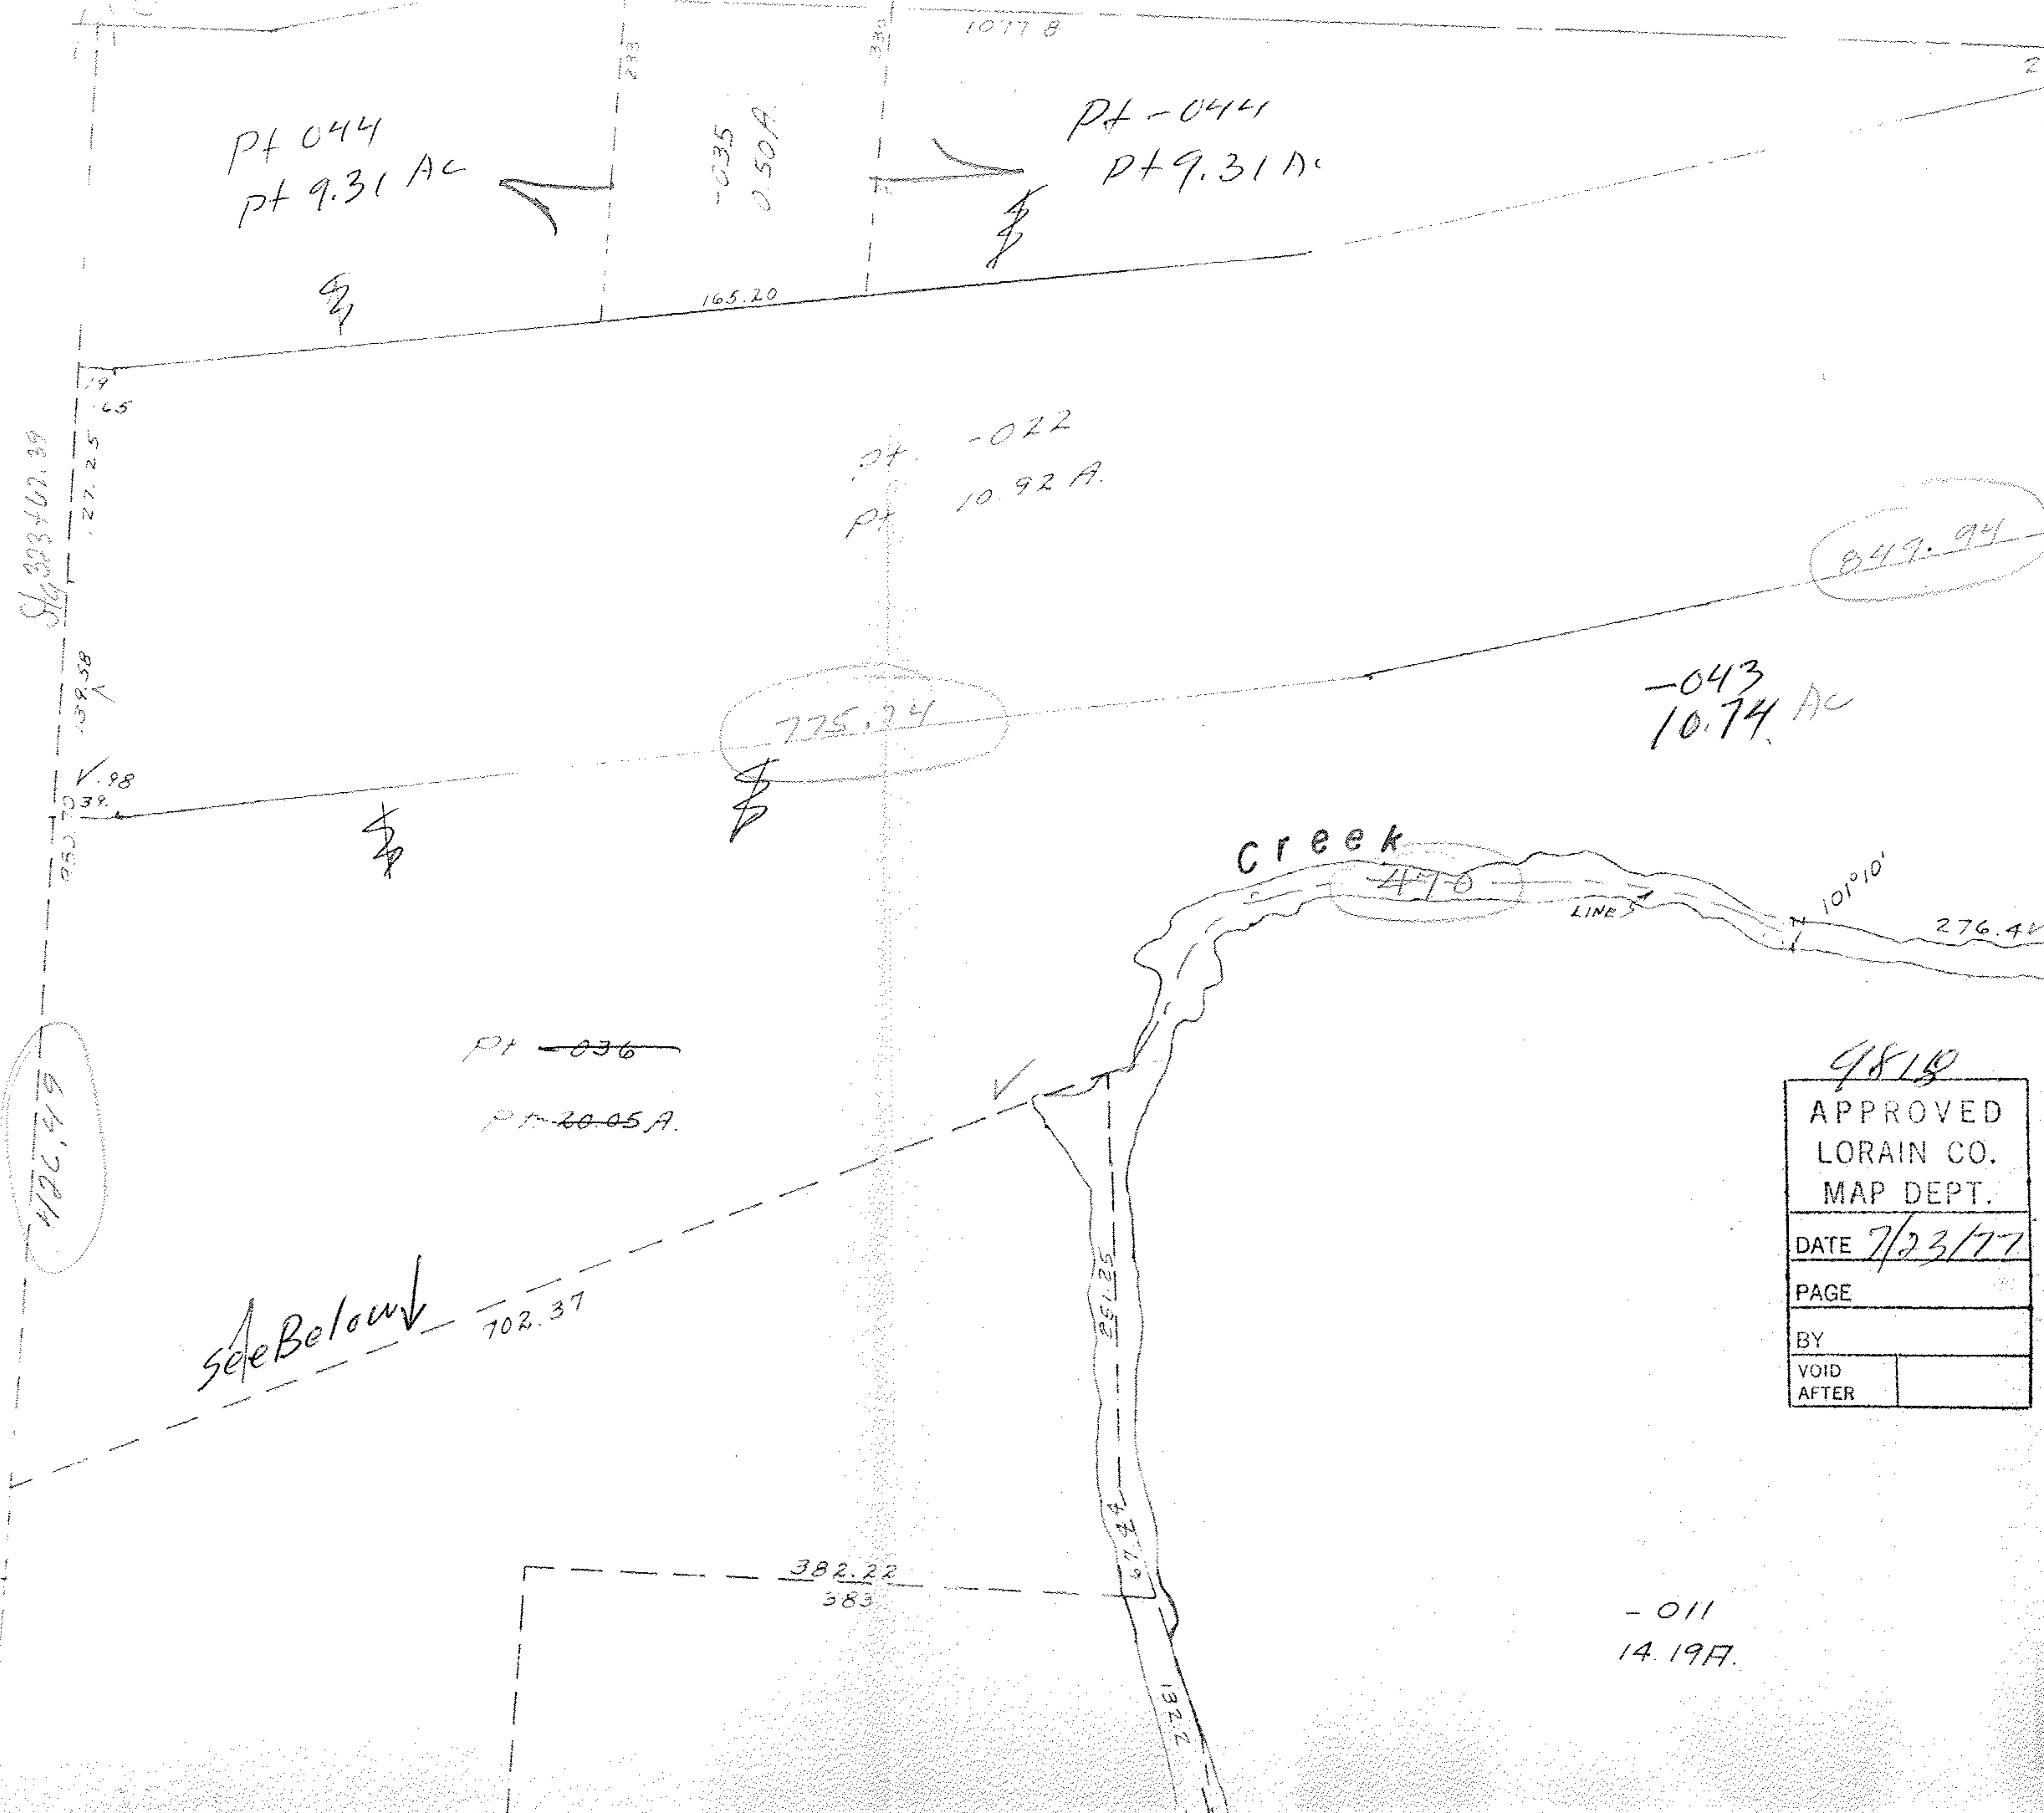

Sy 323+62.39

.85

.65

.21.25

.19

.18

.15

.139.58

































