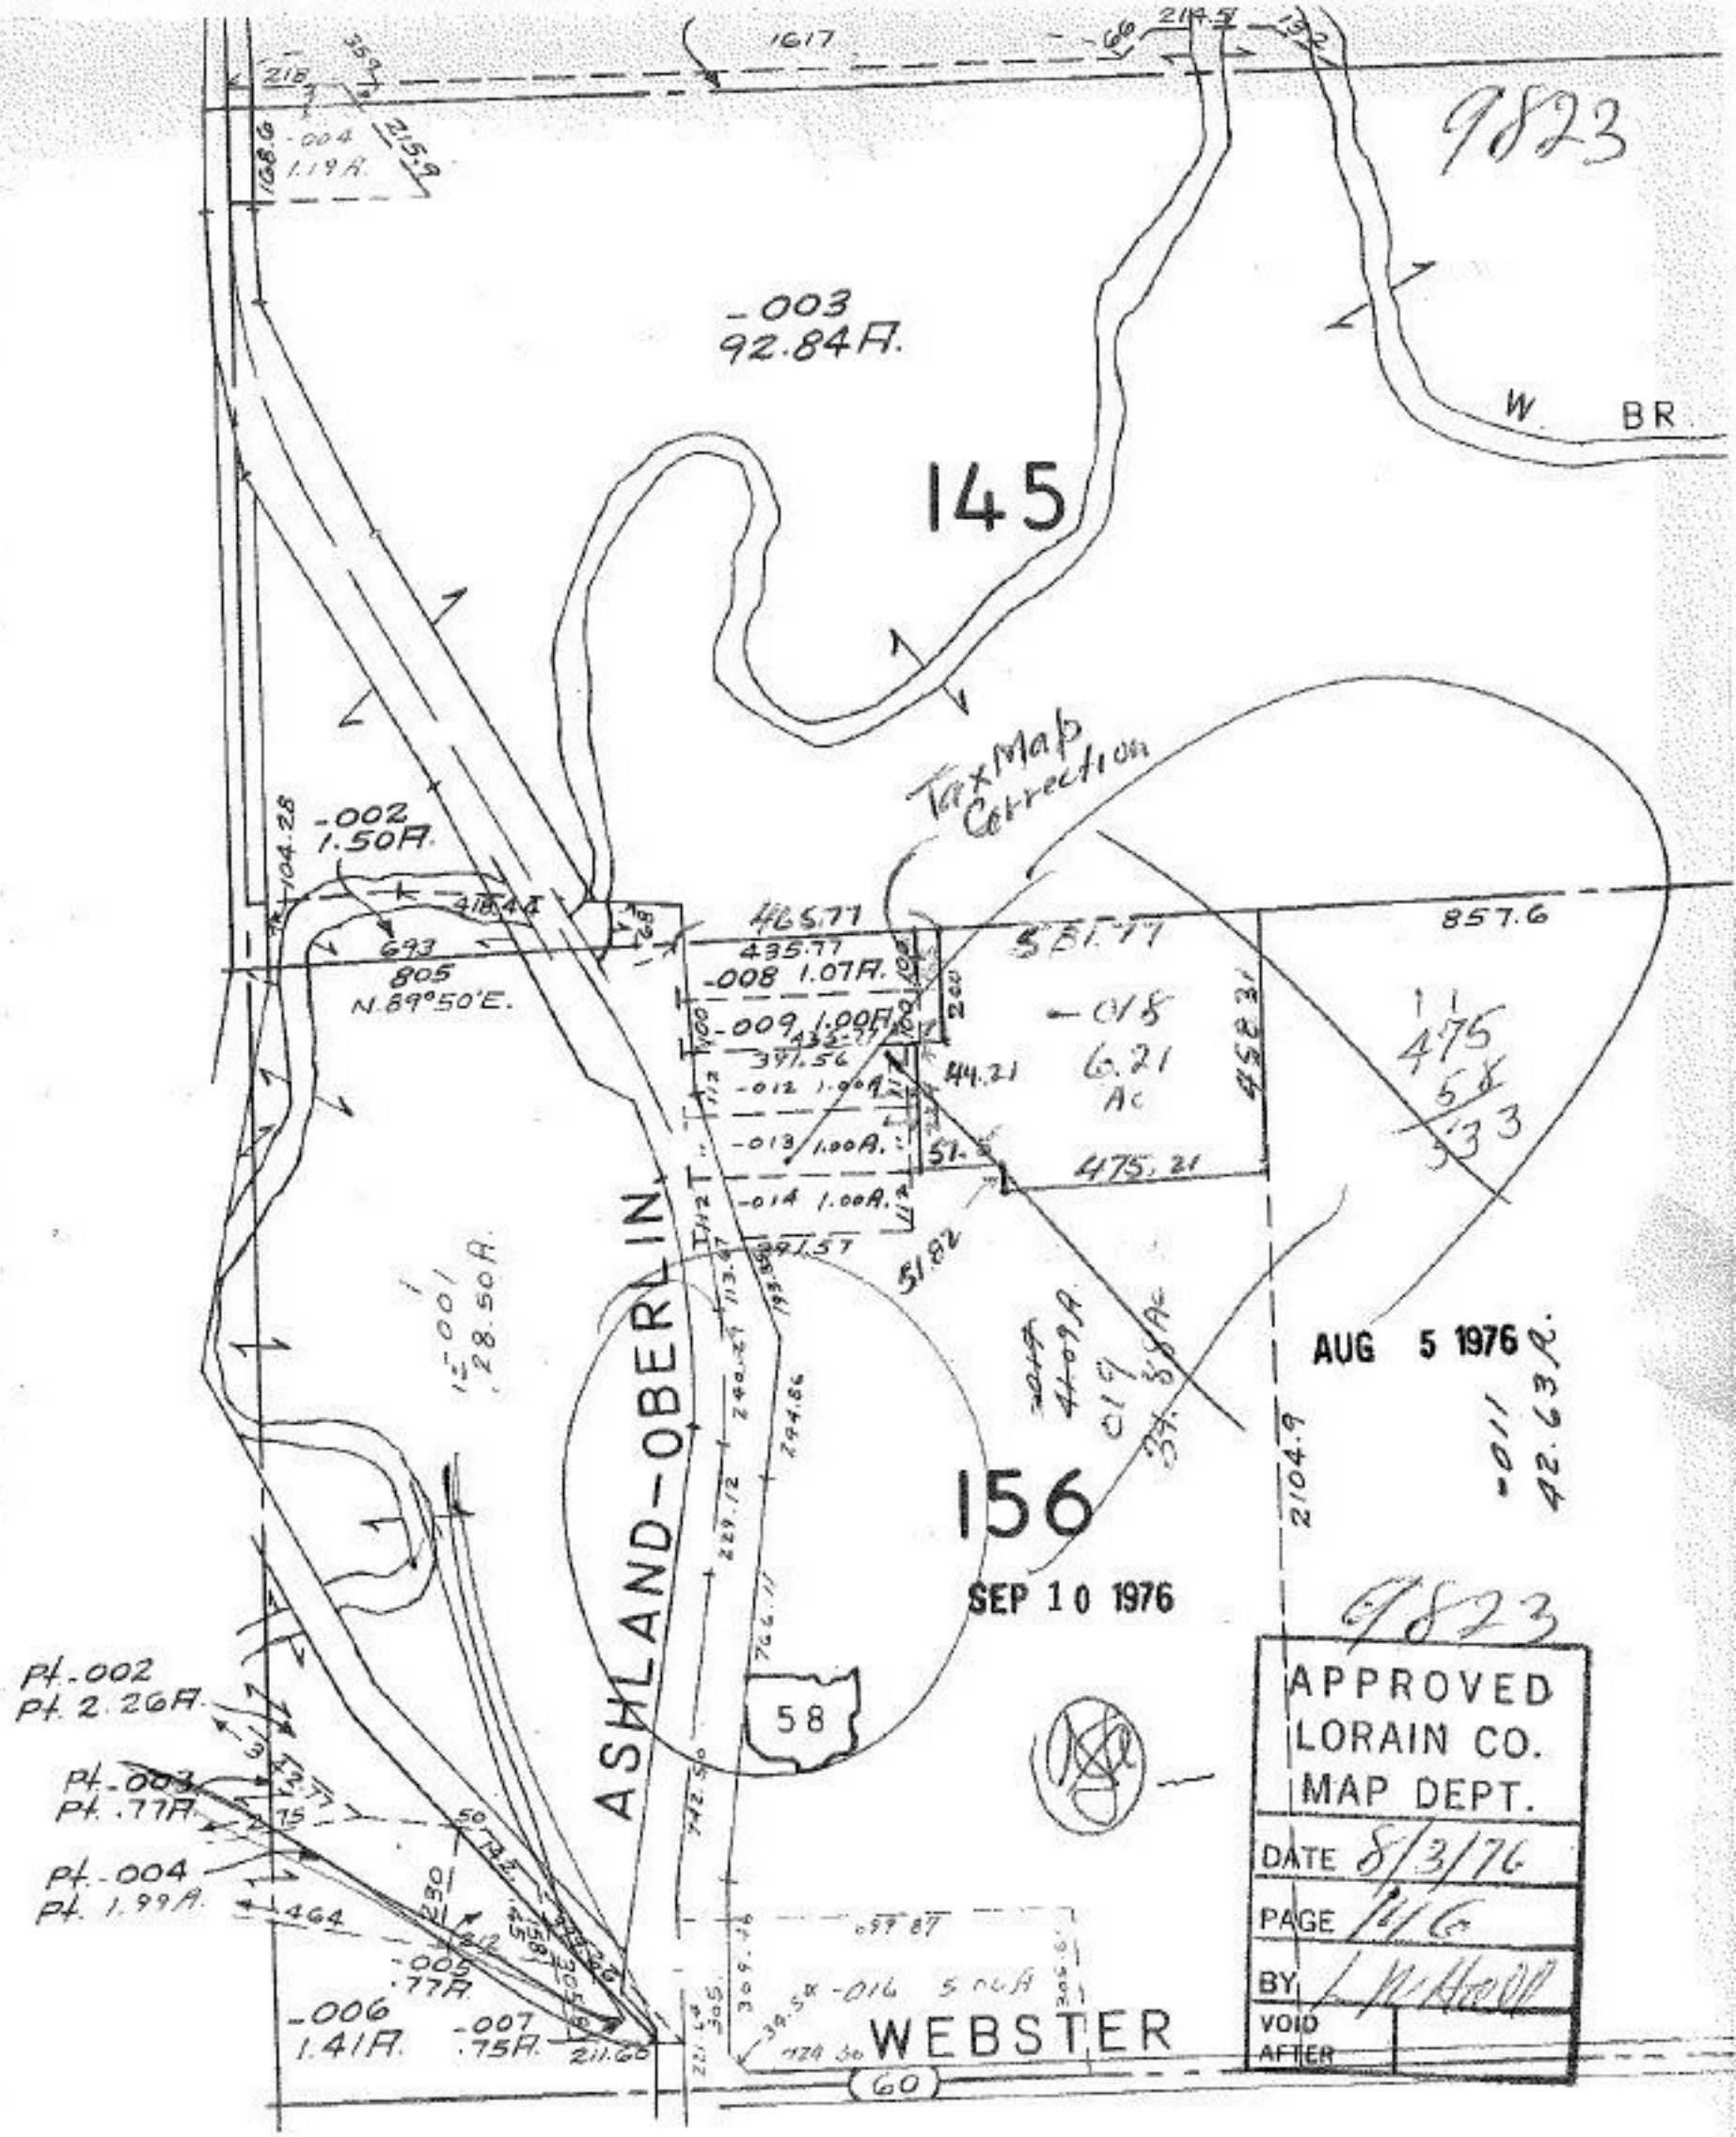

Copyright 1963

PITTSFIELD TWP.

14-G

SCALE 1" = 400'