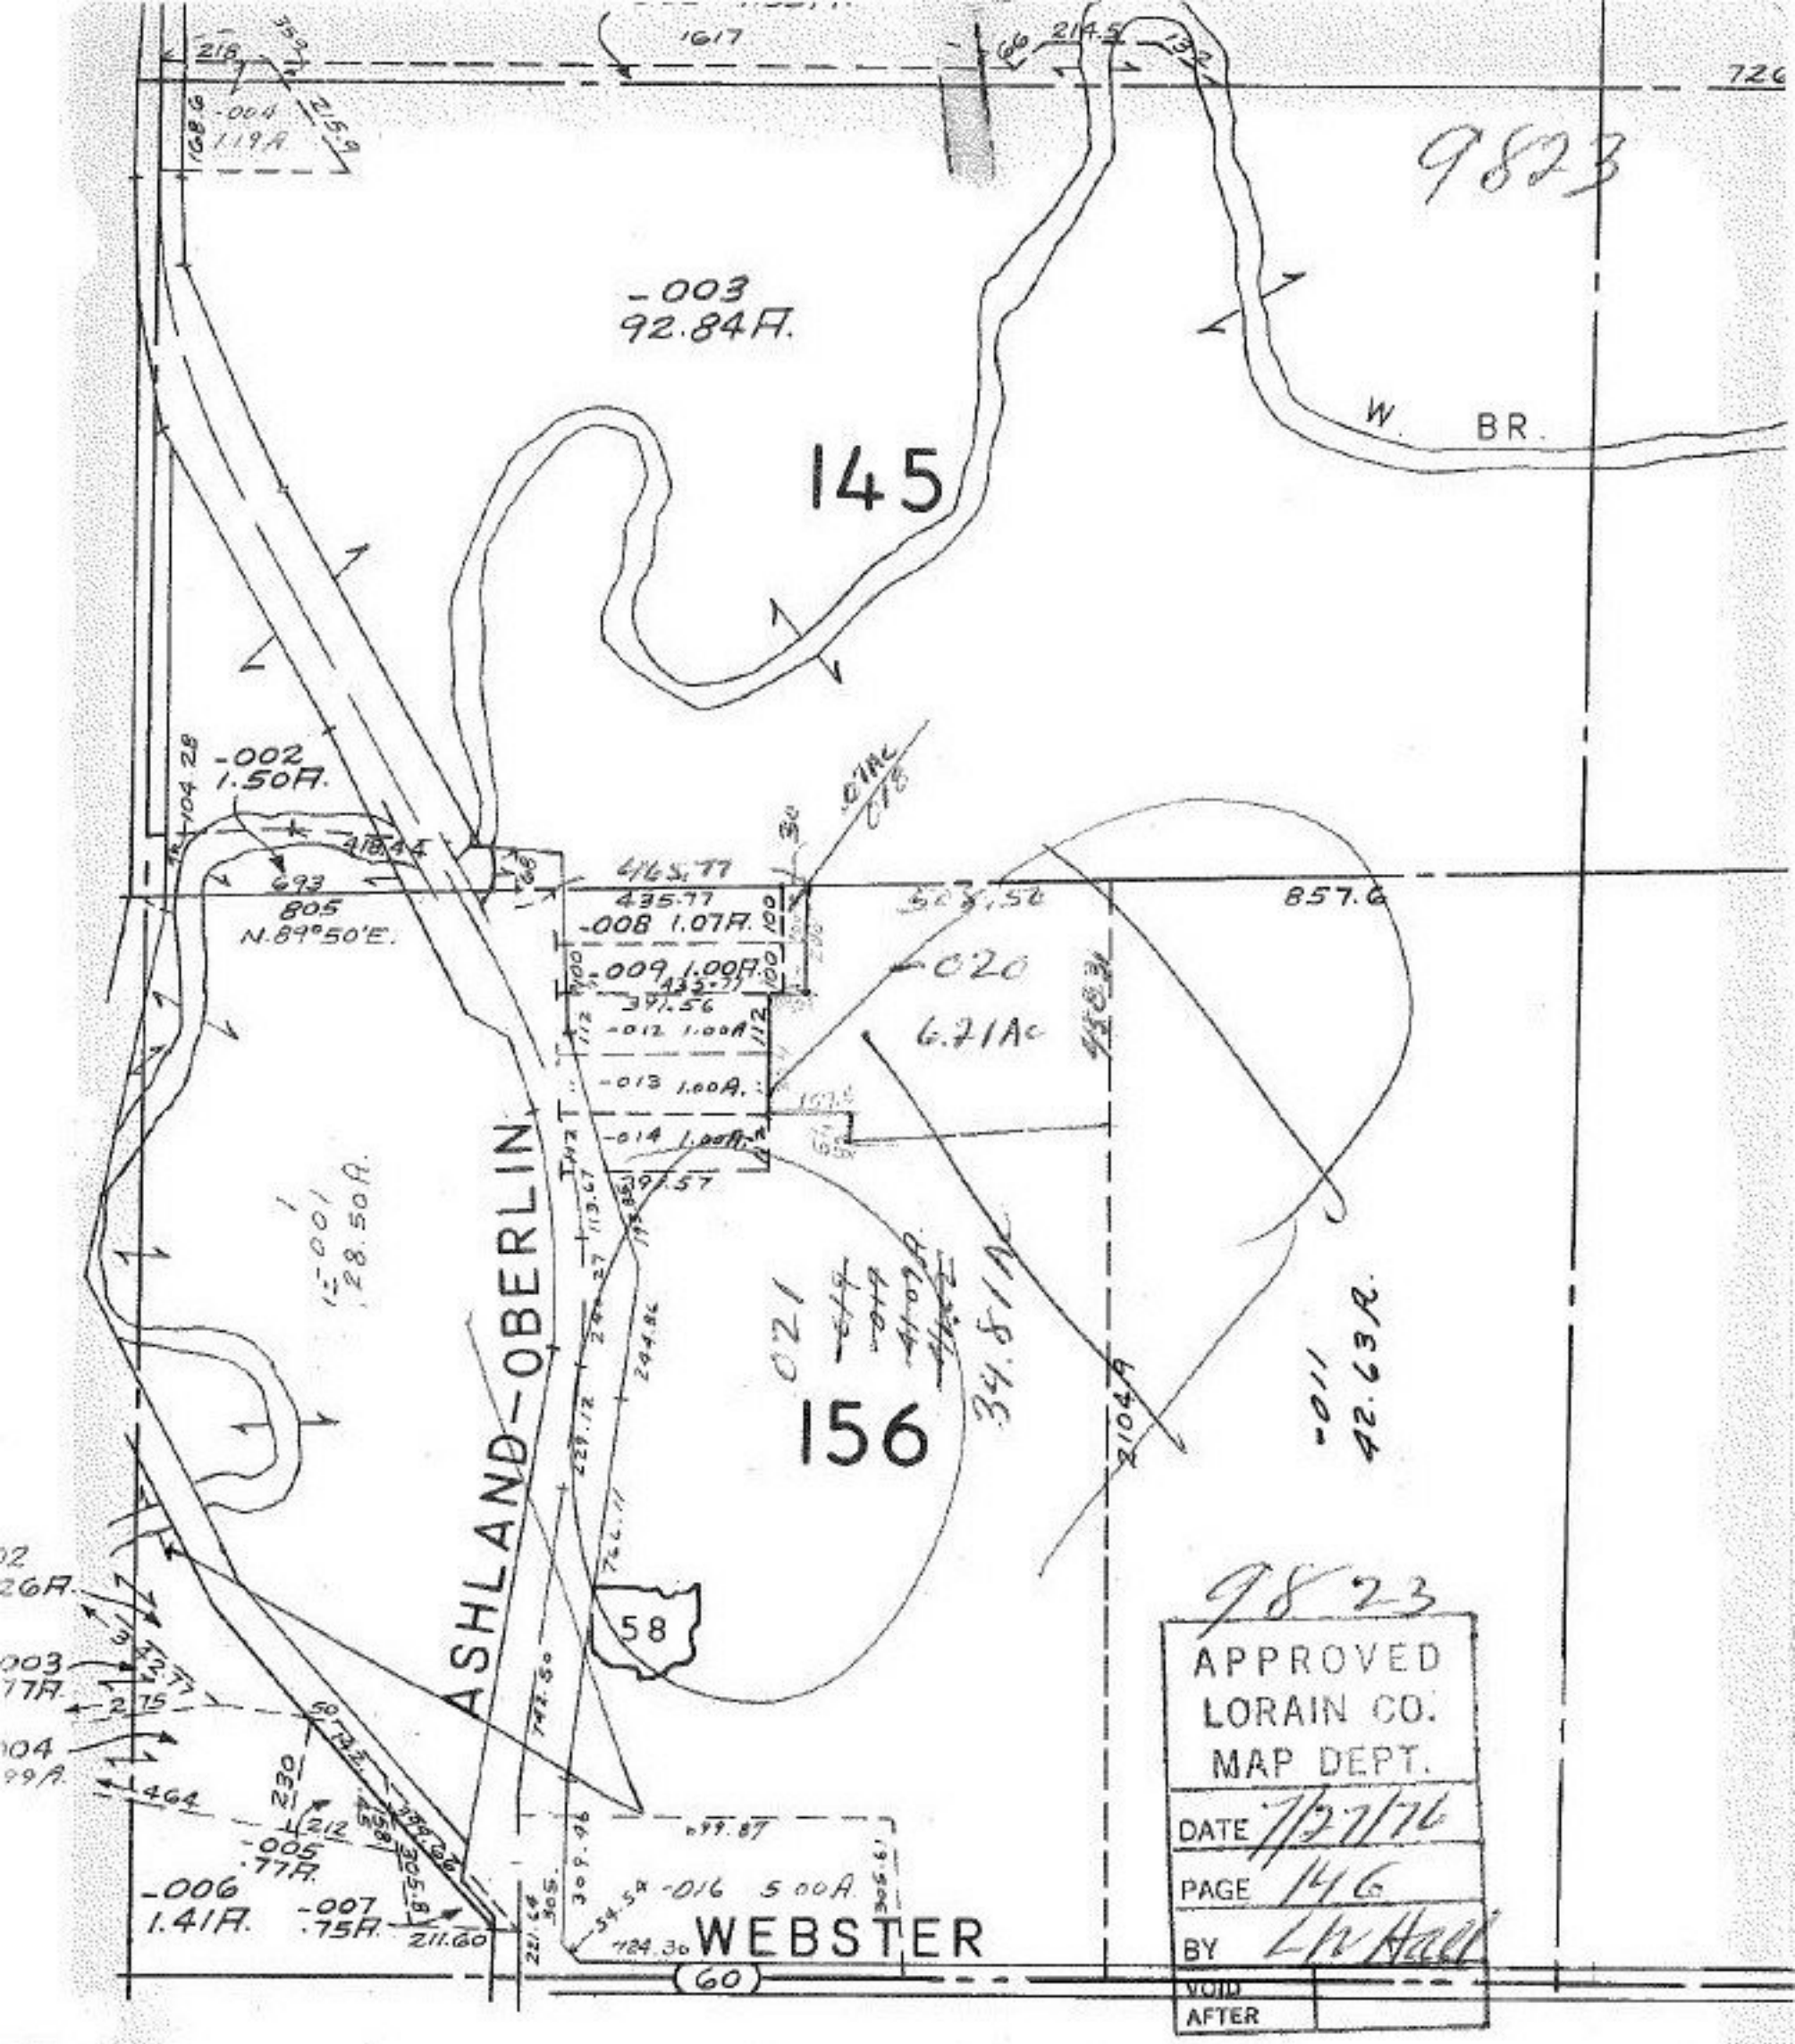

963

PITTSFIELD TWP.

SCALE 1" = 400'