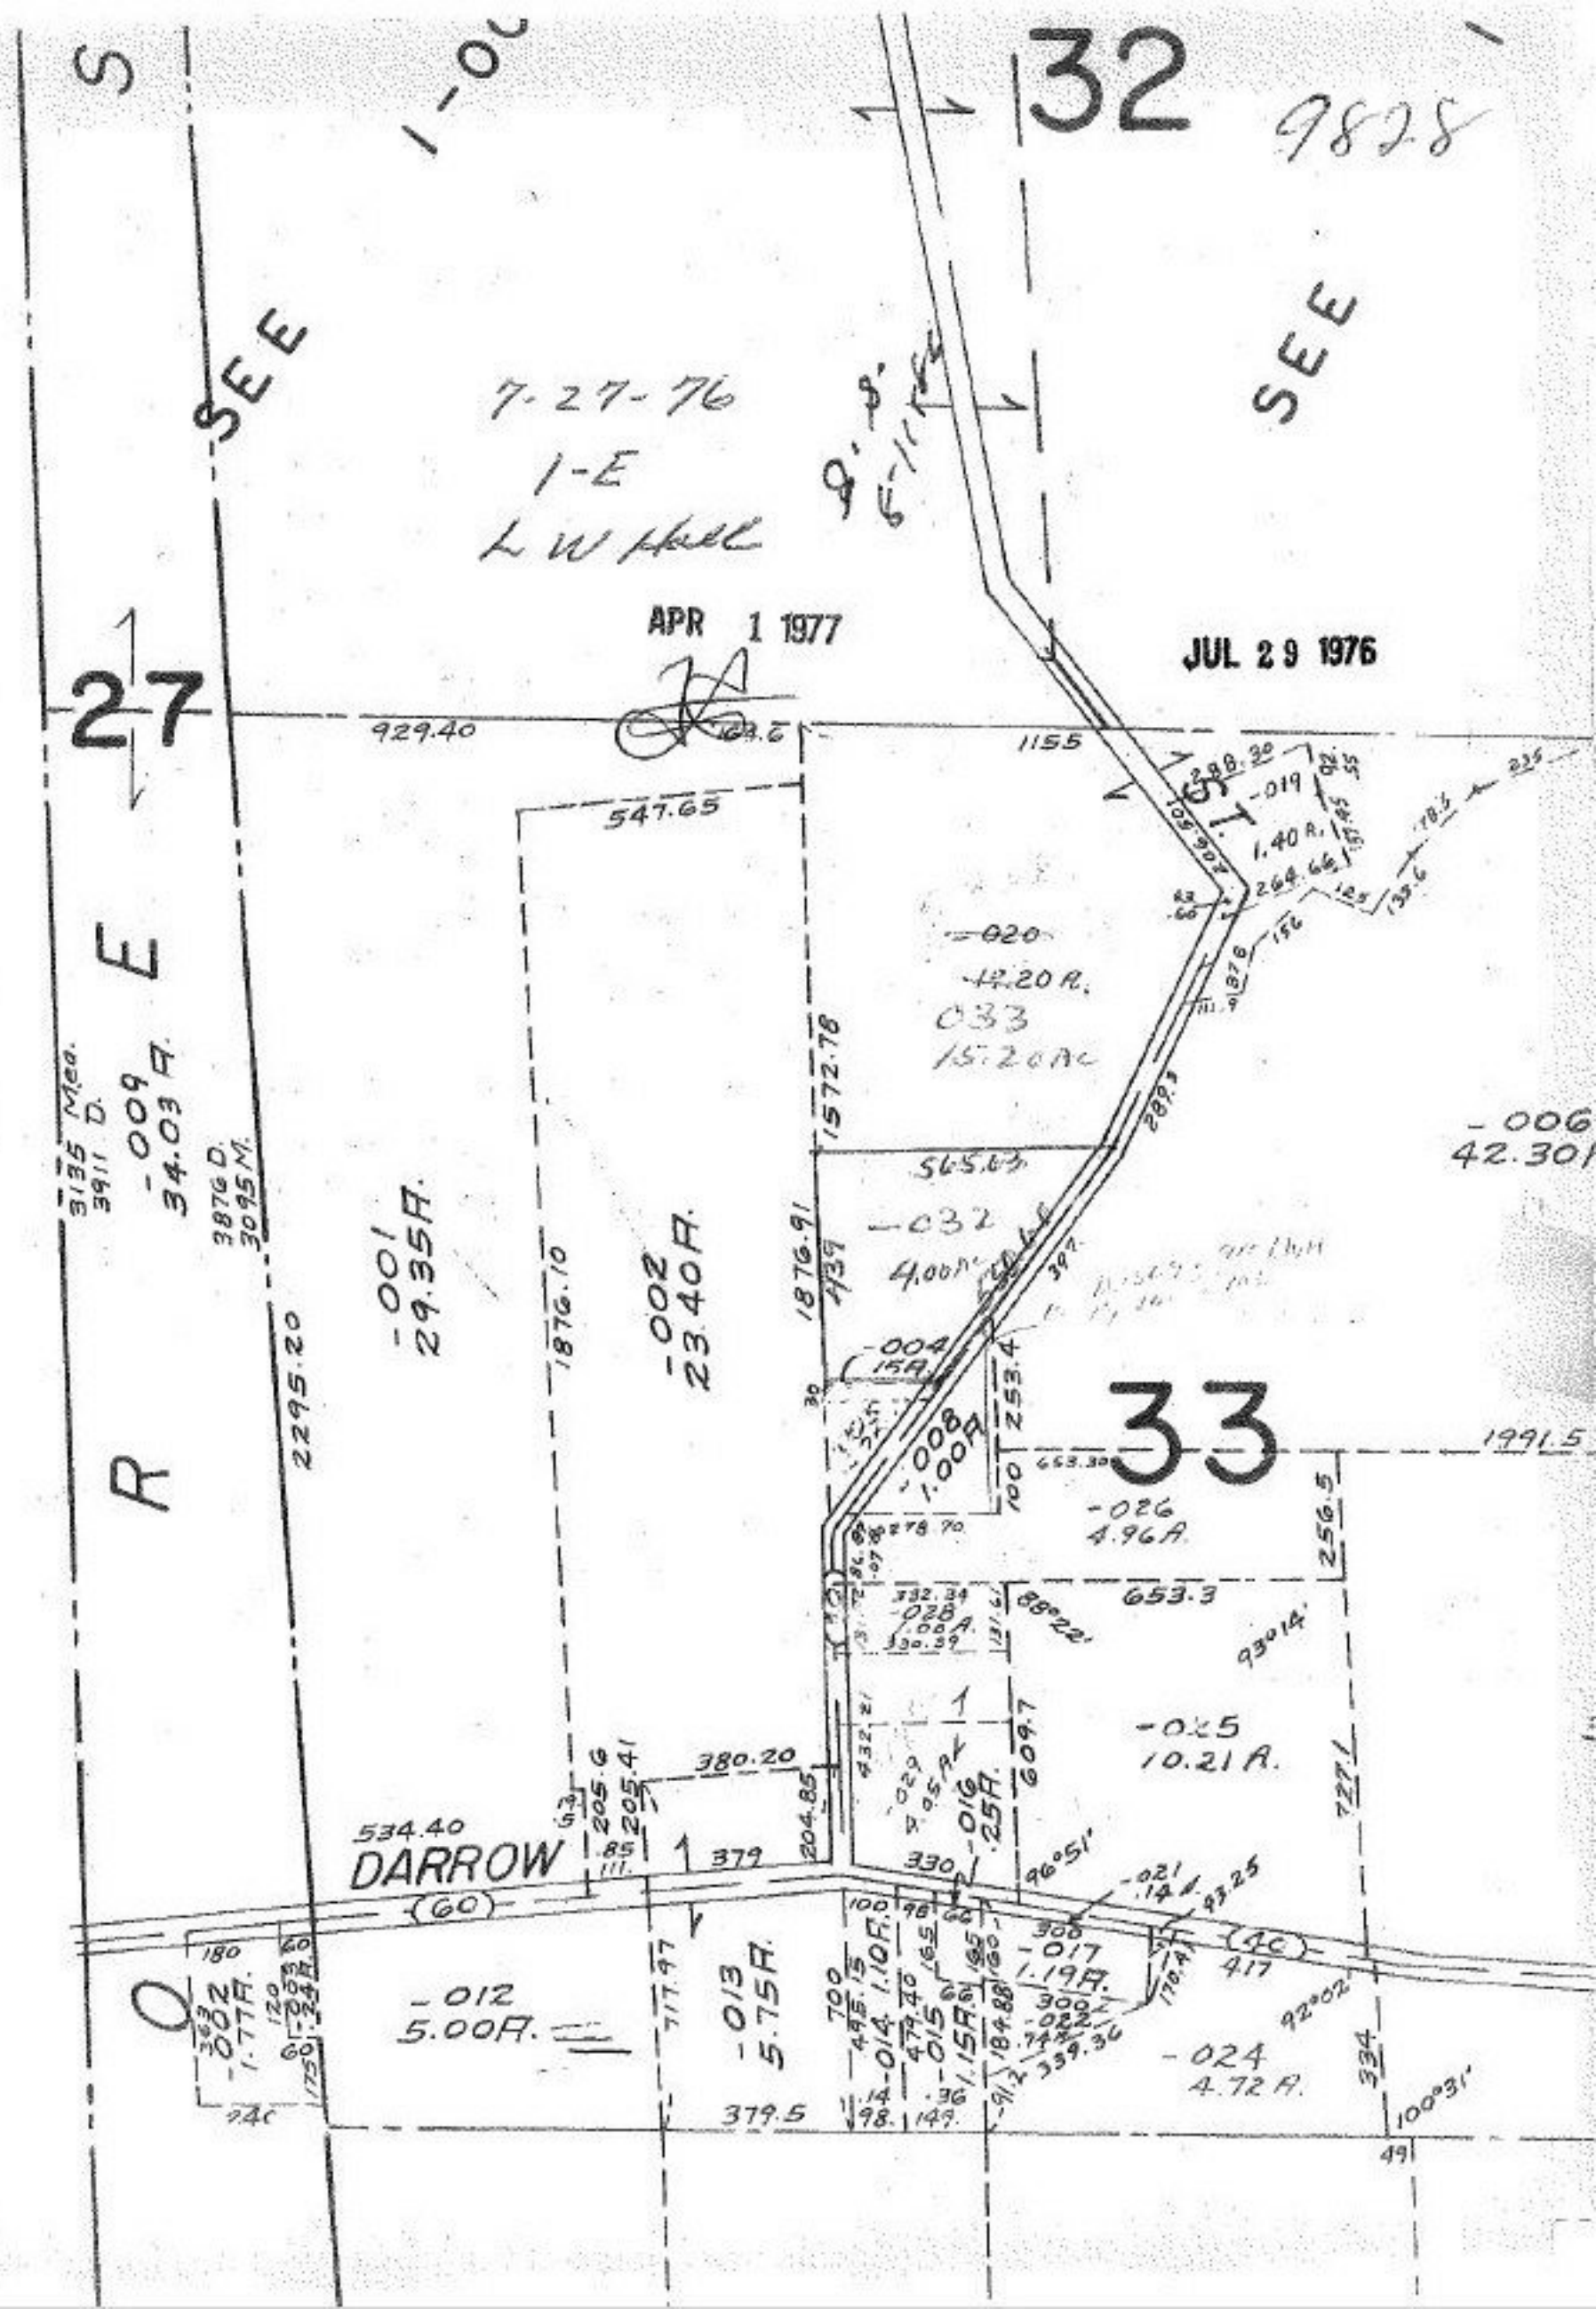

32
9828
SEE
SEE
7-27-76
1-E
L W Hall
APR 1 1977
JUL 29 1976
27
929.40
1155
547.65
-019
1.40 A.
264.66
-020
12.20 A.
033
15.20 AC
1572.78
565.63
-006
42.30
-032
4.00 AC
-004
15 A.
-008
1.00 A.
253.4
33
1991.5
-026
4.96 A.
256.5
653.3
-028
1.00 A.
-025
10.21 A.
609.7
727.1
380.20
534.40
DARROW
(60)
379
330
-016
.25 A.
-017
1.19 A.
-012
5.00 A.
-013
5.75 A.
-014
1.10 A.
-015
1.15 A.
-024
4.72 A.
-002
1.77 A.
-009
34.03 A.
3135 Mea.
3911 D.
3876 D.
3095 M.
-001
29.35 A.
-002
23.40 A.
1876.10
1876.91
2295.20
R
Q