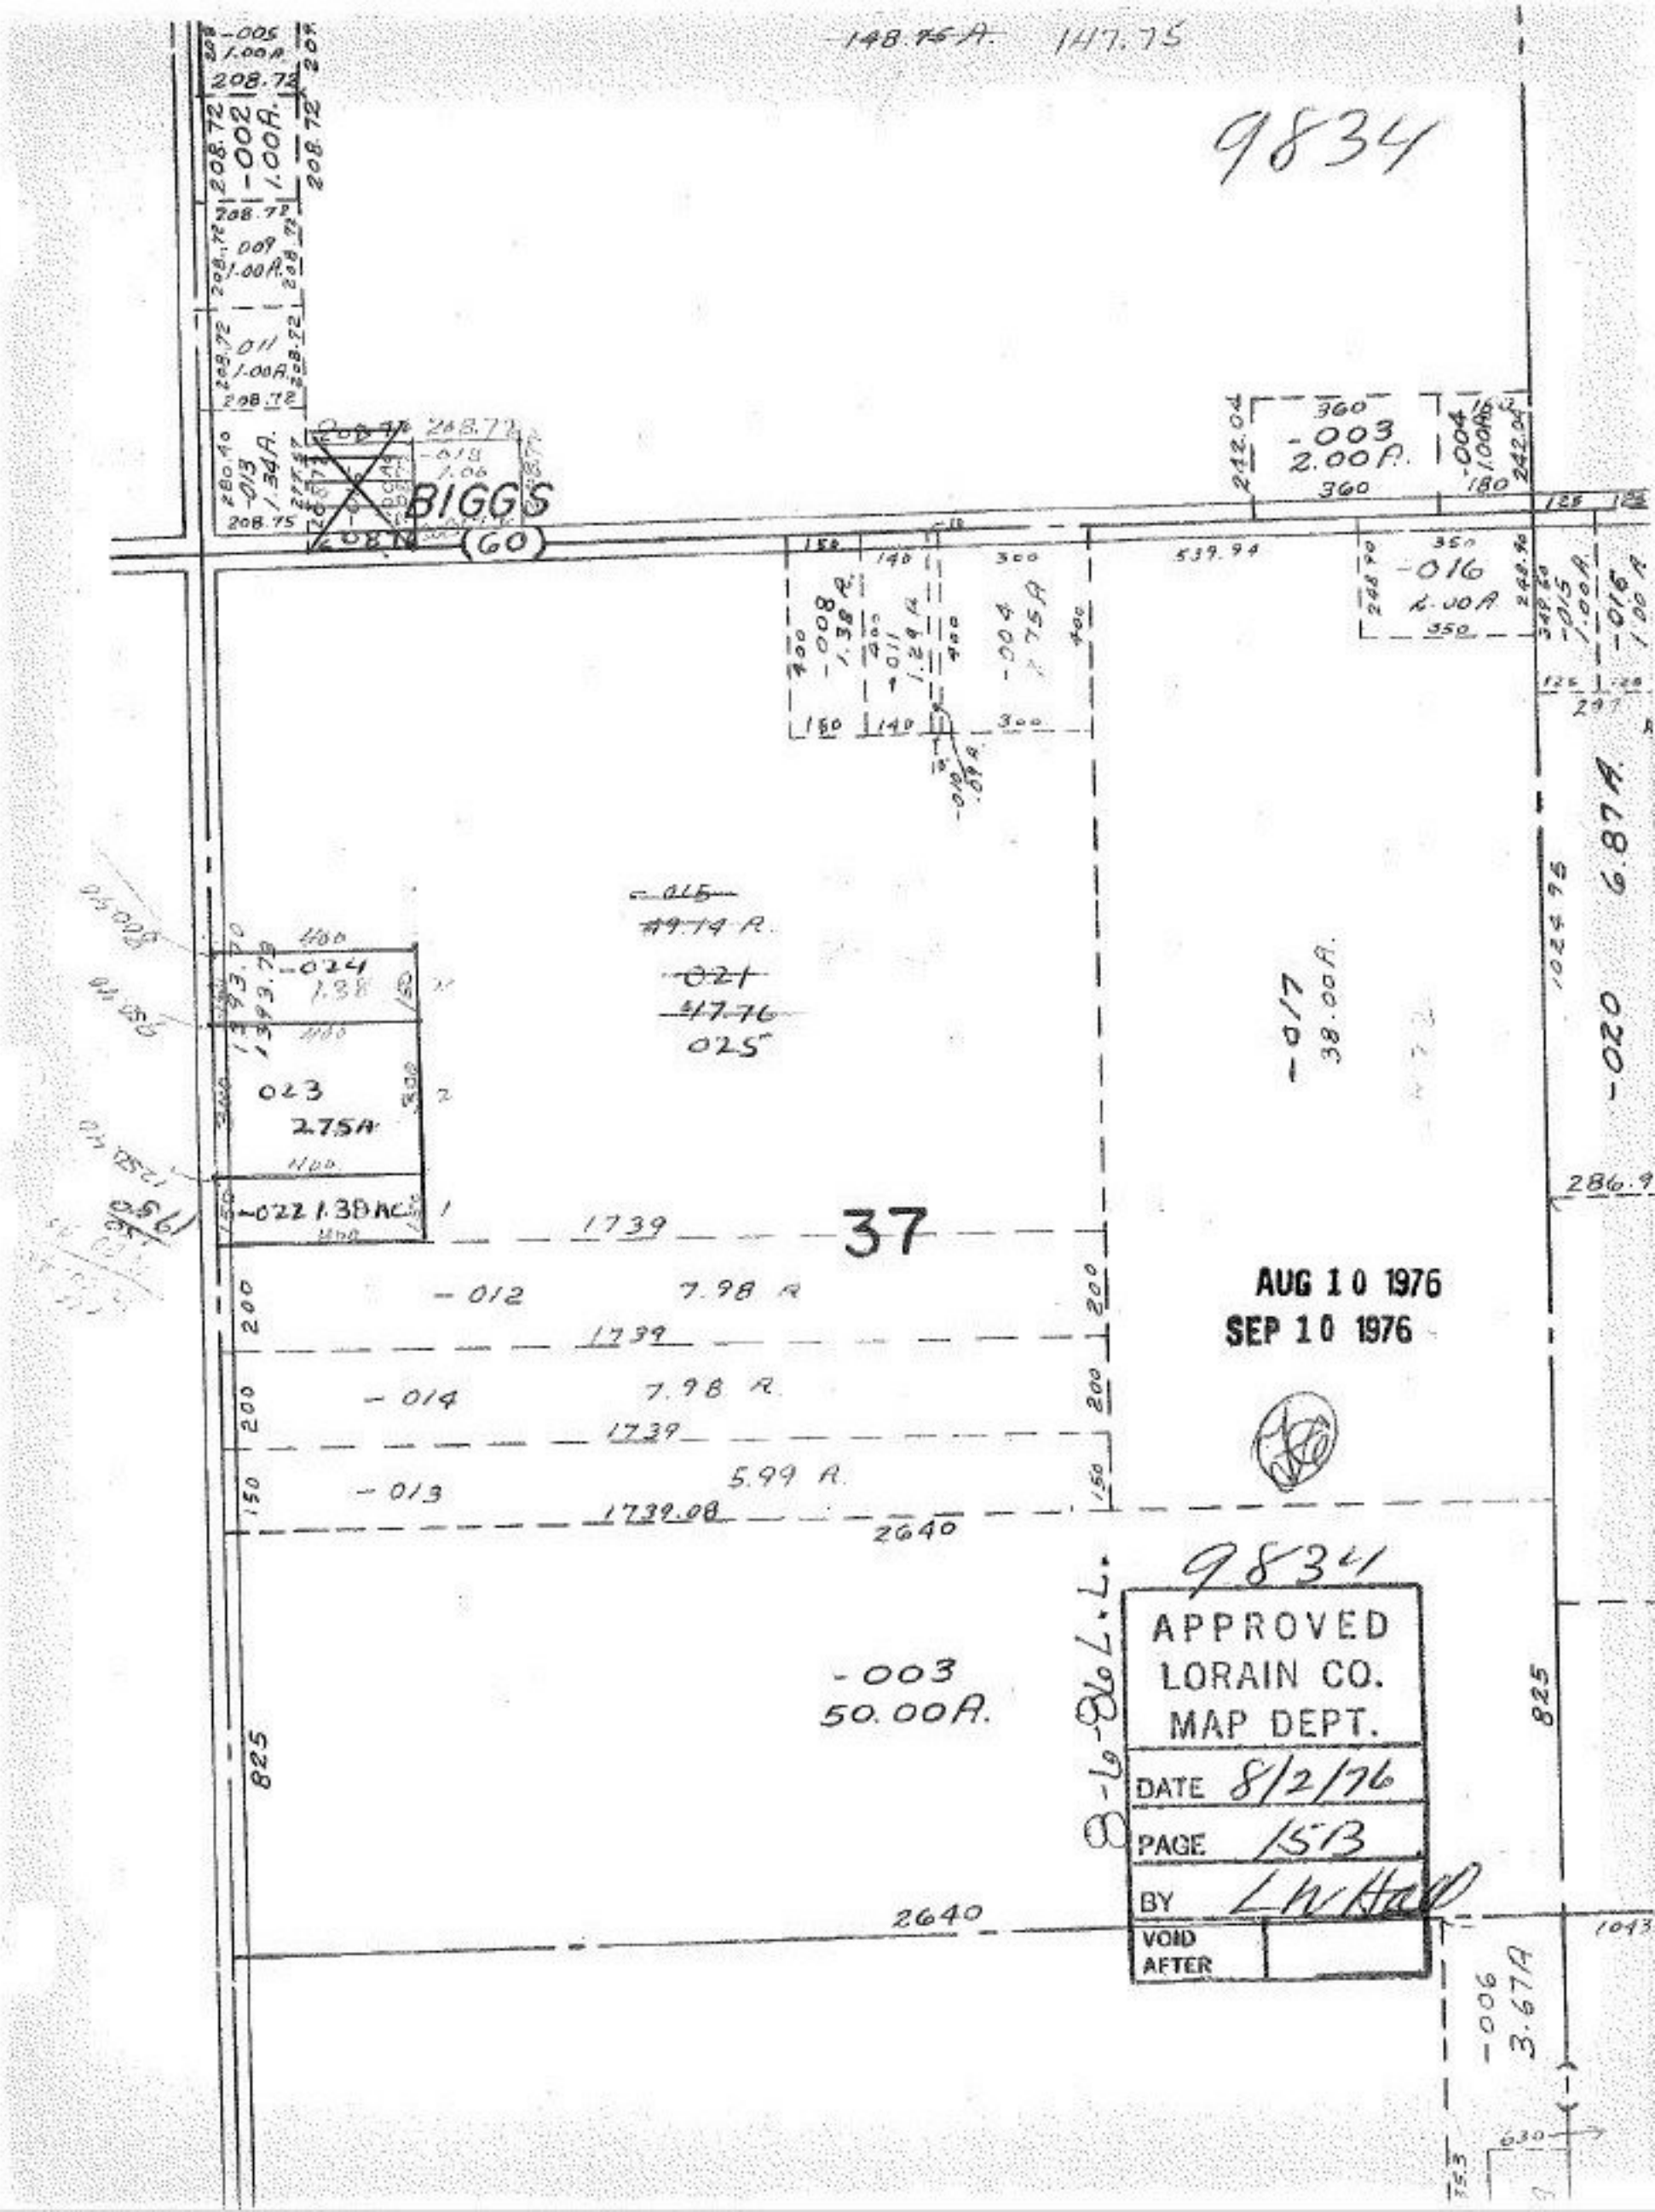

9834
148.75 A.
147.75
BIGGS
60
-003
2.00 A.
-016
2.00 A.
-008
1.38 A.
-011
1.29 A.
-004
1.75 A.
-015
49.74 A.
-021
47.76
025
-017
38.00 A.
-020
6.87 A.
-024
1.38
023
2.75 A.
-022 1.38 AC.
37
-012
7.98 A.
-014
7.98 A.
-013
5.99 A.
1739
1739.08
2640
-003
50.00 A.
825
-006
3.67 A.
AUG 10 1976
SEP 10 1976
9834
APPROVED
LORAIN CO.
MAP DEPT.
DATE 8/2/76
PAGE 15B
BY L.W. Hall
VOID AFTER
8-6-86 L.L.