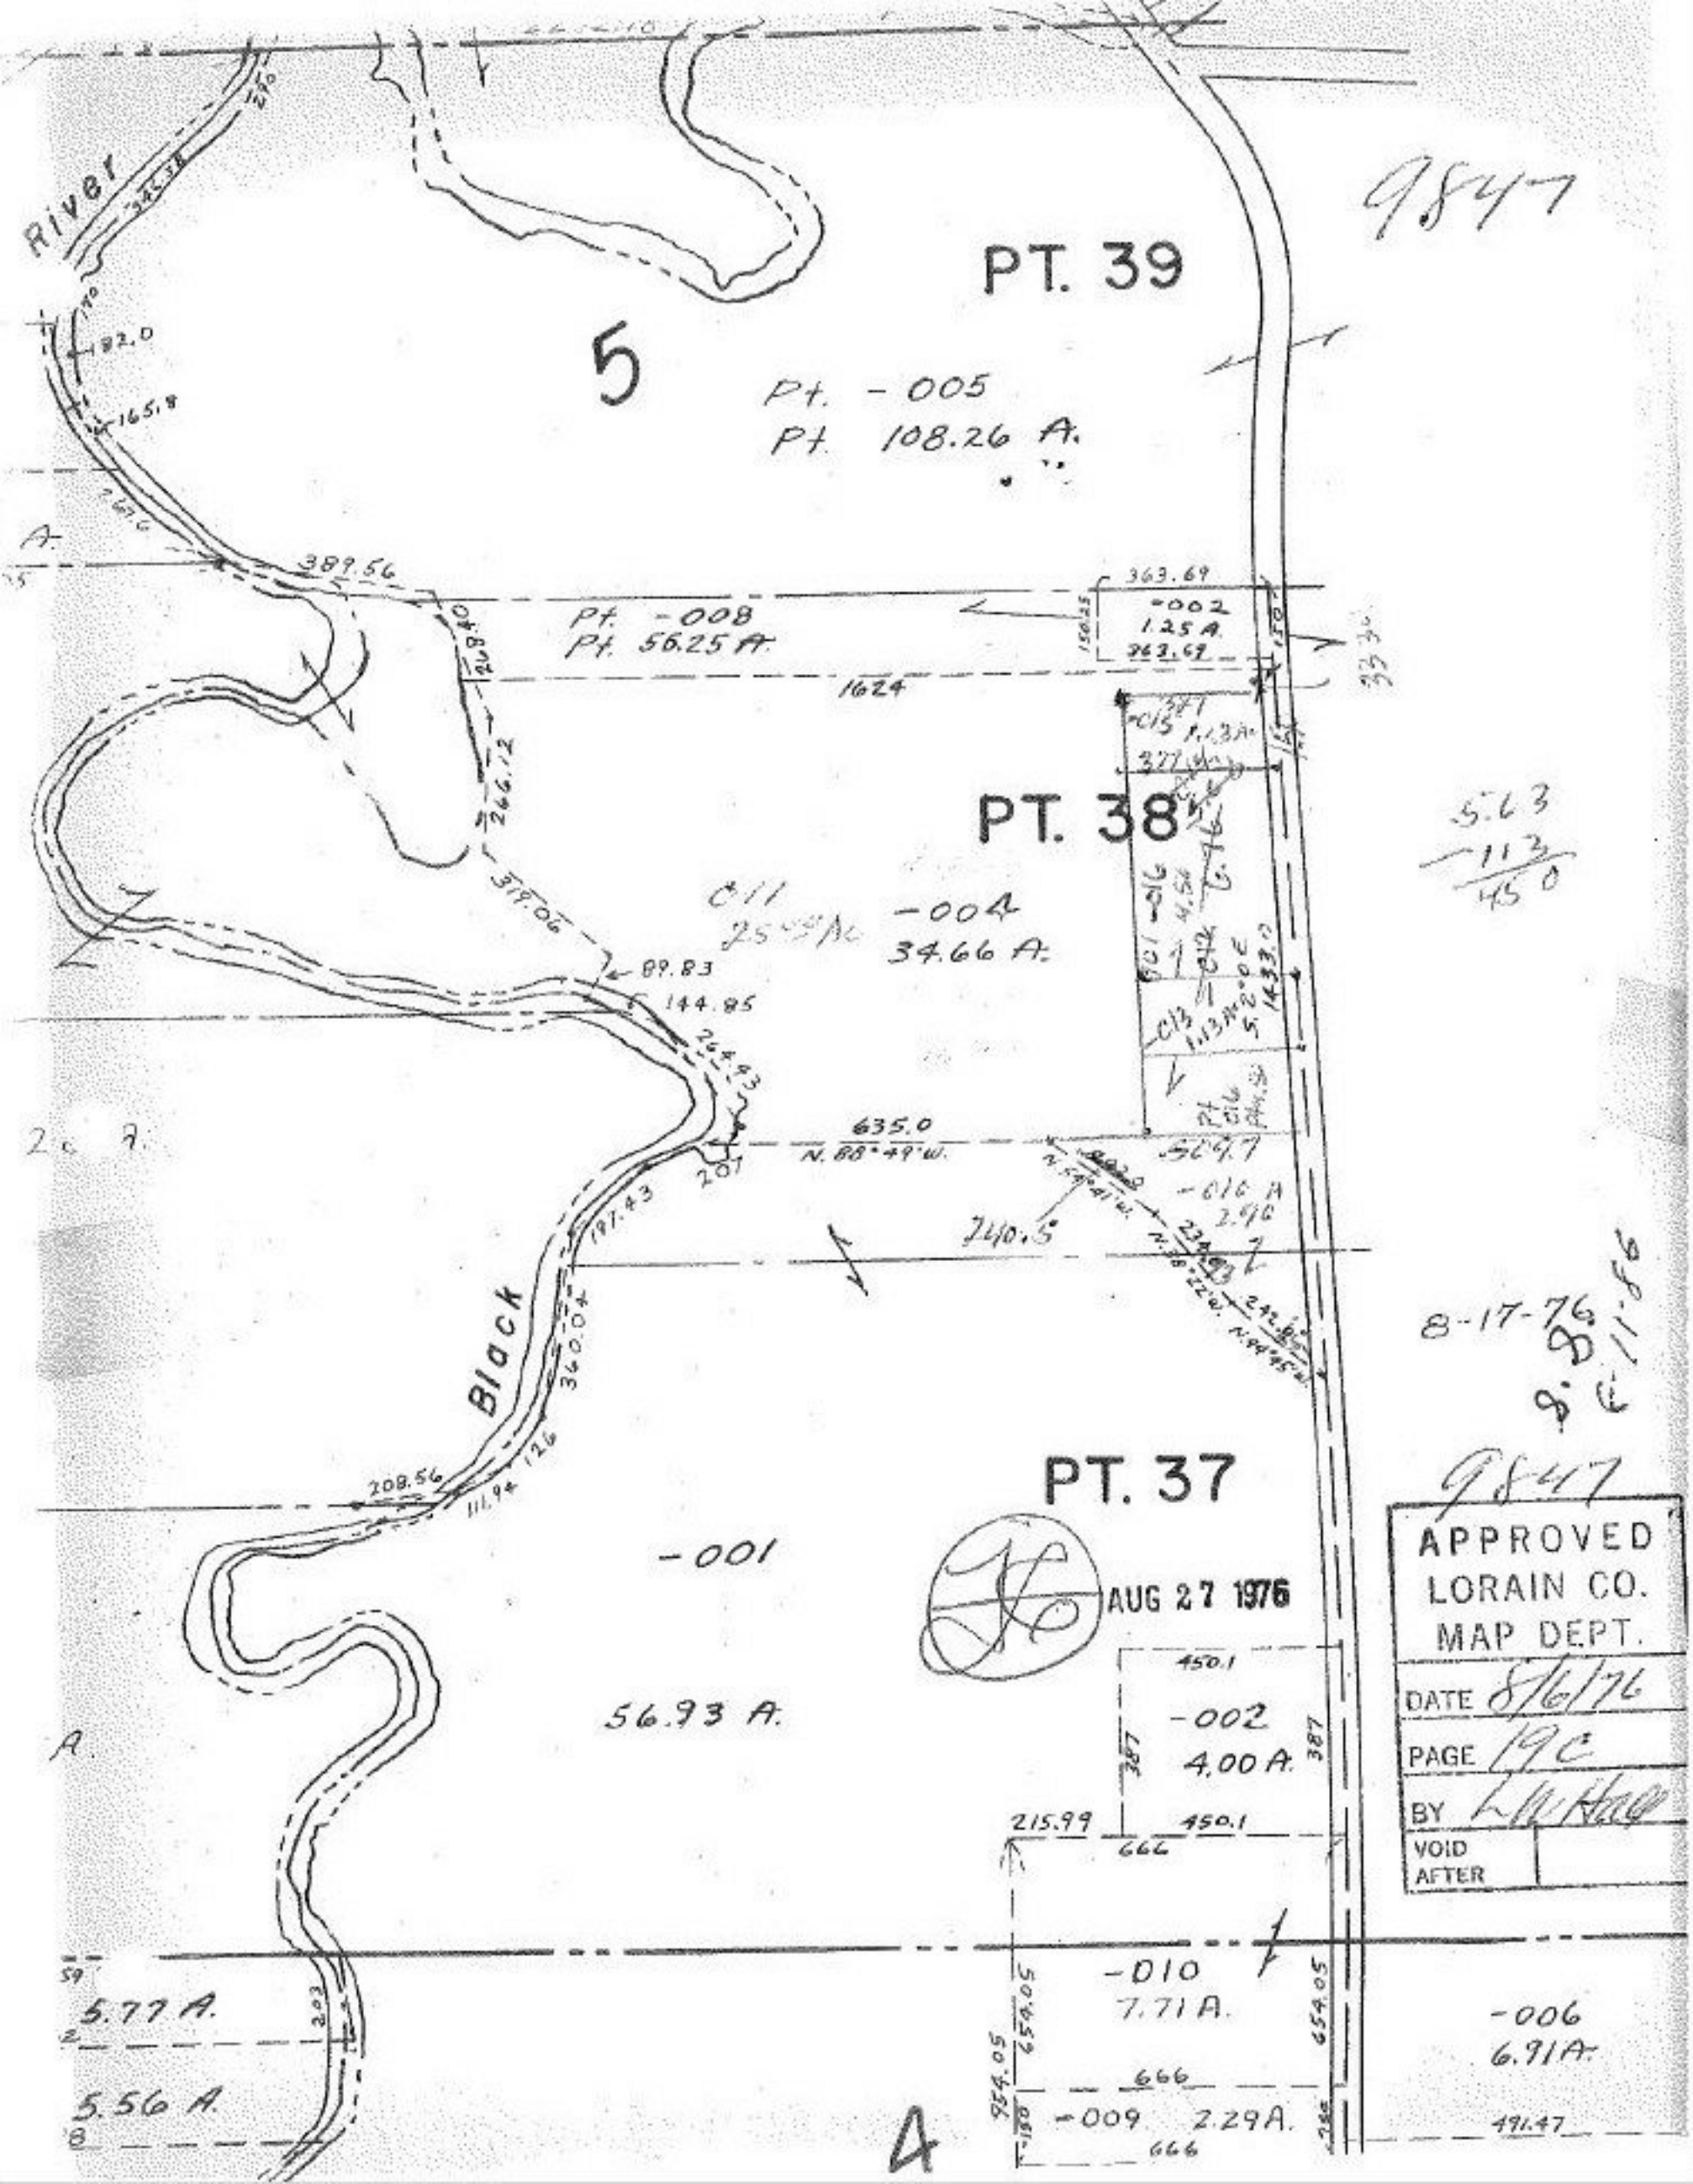

9847
PT. 39
5
Pt. -005
Pt. 108.26 A.
River
182.0
165.8
389.56
Pt. -008
Pt. 56.25 A.
363.69
-002
1.25 A.
363.69
1624
266.12
319.06
PT. 38
-004
34.66 A.
89.83
144.85
635.0
N. 88°49' W.
207
197.43
240.5
Black
360.04
126
208.56
111.94
PT. 37
-001
56.93 A.
450.1
-002
4.00 A.
387
215.99
450.1
666
-010
7.71 A.
654.05
-006
6.91 A.
666
-009
2.29 A.
666
491.47
5.77 A.
5.56 A.
4
5.63
113
450
8-17-76
8.8
6-11-86
9847
APPROVED
LORAIN CO.
MAP DEPT.
DATE 8/6/76
PAGE 19C
BY
VOID
AFTER
AUG 27 1976