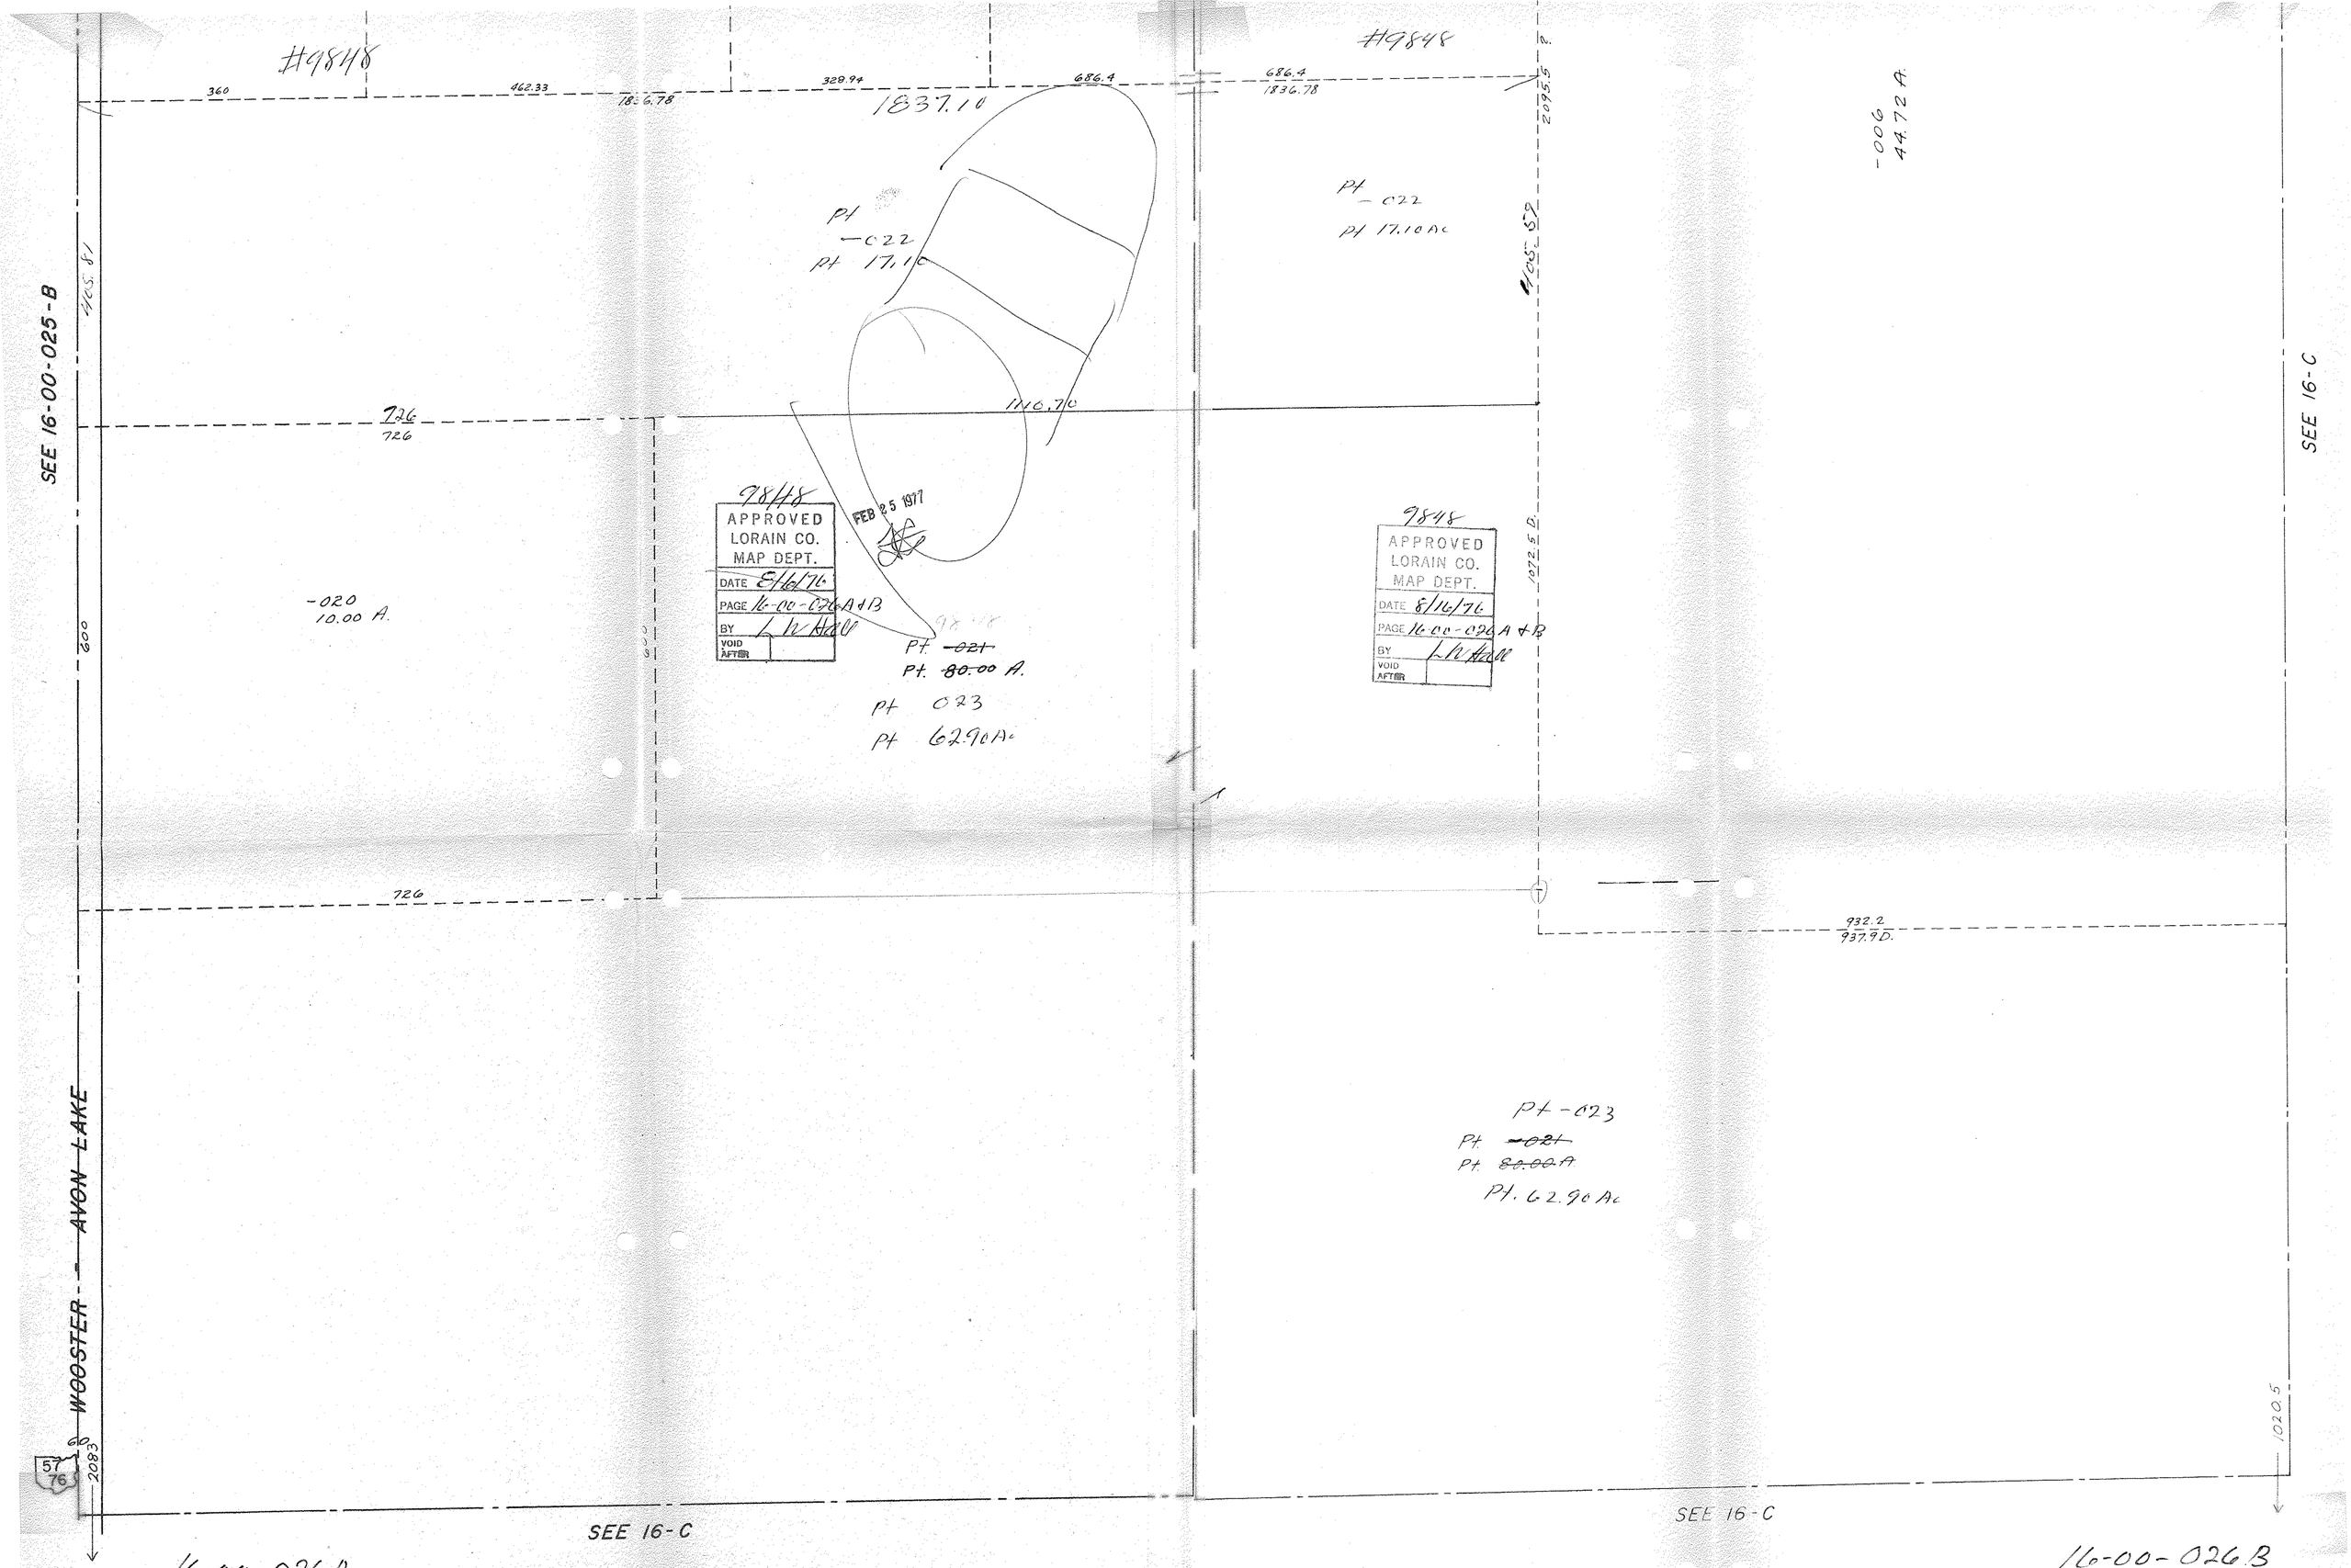

16-00-026A

GRAFTON TWP.

SCALE: 1" = 100'

WLY. PT. LOT 26

GRAFTON TWP.

SCALE: 1" = 100'

ELY. PT. LOT 26

16-00-026B