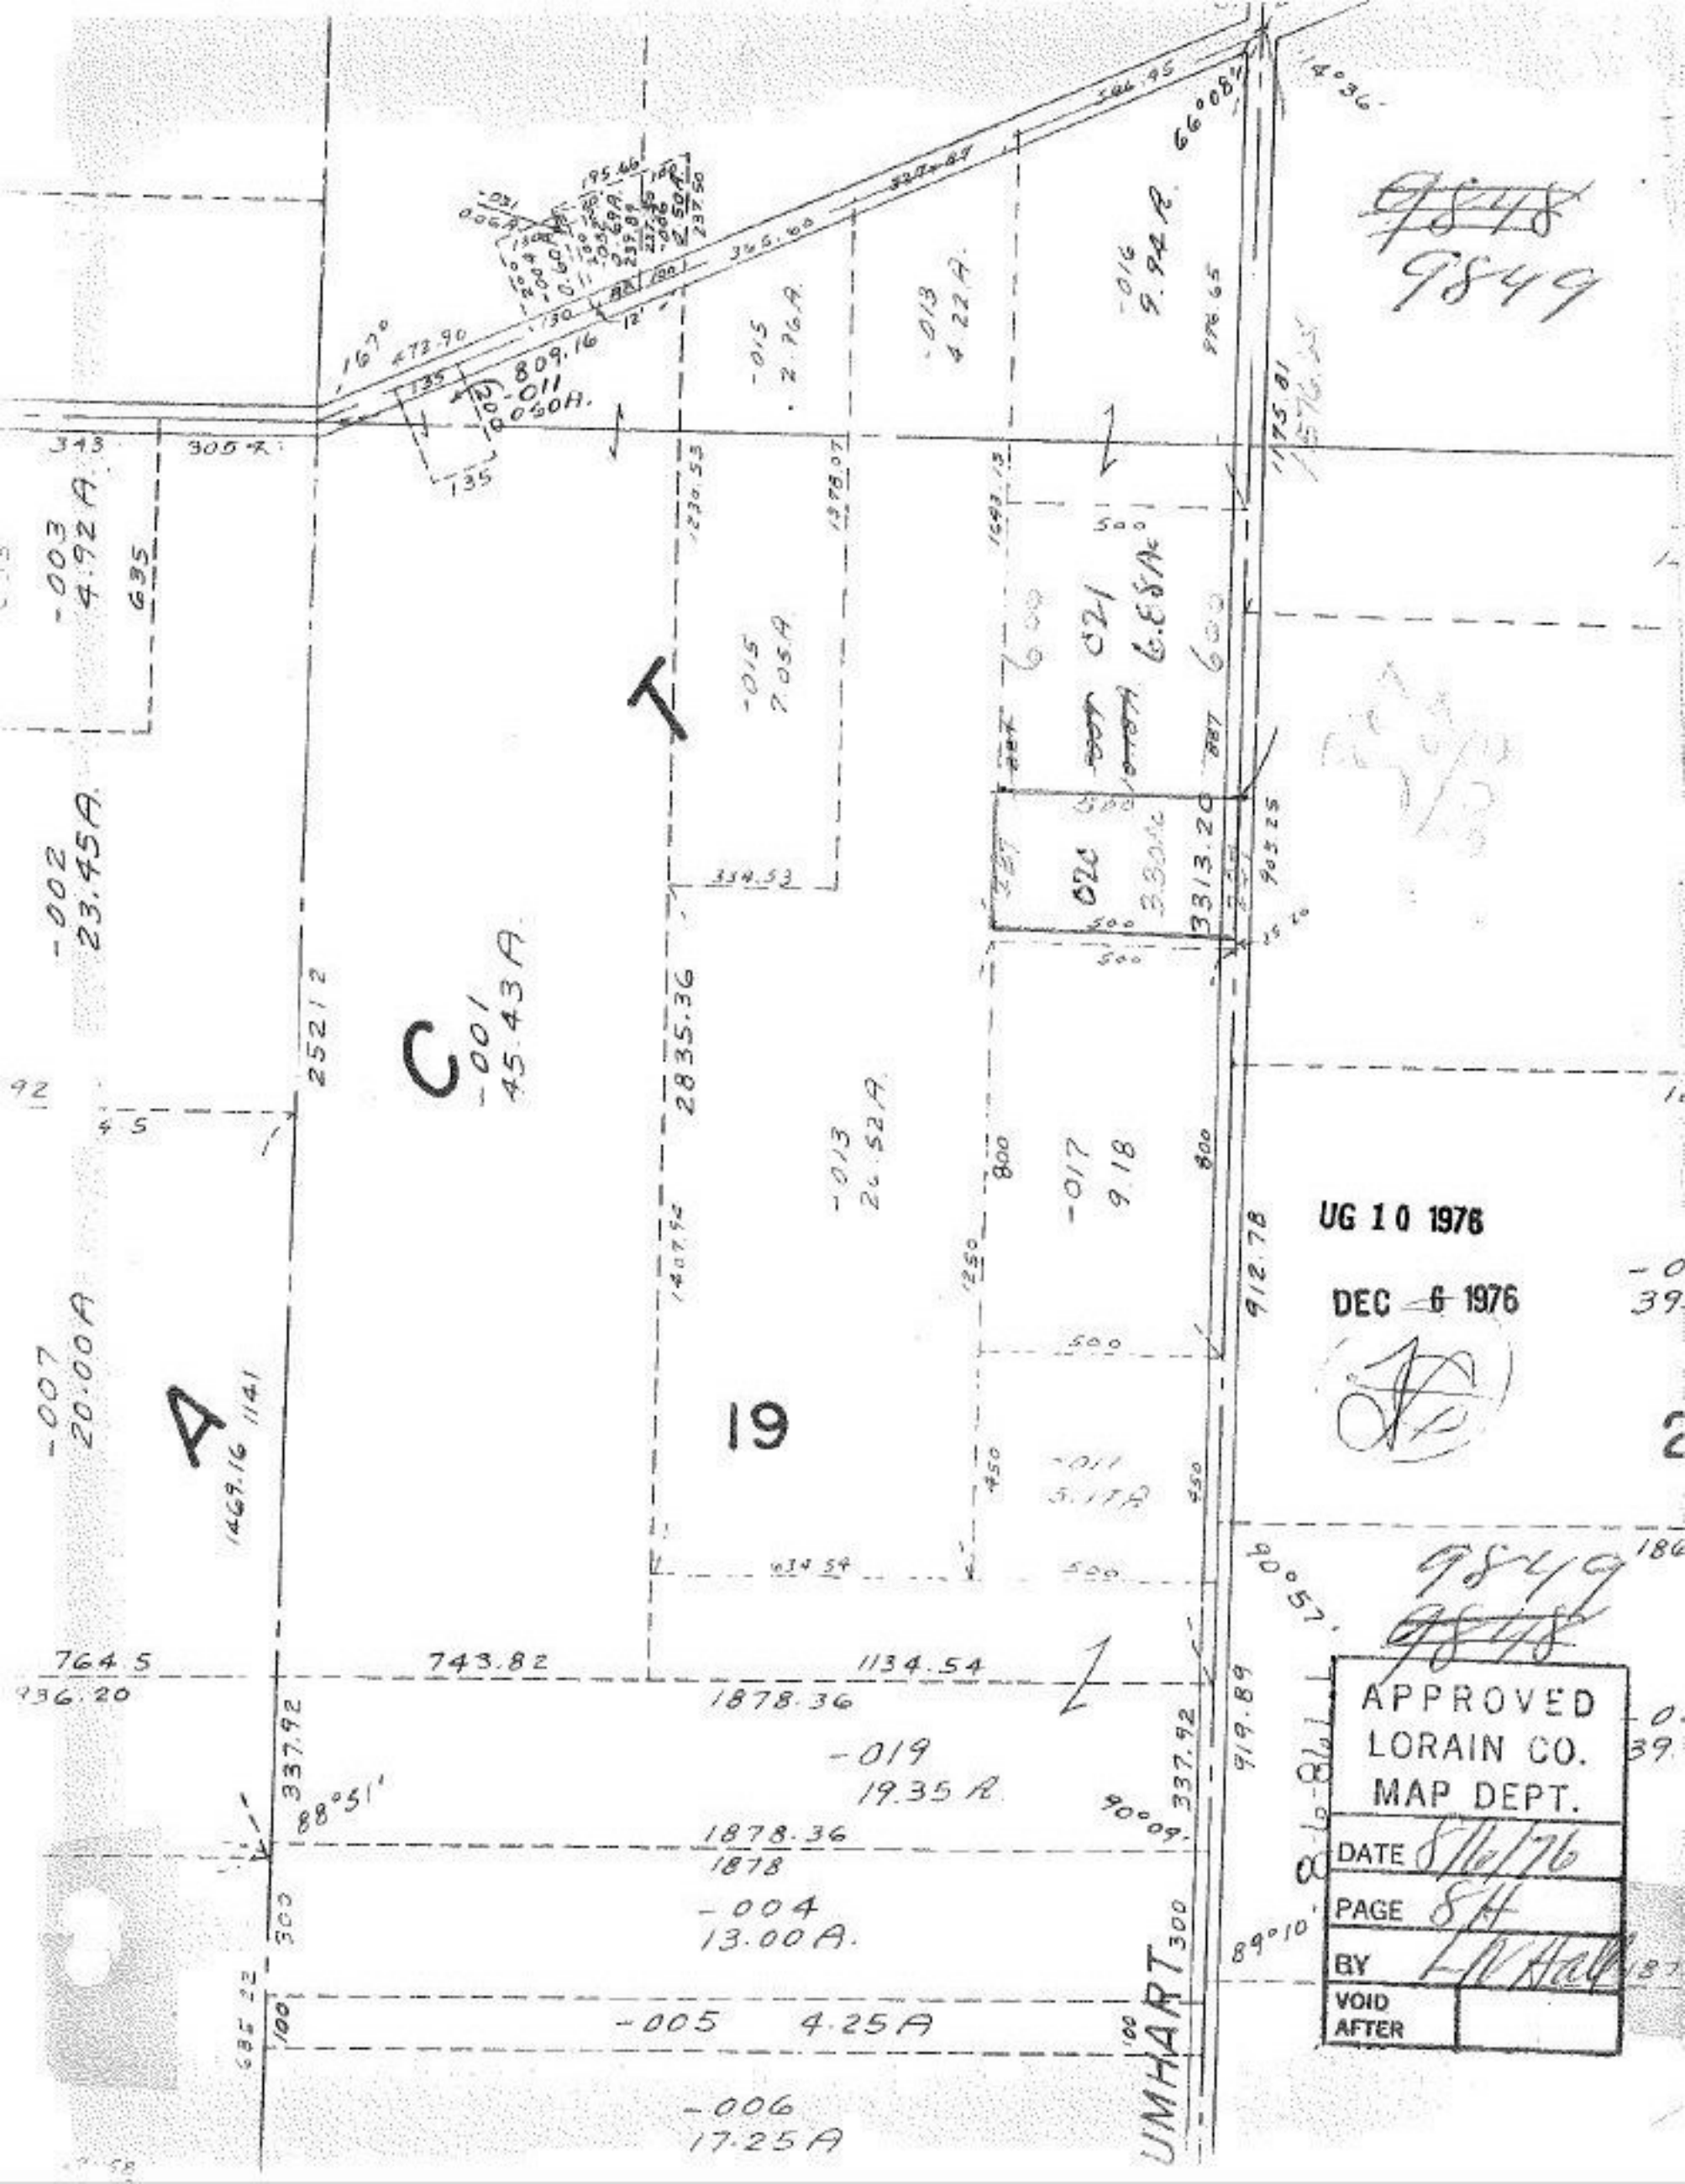

9848
9849
-003
4.92 A
-002
23.45 A
-007
20.00 A
A
C
-001
45.43 A
19
-015
2.76 A
-013
4.22 A
-016
9.94 A
-015
7.05 A
-013
26.52 A
-017
9.18
-011
5.17 A
-019
19.35 A
-004
13.00 A
-005
4.25 A
-006
17.25 A
UMHART
764.5
743.82
1134.54
1878.36
1878
2835.36
3313.20
912.78
919.89
90°57'
89°10'
88°51'
UG 10 1976
DEC 6 1976
APPROVED
LORAIN CO.
MAP DEPT.
DATE 8/16/76
PAGE 8H
BY
VOID AFTER