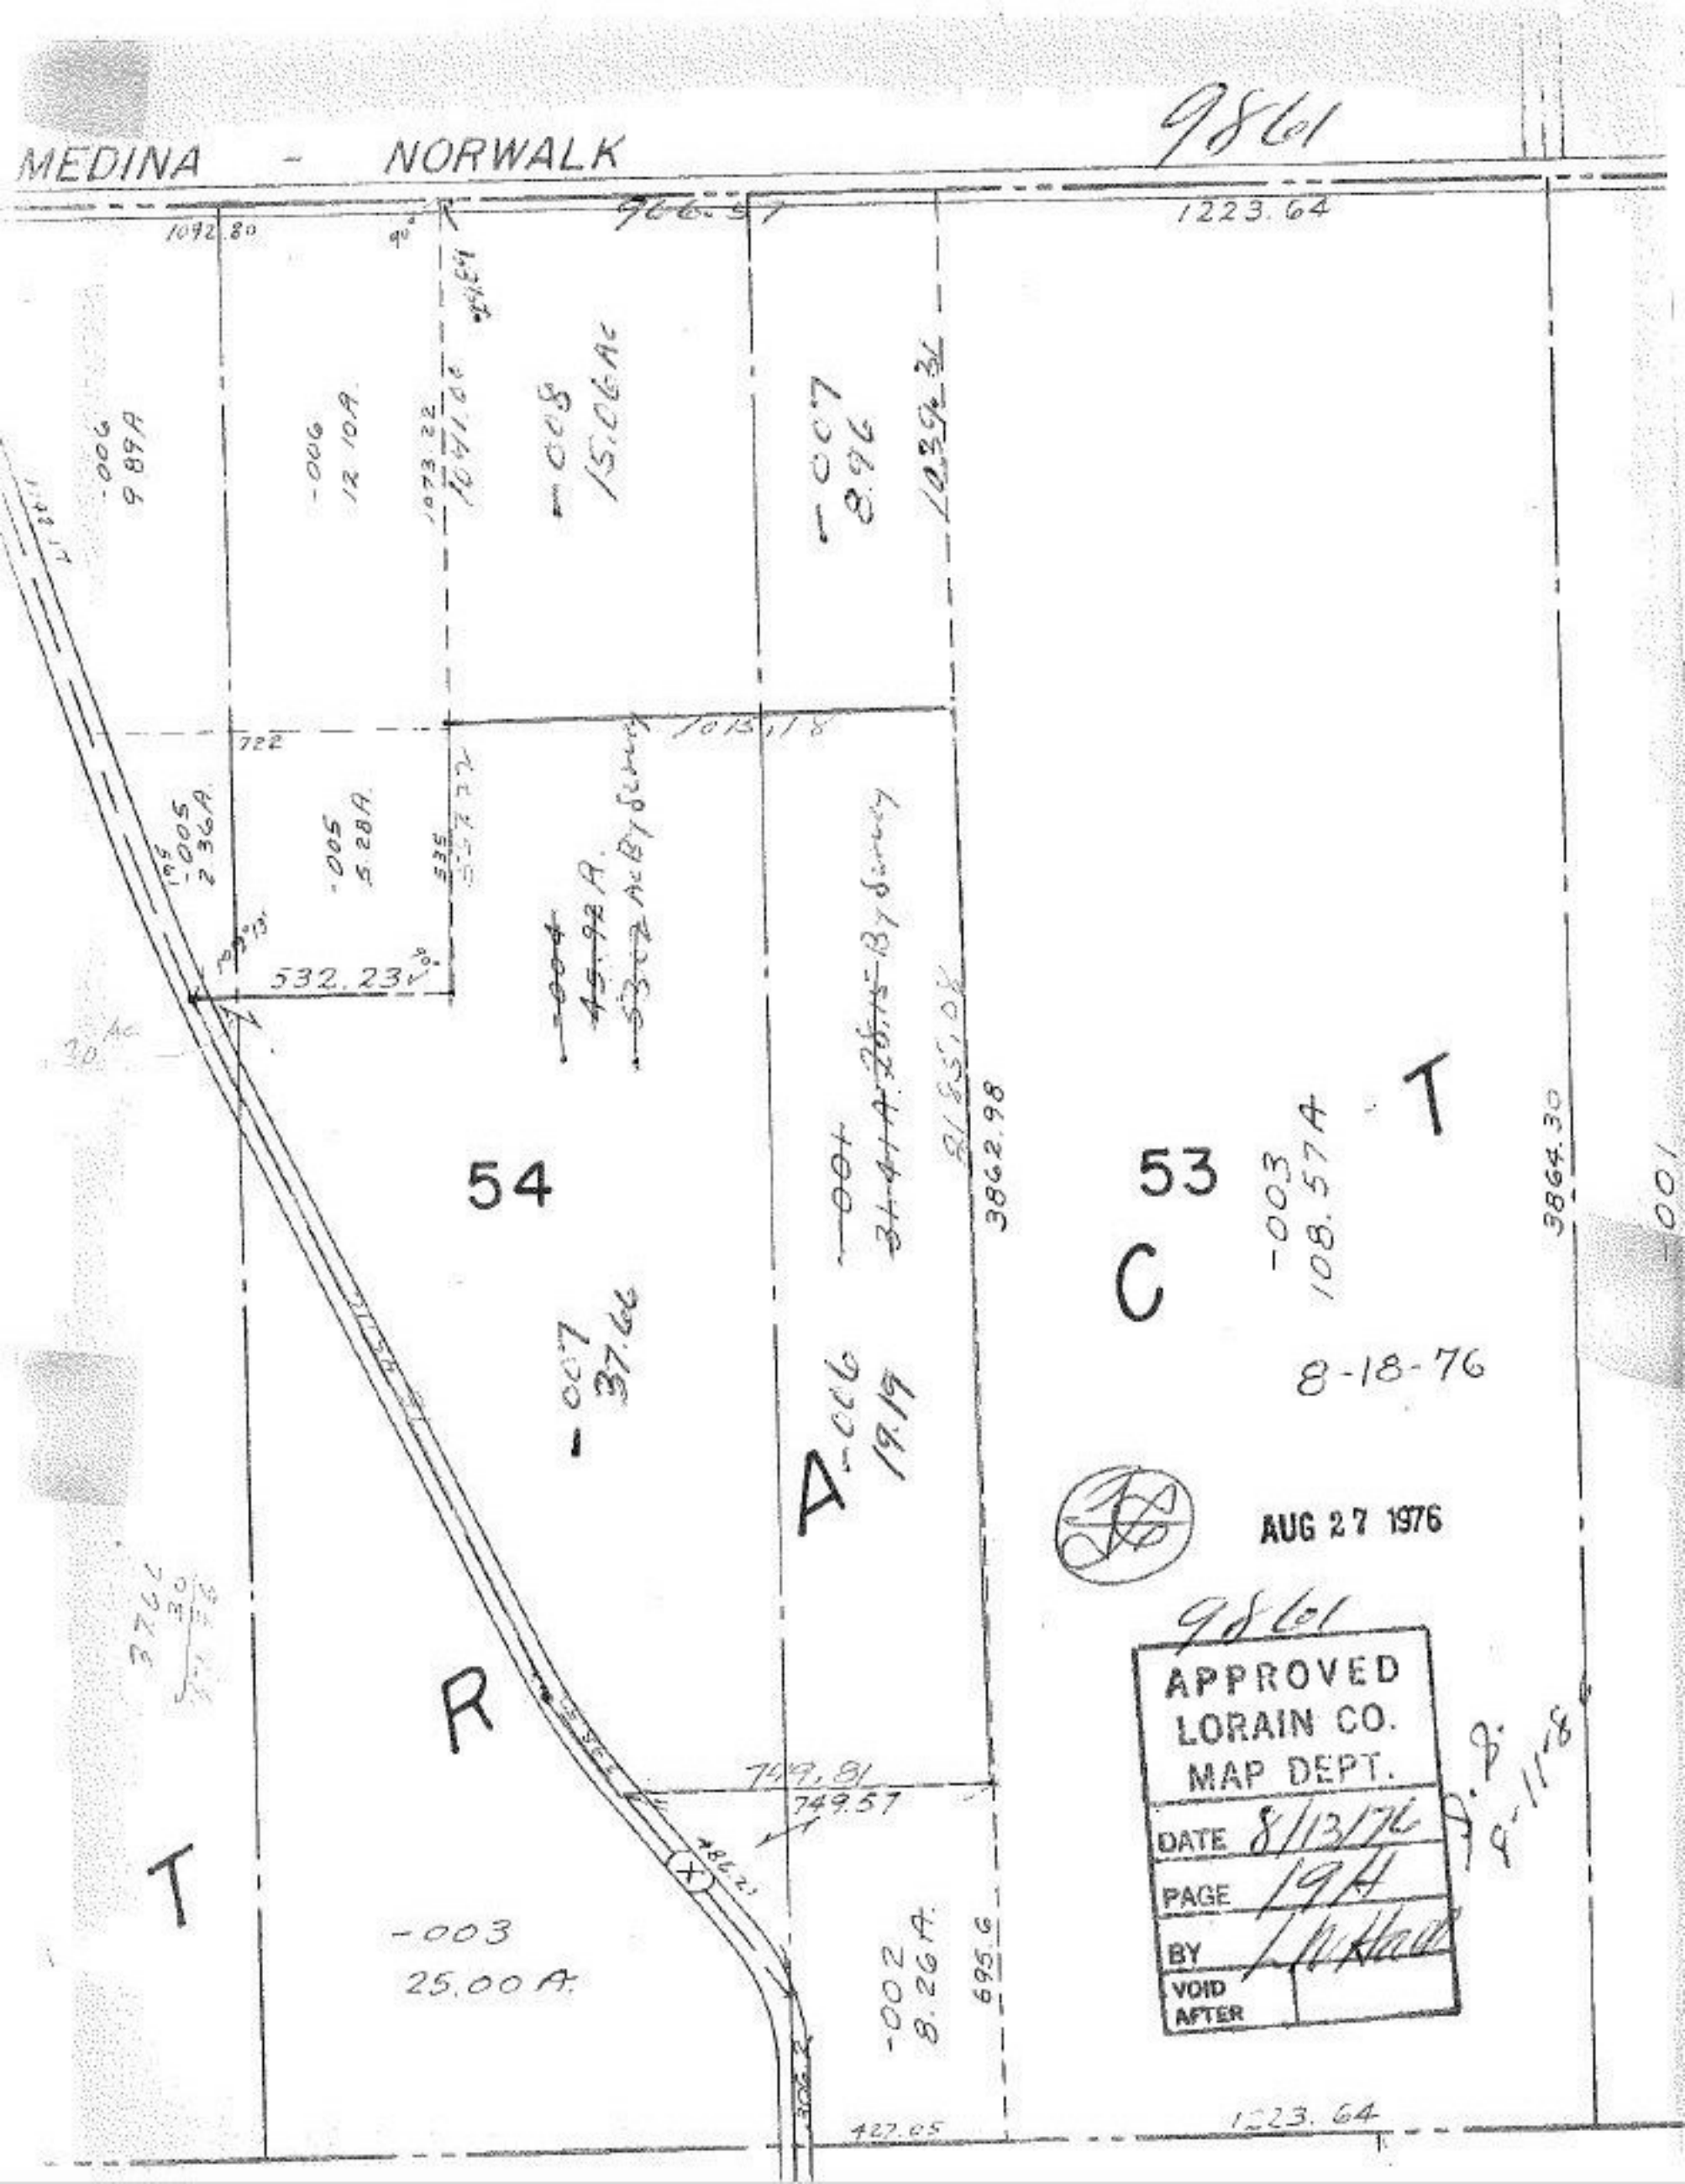
MEDINA - NORWALK
9861
1223.64
1092.80
966.57
-006
9.89A
-006
12.10A
1073.22
1041.00
-008
15.06Ac
-007
8.96
1039.31
722
1013.18
-005
2.36A
-005
5.28A
535
532.23
54
53
C
T
-003
108.57A
3862.98
3864.30
-001
-007
37.66
-006
19.19
A
R
T
749.81
749.57
-003
25.00A
-002
8.26A
695.6
427.05
1223.64
8-18-76
AUG 27 1976
9861
APPROVED
LORAIN CO.
MAP DEPT.
DATE 8/13/76
PAGE 19A
BY
VOID
AFTER