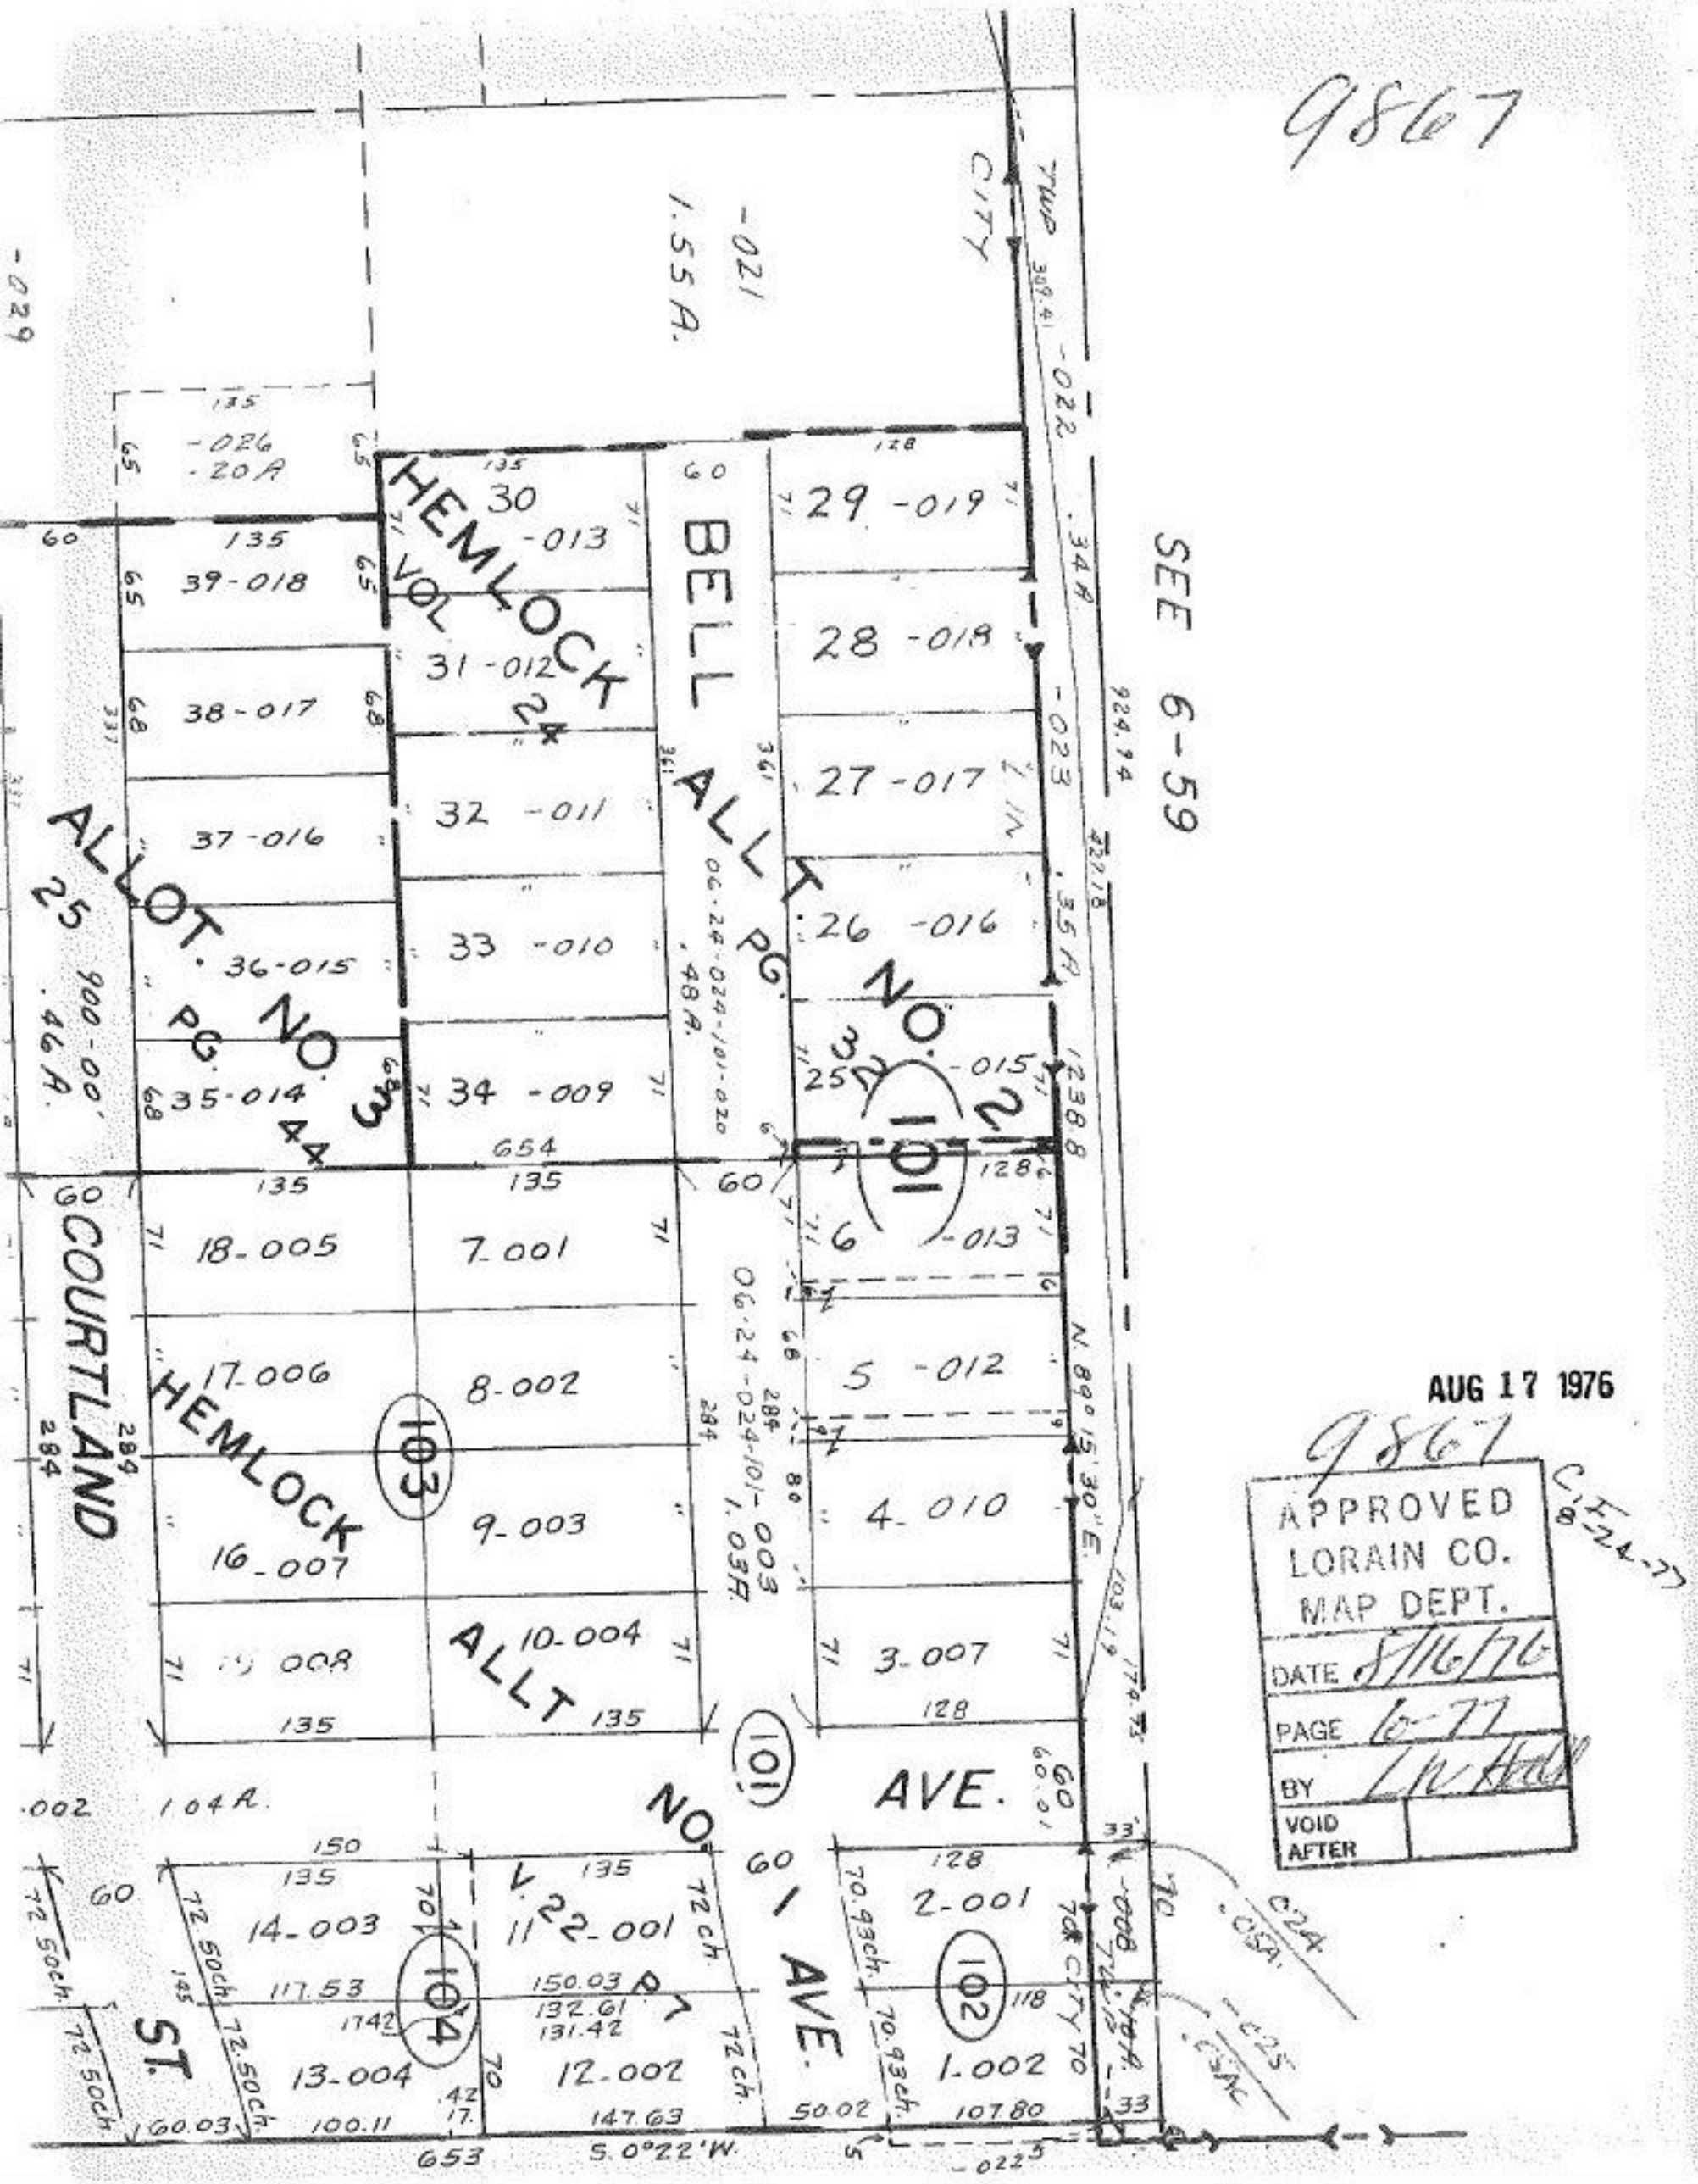
9867
CITY
TWP
-021
1.55 A.
-022
-023
-026
-20 A
-029
SEE 6-59
HEMLOCK VOL 24
BELL ALLT. NO. 2
PG. 32
ALLOT. NO. 3
PG. 44
25
900-00
.46 A.
30 -013
31 -012
32 -011
33 -010
34 -009
29 -019
28 -018
27 -017
26 -016
25 -015
6 -013
5 -012
4 -010
3 -007
39-018
38-017
37-016
36-015
35-014
18-005
17-006
16-007
7-001
8-002
9-003
10-004
COURTLAND
HEMLOCK
ALLT
NO. 1 AVE.
AVE.
103
101
104
102
V. 22-001
14-003
13-004
12-002
2-001
1-002
ST.
654
653
S. 0°22' W.
N. 89° 15' 30" E.
C24
C25
C.I. 8-24-77
AUG 17 1976
APPROVED
LORAIN CO.
MAP DEPT.
DATE 8/16/76
PAGE 6-77
BY
VOID AFTER