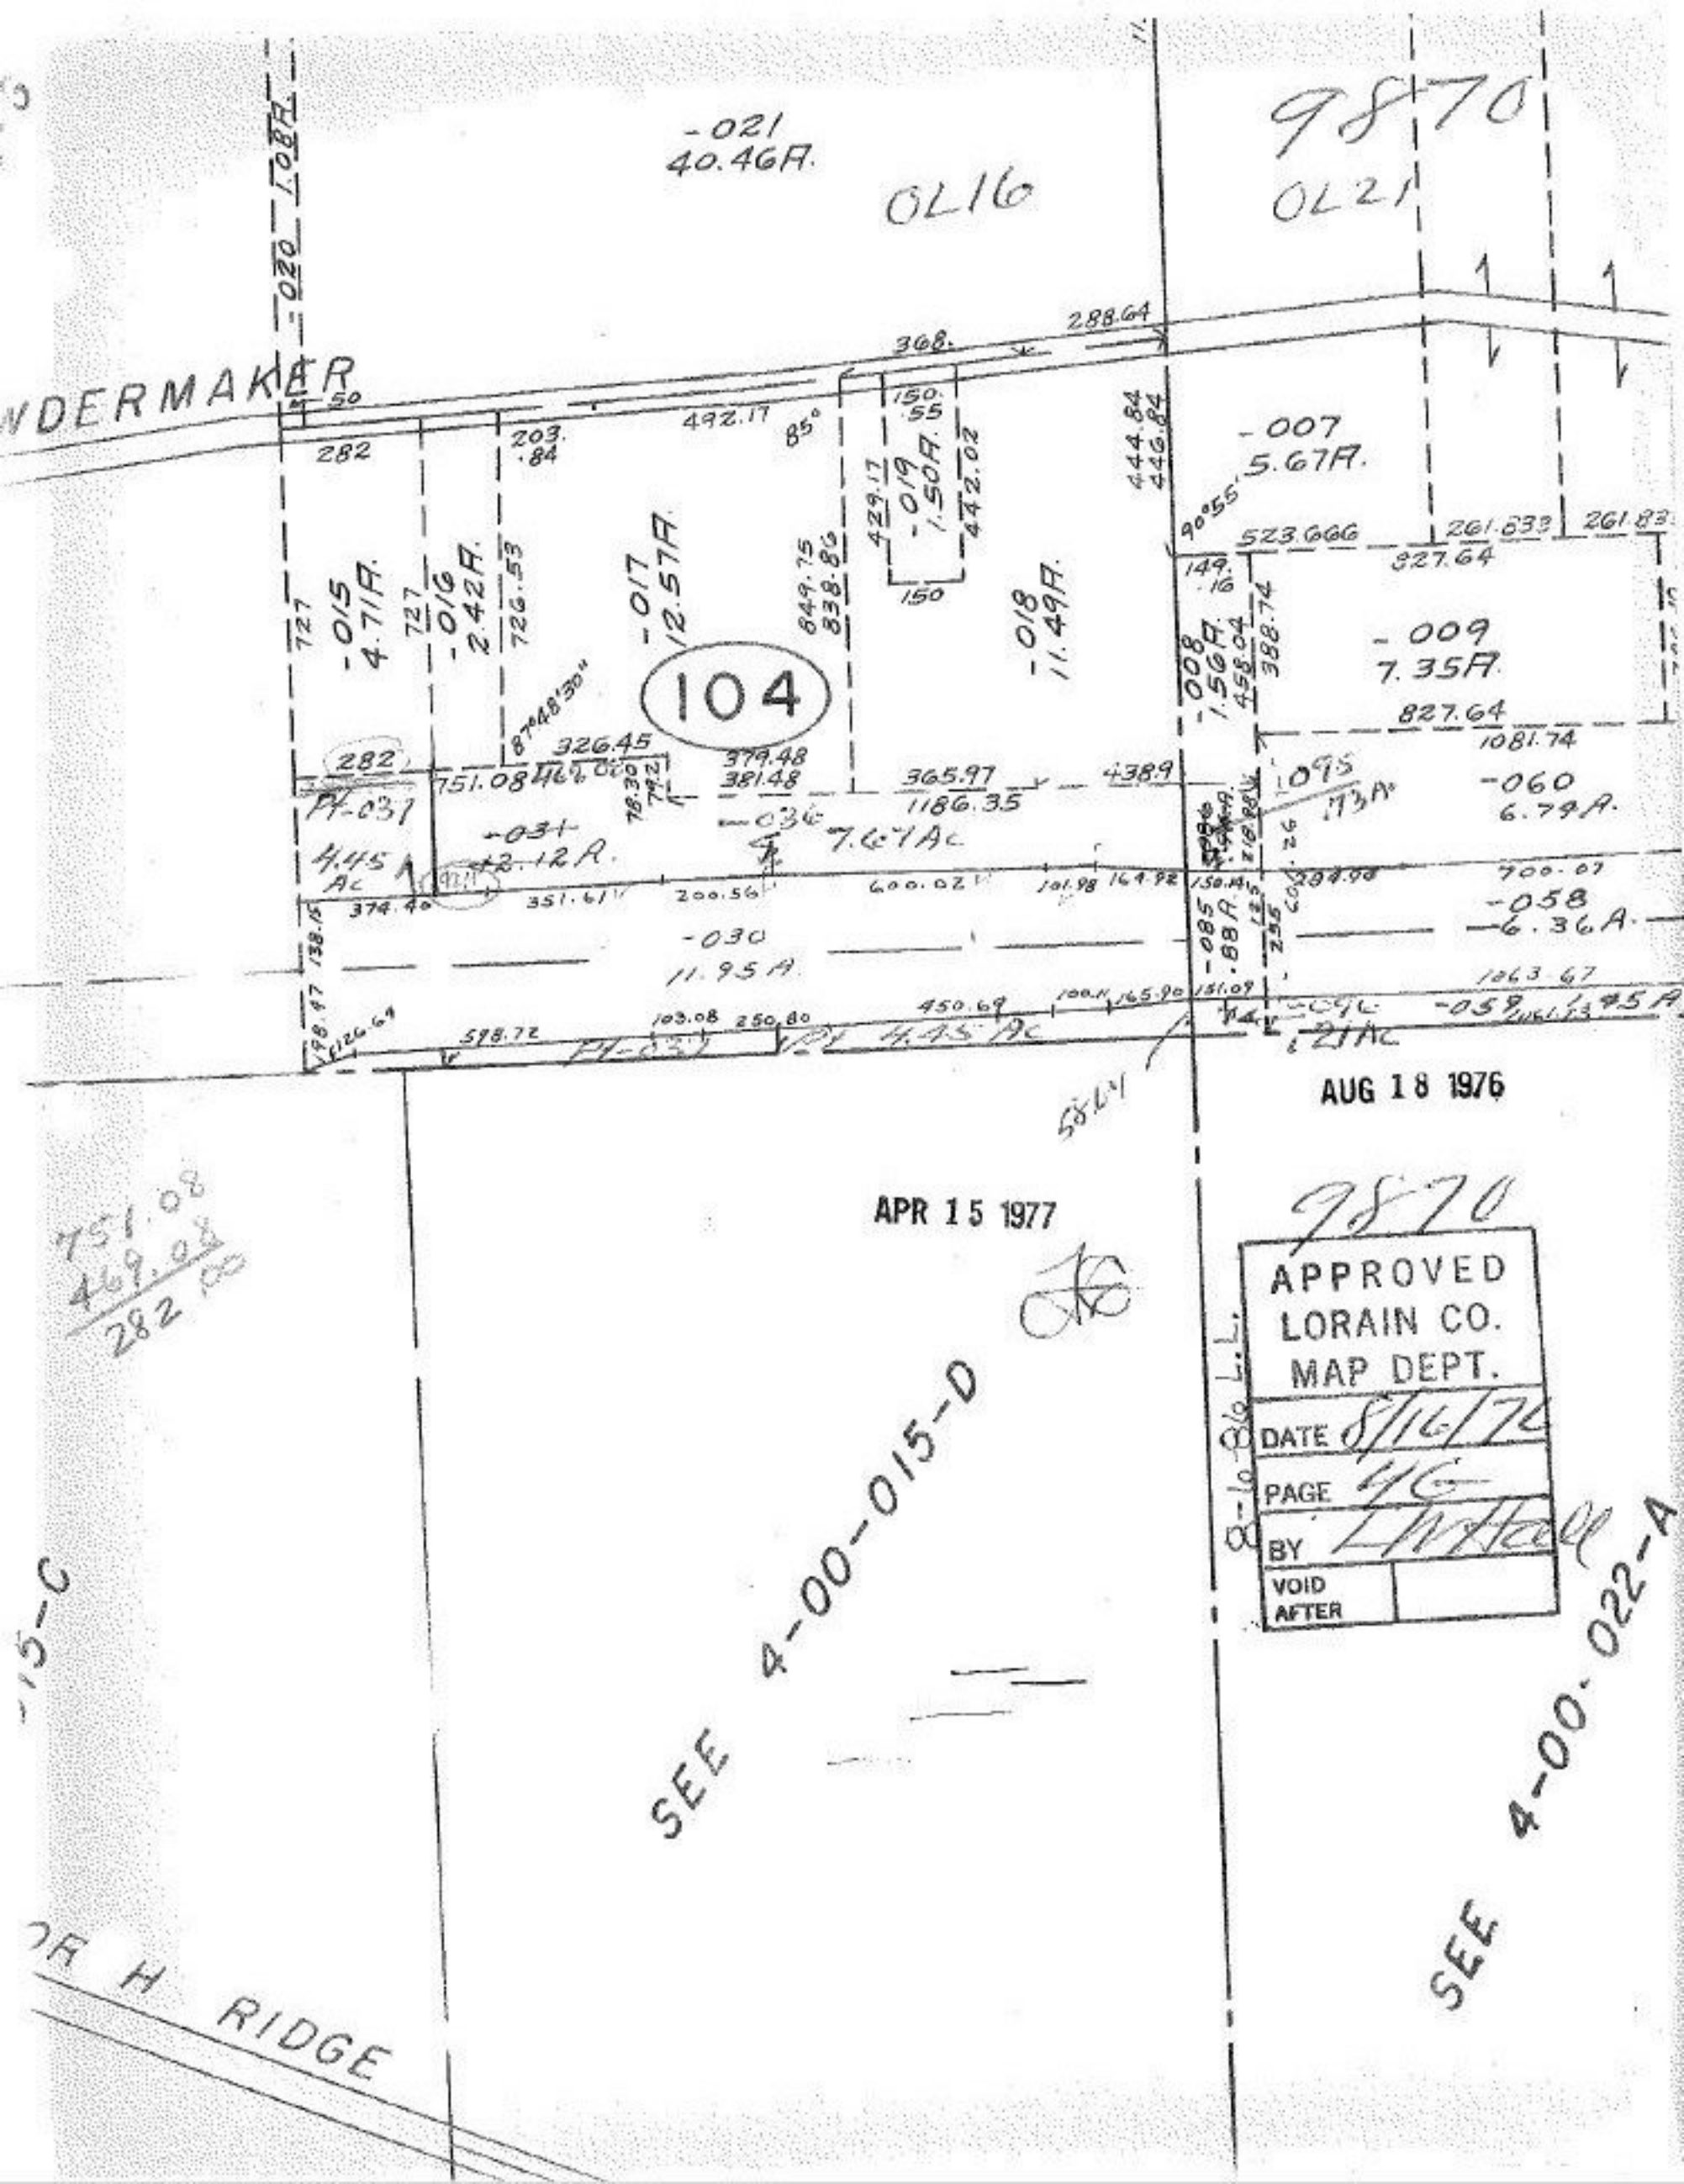
9870
OL16
OL21
-021
40.46A.
-020 1.08A.
WDERMAKER
288.64
368.
492.17
85°
150.55
-019
1.50A.
442.02
429.17
150
444.84
446.84
-007
5.67A.
90°55'
523.666
261.833
827.64
149.16
-009
7.35A.
827.64
1081.74
-015
4.71A.
727
-016
2.42A.
726.53
-017
12.57A.
849.75
838.86
-018
11.49A.
-008
1.56A.
458.04
388.74
104
87°48'30"
326.45
379.48
381.48
365.97
1186.35
438.9
282
751.08
Pt-037
4.45 Ac
-031
2.12A.
-036
7.67Ac
-060
6.79A.
374.40
351.61
200.56
600.02
101.98
164.92
150.14
284.98
700.07
-058
6.36A.
-030
11.95A.
-085
.88A.
1063.67
-059
1.45A
598.72
103.08
250.80
450.69
100.11
165.90
151.09
Pt 4.45 Ac
Pt-037
.21Ac
AUG 18 1976
APR 15 1977
9870
APPROVED
LORAIN CO.
MAP DEPT.
DATE 8/16/76
PAGE 46
BY L.W. Hall
VOID AFTER
8-16-86 L.L.
751.08
469.08
282.00
SEE 4-00-015-D
SEE 4-00-022-A
-15-C
OR H RIDGE