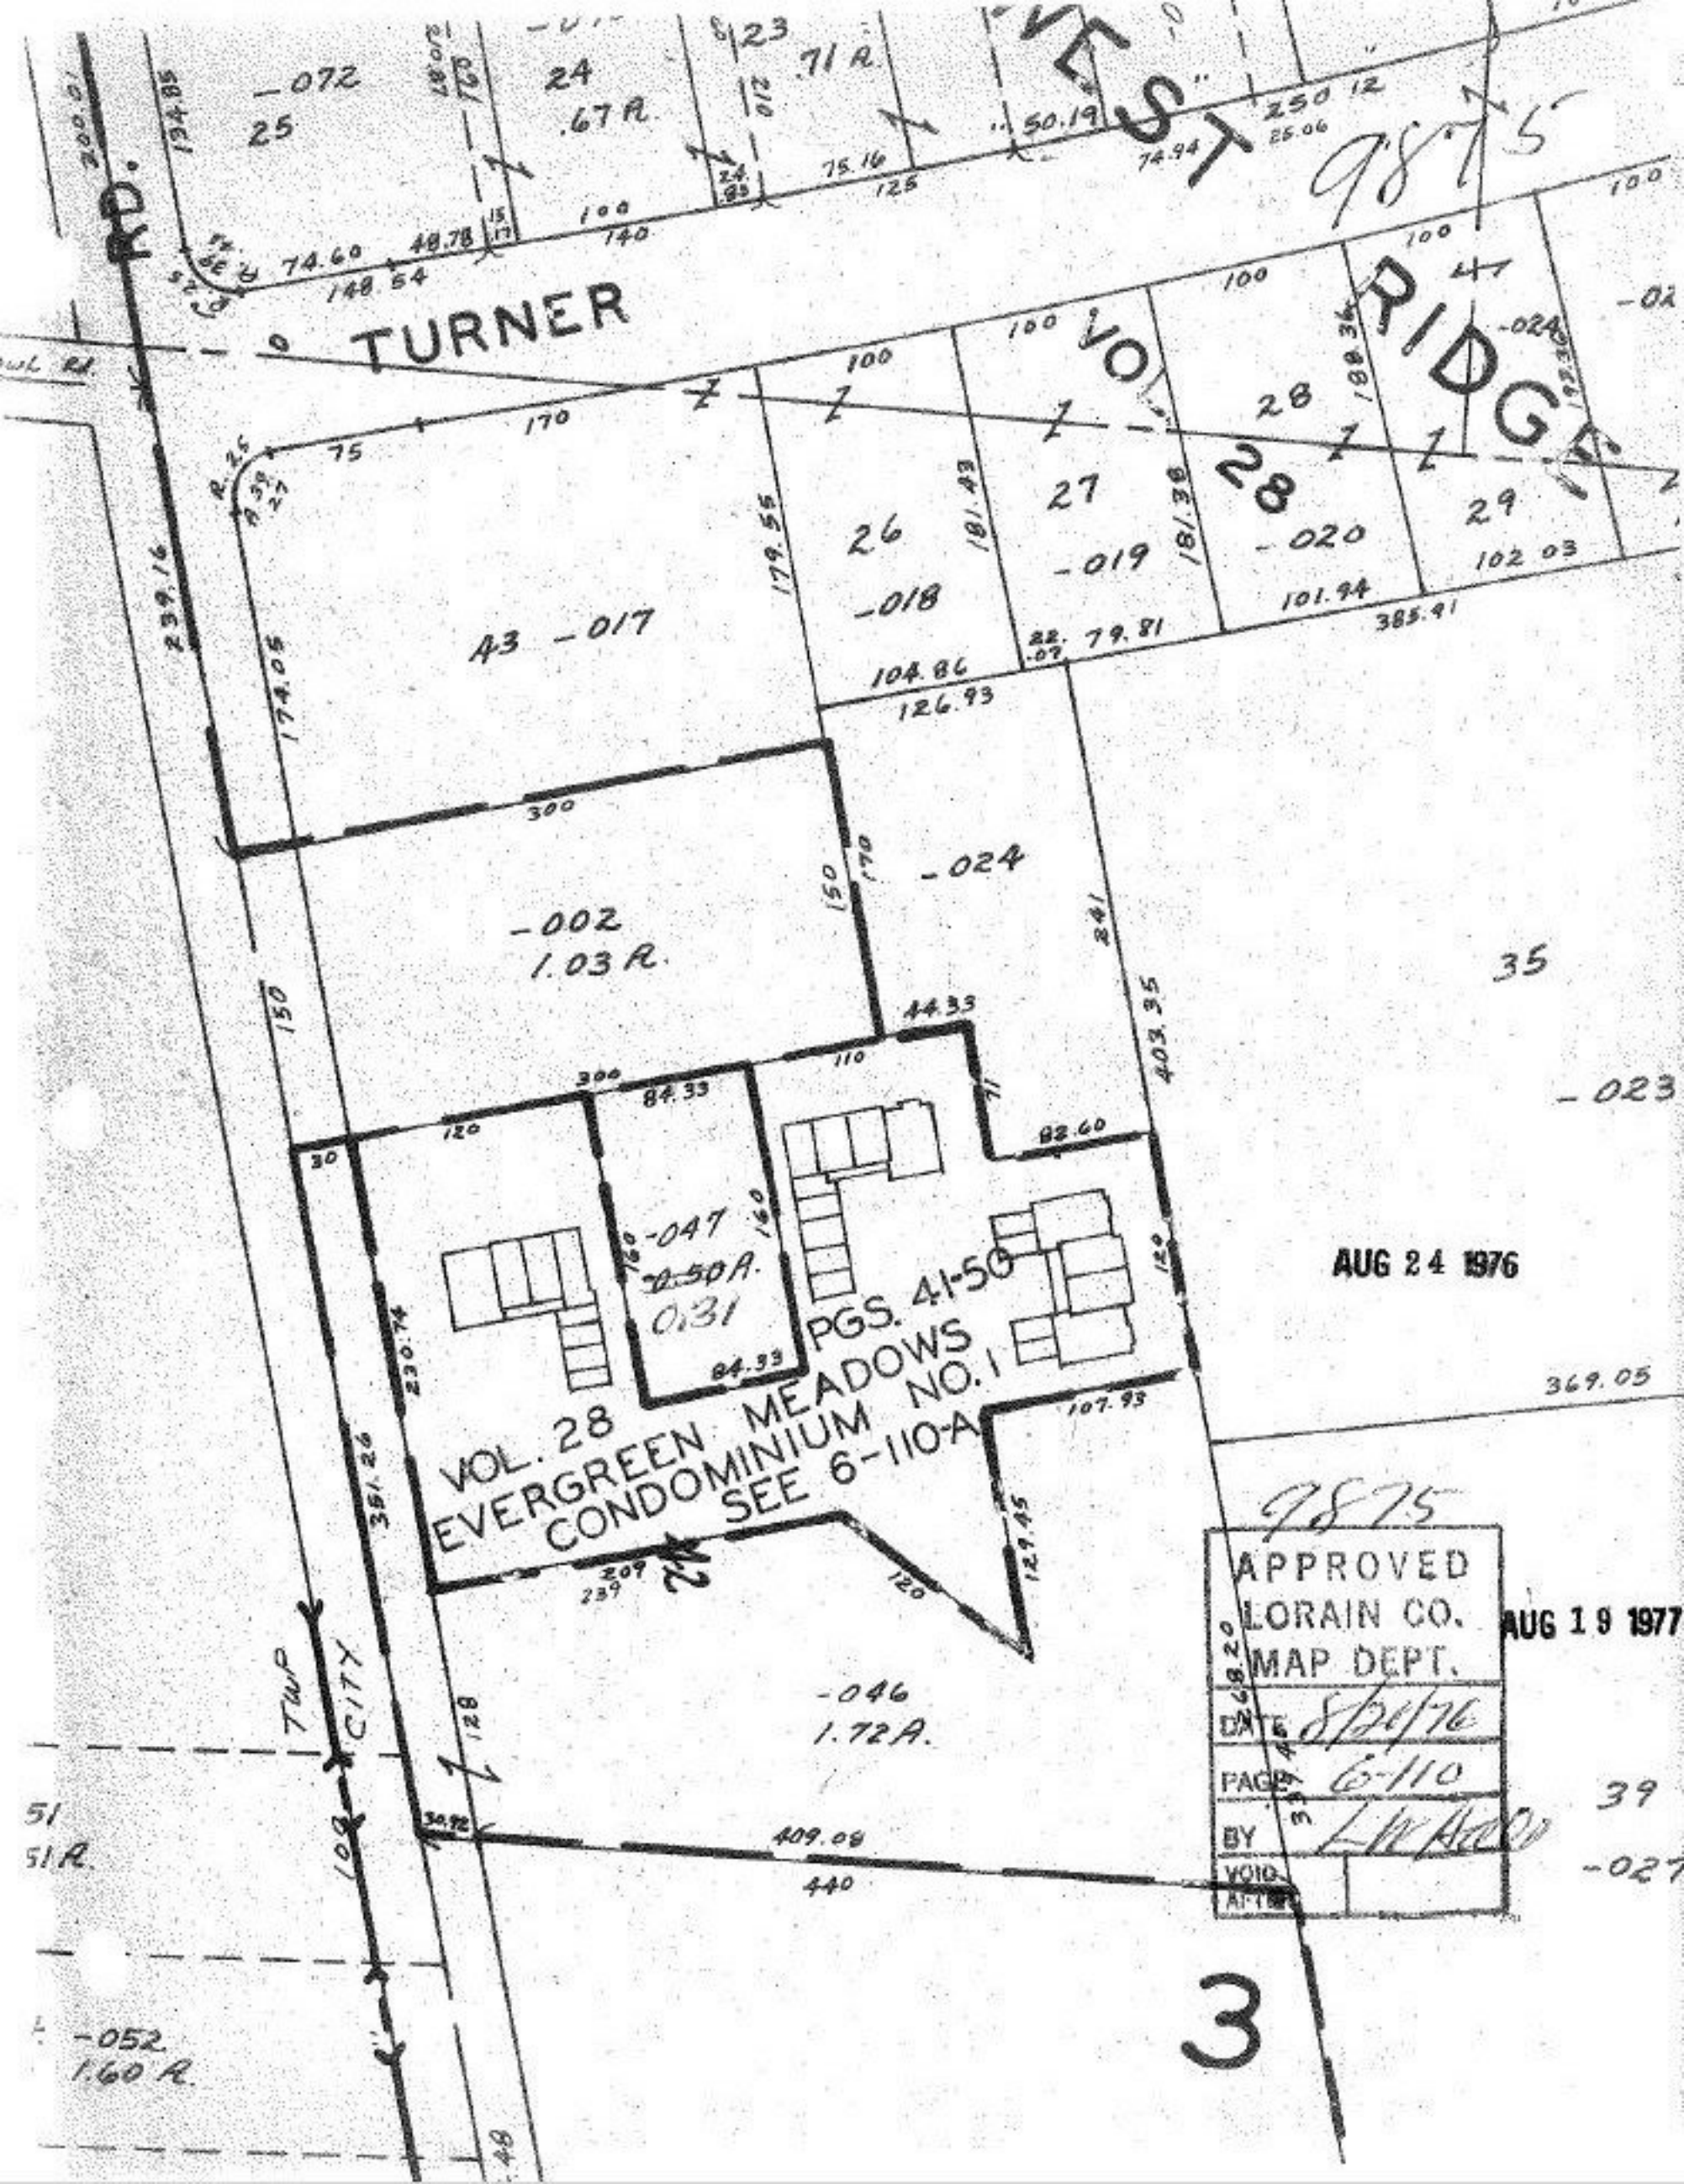

TURNER
RD.
WEST
RIDGE
VOL. 28
-072
25
24
.67 A.
23
.71 A.
9875
43 -017
26
-018
27
-019
28
-020
29
-024
-002
1.03 A.
-047
0.31
PGS. 41-50
VOL. 28
EVERGREEN MEADOWS
CONDOMINIUM NO. 1
SEE 6-110-A
-046
1.72 A.
-052
1.60 A.
TWP
CITY
35
-023
369.05
39
-027
3
AUG 24 1976
9875
APPROVED
LORAIN CO.
MAP DEPT.
DATE 8/26/76
PAGE 6-110
BY
VOID
AFTER
AUG 19 1977