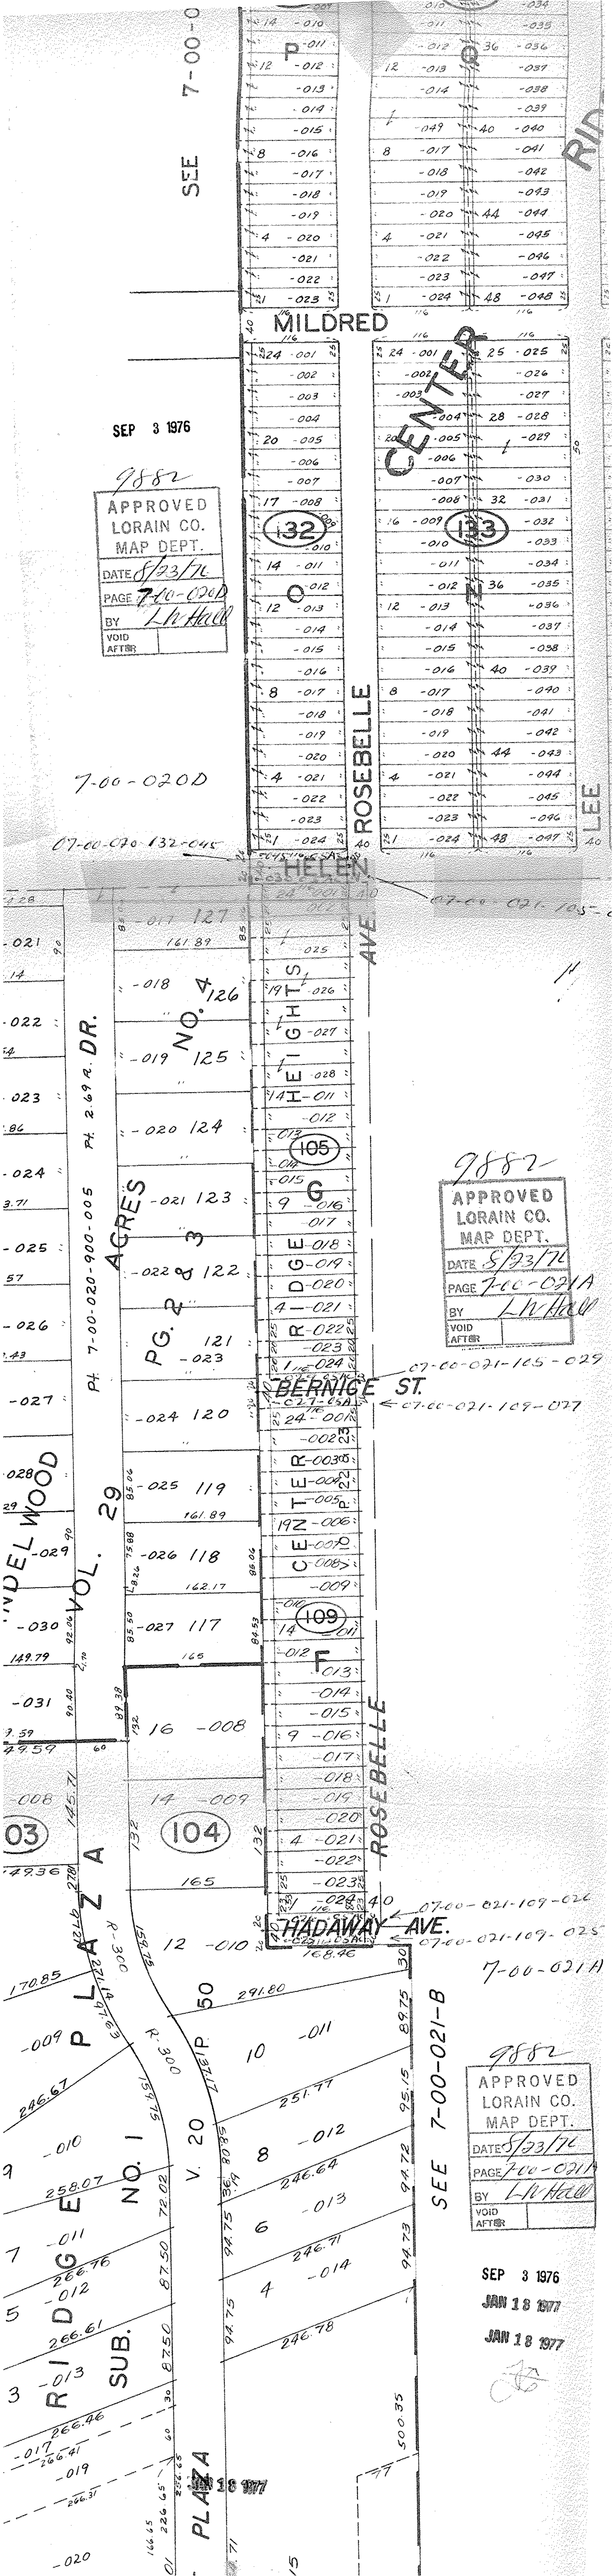
SEE 7-00-0
MILDRED
CENTER
ROSEBELLE
HELEN
LEE
RIDGE HEIGHTS
BERNICE ST.
HADAWAY AVE.
ROSEBELLE
PLAZA
RIDGE SUB. NO. 1
V. 20 P. 50
SEE 7-00-021-B
PLAZA
INDELWOOD
VOL. 29
PG. 2 & 3
ACRES
NO. 4
DR.
Pt. 7-00-020-900-005
Pt. 2.69 A.
7-00-020D
07-00-020-132-045
07-00-021-105-029
07-00-021-109-027
07-00-021-109-026
07-00-021-109-025
7-00-021A
SEP 3 1976
9882
APPROVED
LORAIN CO.
MAP DEPT.
DATE 8/23/76
PAGE 7-00-020D
BY L.W. Hall
VOID AFTER
9882
APPROVED
LORAIN CO.
MAP DEPT.
DATE 8/23/76
PAGE 7-00-021A
BY L.W. Hall
VOID AFTER
9882
APPROVED
LORAIN CO.
MAP DEPT.
DATE 8/23/76
PAGE 7-00-021A
BY L.W. Hall
VOID AFTER
SEP 3 1976
JAN 18 1977
JAN 18 1977
JAN 18 1977