PARENT PARCEL: 18-00-021-103-024
CHILD PARCEL: XX-XX-XXX-XXX-XXX
STARTING POINT: CL OF ST. RT. 58 & CL OF HAMILTON ST.

NO. 00001-D

DEPTH CORRECTION

18-00-021-103-024
~~66 X 206~~
66 X 204.42
AC. CORR. PER SURV.
THOMAS A. SIMON

N
W E
S

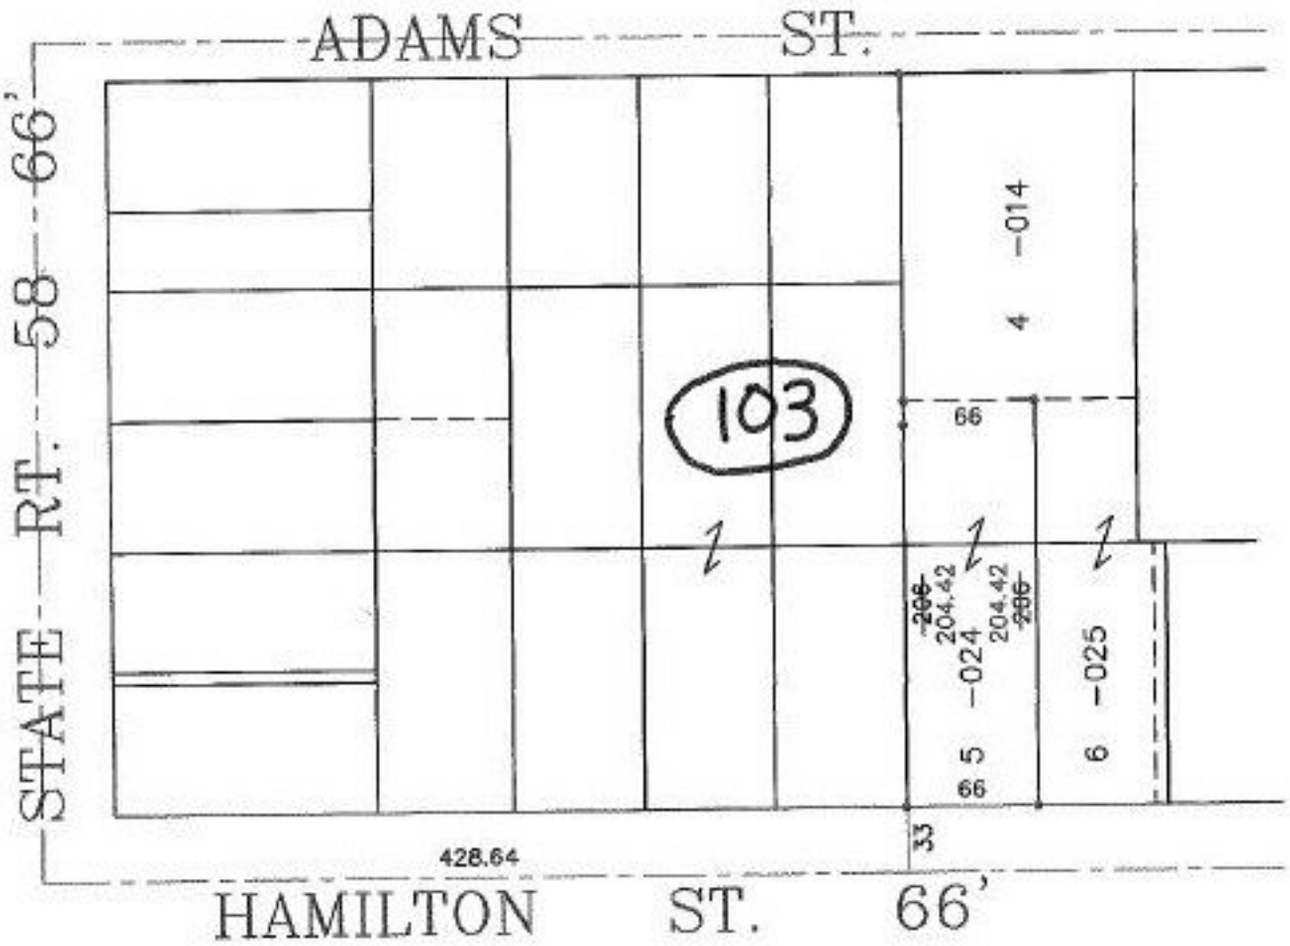

SPLITS/DEEDS PROCESSED
LORAIN COUNTY TAX MAP DEPARTMENT
226 MIDDLE AVE. ELYRIA, OHIO

SURVEYED BY: THOMAS A. SIMON
CLOSURE: 0.00 : 10,000
MAP PAGE(S): 18-00-021-C
APPROVED BY: TJS DATE: 02/02/99
SCALE: 1"= 100 PRIOR INSTRUMENT: DV XXXX/XXX