PARENT PARCEL: 18-00-027-106-013, -014, -015, & -027
CHILD PARCEL: XXXXXXXXXXX
STARTING POINT: S.E. LINE OF RAILROAD ST. & N.E. LINE OF ALLEY

NO. 00004-D

N
W E
S

DEED CHECK

DEED 1: 18-00-027-106-014 & -015 OR 1056/361
UPDATE LEGAL

DEED 1: 18-00-027-106-013 & -027 OR 1045/7
UPDATE LEGAL

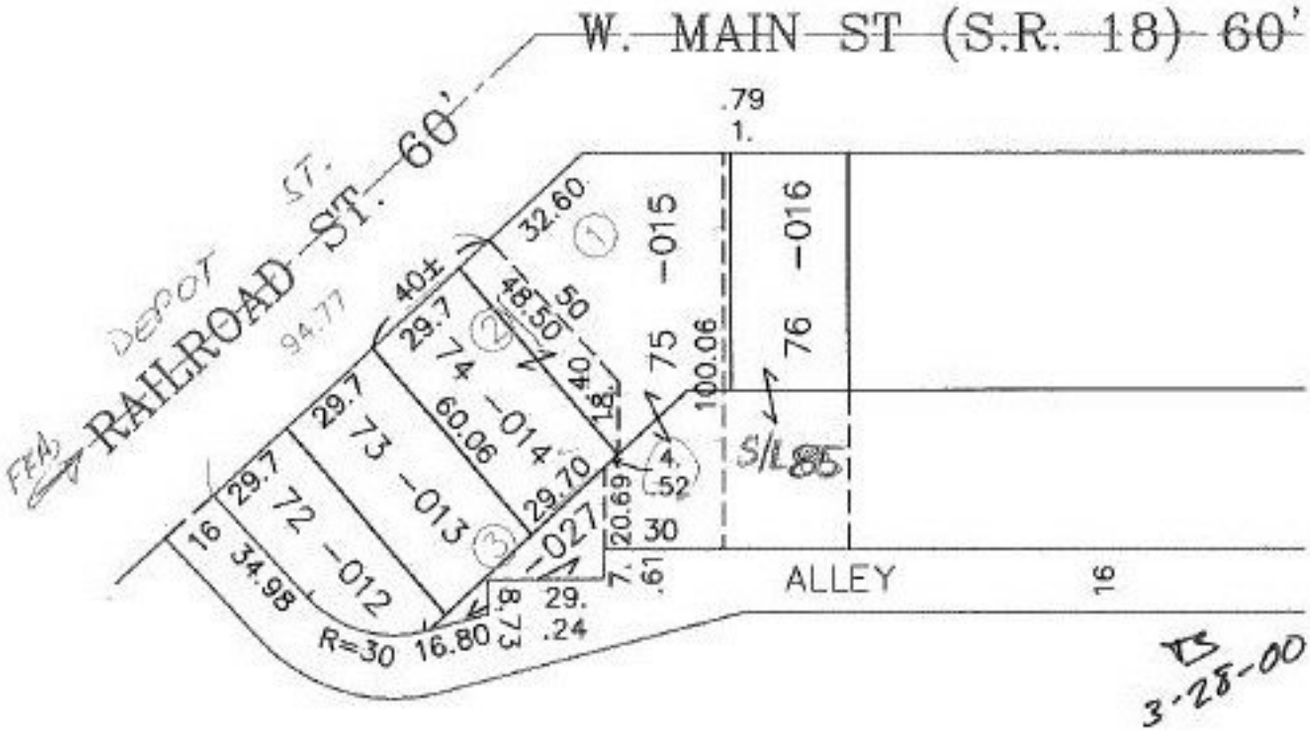

SPLITS/DEEDS PROCESSED
LORAIN COUNTY TAX MAP DEPARTMENT
226 MIDDLE AVE. ELYRIA, OHIO

SURVEYED BY: NONE
CLOSURE: 2.95 : 10,000
MAP PAGE(S): 18-00-027-B
APPROVED BY: TJS DATE: 02/17/99
SCALE: 1"= 50' PRIOR INSTRUMENT: OR 35/365