PARENT PARCEL: 08-00-101-000-010, & -023

CHILD PARCEL: 08-00-101-000-027 THRU -029

STARTING POINT: CL OF VERMILION RD. & THE SOUTH LINE OF O.L. 101

NO. 00008

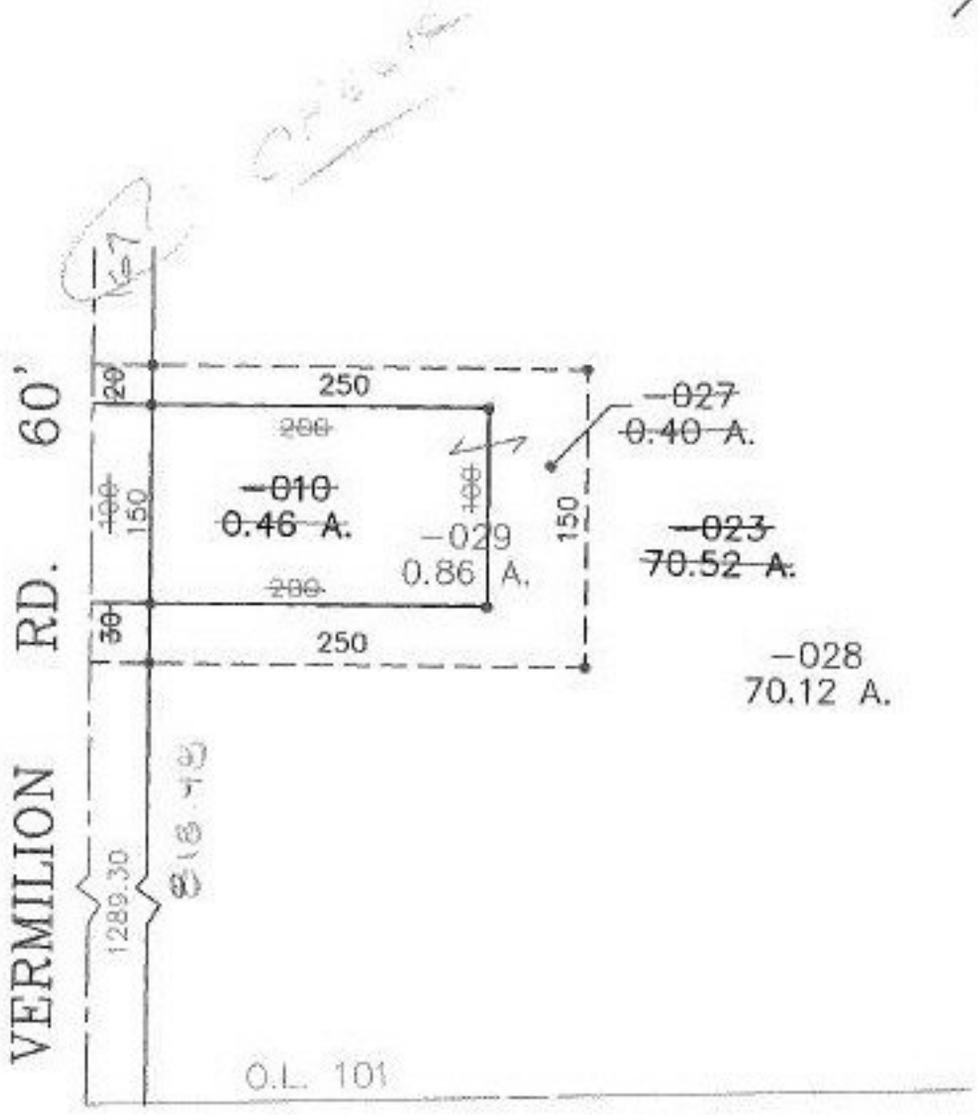

SPLITS/DEEDS PROCESSED

LORAIN COUNTY TAX MAP DEPARTMENT
226 MIDDLE AVE. ELYRIA, OHIO

SURVEYED BY: MICHAEL G. HURA

CLOSURE: 0.00 : 10,000

MAP PAGE(S): 8-C

APPROVED BY: TJS DATE: 02/12/99

SCALE: 1"= 100 PRIOR INSTRUMENT: DV 1148/738