PARENT PARCEL: 02-01-004-105-016, -017, -018, & -019

CHILD PARCEL: 02-01-004-105-033

STARTING POINT: N.W. LINE OF 7th ST. & THE WEST LINE OF A 16' ALLEY

NO. 00013-C

COMBINATION

~~02-01-004-105-016~~
~~25 X 154~~
~~02-01-004-105-017~~
~~50 X 154~~
~~02-01-004-105-018~~
~~25 X 155~~
~~02-01-004-105-019~~
~~25 X 155~~

02-01-004-105-033
125 X 154.50
COMB. PER DEED
OR 200/434

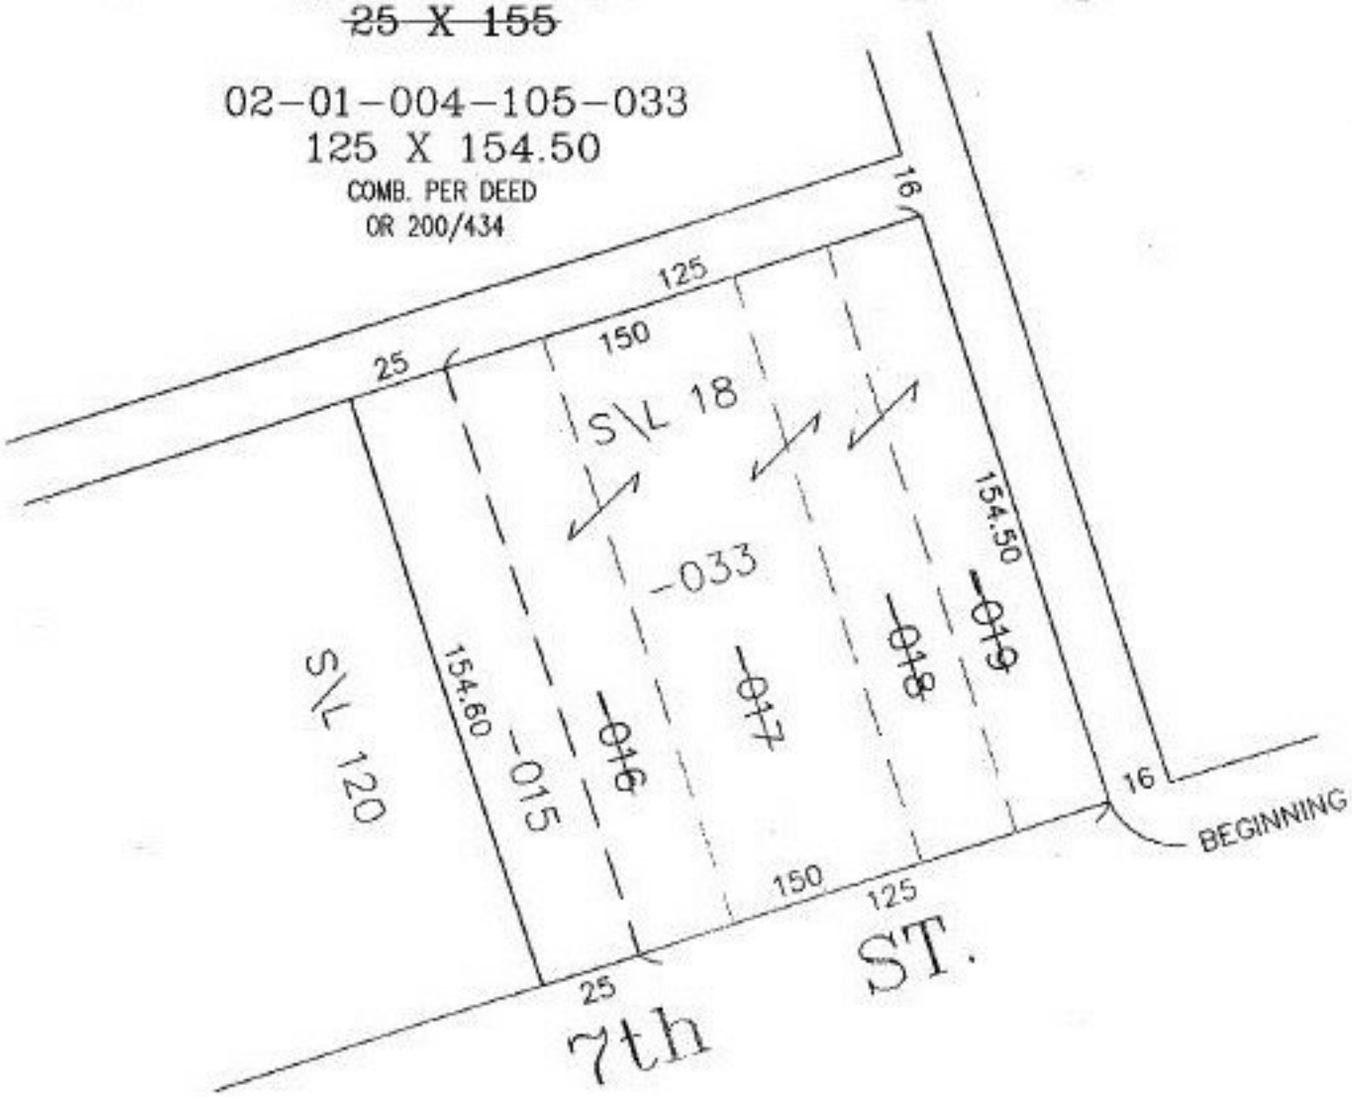

SPLITS/DEEDS PROCESSED

LORAIN COUNTY TAX MAP DEPARTMENT
226 MIDDLE AVE. ELYRIA, OHIO

SURVEYED BY: NONE
CLOSURE: CAN'T RUN
MAP PAGE(S): 02-01-004-B
APPROVED BY: TJS DATE: 03/04/99
SCALE: 1" = 50' PRIOR INSTRUMENT: DV 1257/520