PARENT PARCEL: 07-00-027-107-031, -039 & 07-00-027-109-008

CHILD PARCEL: 07-00-027-107-047 THRU -051, & 07-00-027-109-028

STARTING POINT: DEED 1: S.W. CORNER OF S\L 21 IN THE WESTWOOD ALLOT.

DEED 2: N.W. CORNER OF S\L 35 IN THE WESTWOOD ALLOT.

NO. 00015

N

W E

S

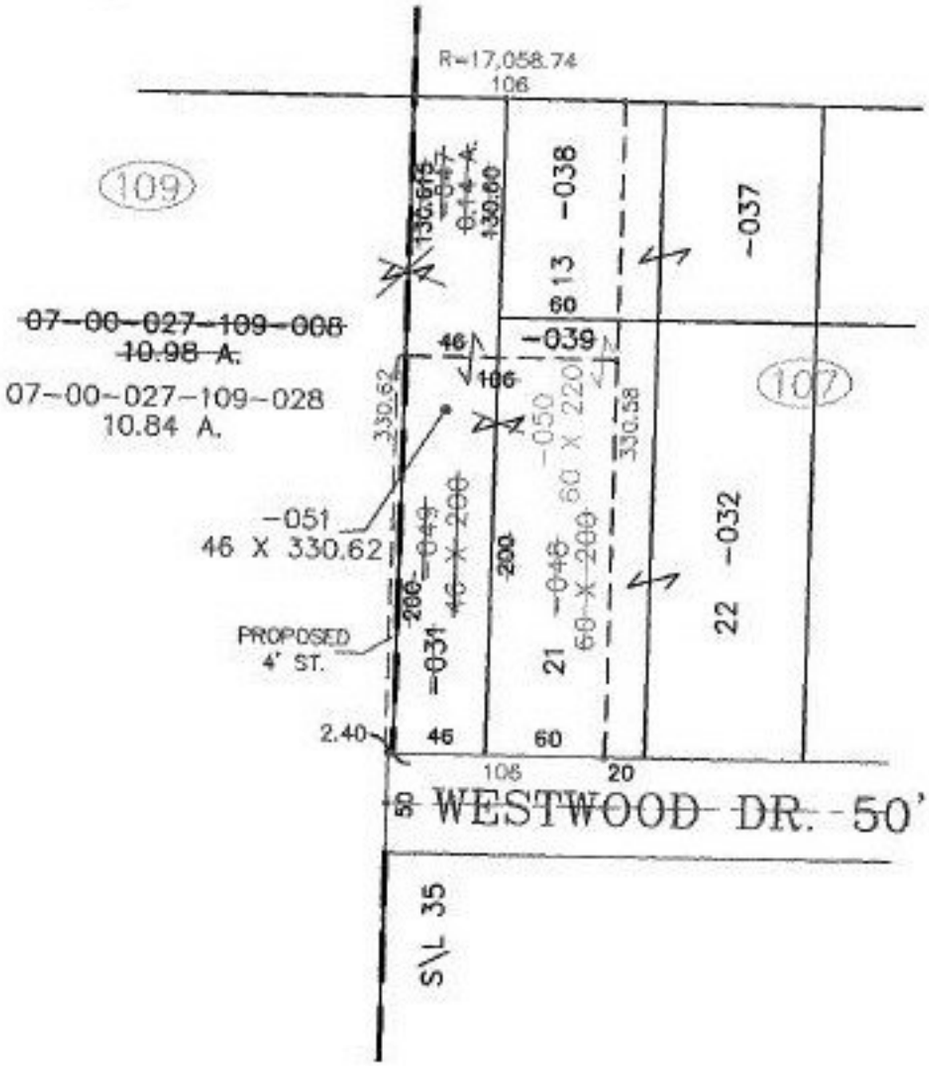

SPLITS/DEEDS PROCESSED

LORAIN COUNTY TAX MAP DEPARTMENT
226 MIDDLE AVE. ELYRIA, OHIO

SURVEYED BY: RODGER G. SIMON

CLOSURE: 0.14 : 10,000

MAP PAGE(S): 07-00-027-0

APPROVED BY: TJS DATE: 02/23/99

SCALE: 1"= 100 PRIOR INSTRUMENT: DV 1420/36