PARENT PARCEL: 05-00-090-000-003

CHILD PARCEL: 05-00-090-000-005 THRU -009

STARTING POINT: I.P. MON. AT CL OF ALBRECHT RD. & CL OF FOWL RD.

NO. 00017

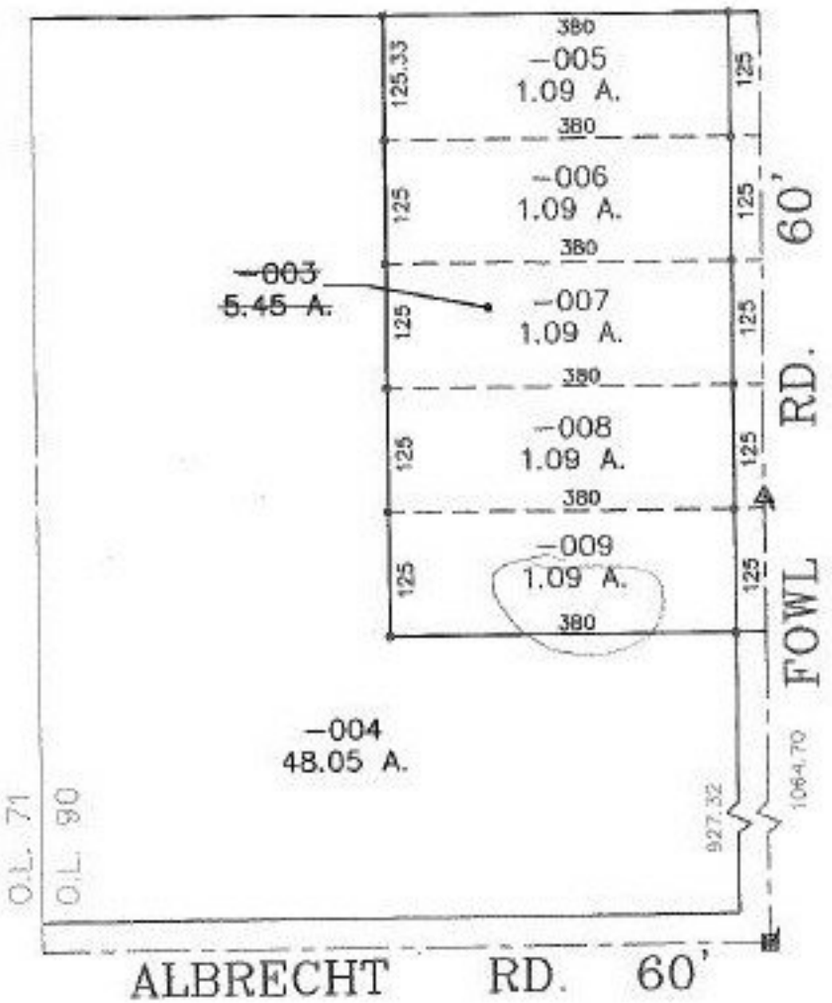

SPLITS/DEEDS PROCESSED

LORAIN COUNTY TAX MAP DEPARTMENT
226 MIDDLE AVE. ELYRIA, OHIO

SURVEYED BY: JOHN POZYWAK

CLOSURE: 0.02 : 10.000

MAP PAGE(S): 5-H

APPROVED BY: TJS DATE: 02/26/99

SCALE: 1"= 200 PRIOR INSTRUMENT: 980555144