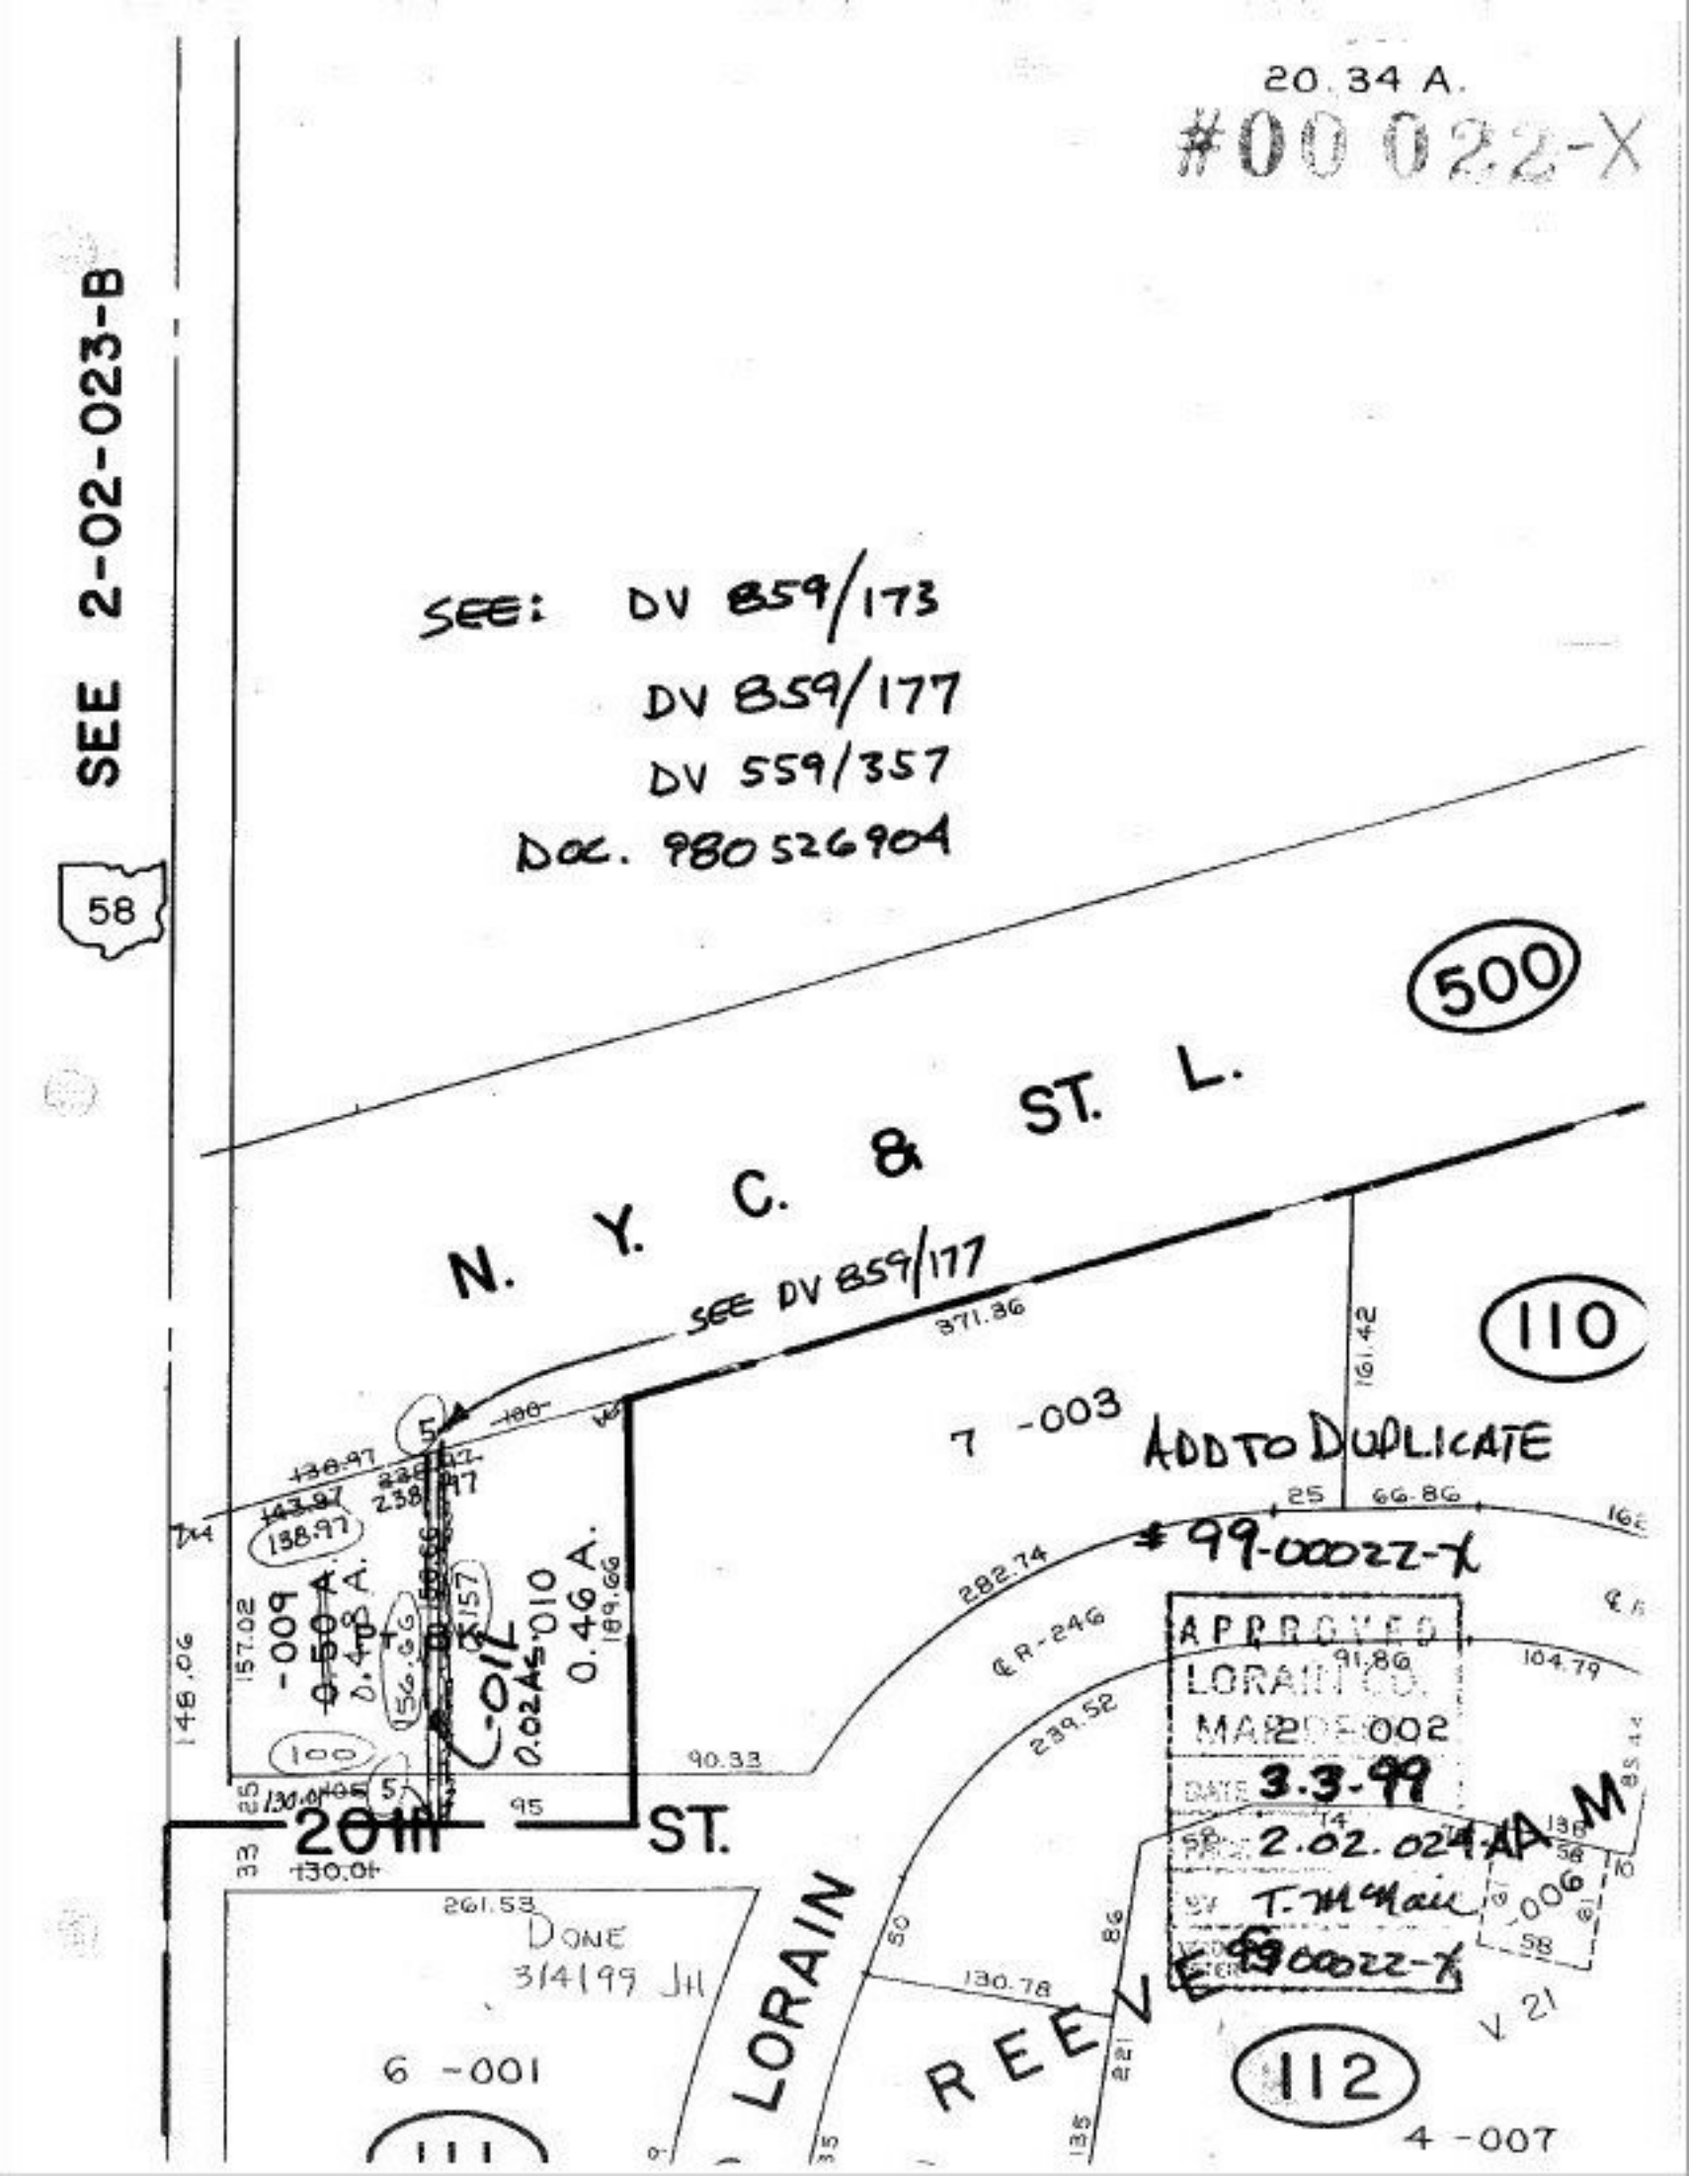
20.34 A.
#00022-X
SEE 2-02-023-B
58
SEE: DV 859/173
DV 859/177
DV 559/357
DOC. 980526904
N. Y. C. & ST. L.
500
SEE DV 859/177
110
7 -003
ADD TO DUPLICATE
#99-00022-X
APPROVED
LORAIN CO.
MAR 2000
DATE 3.3-99
2.02.024 AA M
BY T. McMain
#99-00022-X
-009 0.50 A.
0.48 A.
-010 0.46 A.
0.02 Ac.
C-01L
20TH ST.
LORAIN
REEZ
112
4-007
6 -001
111
DONE
3/4/99 JH
371.36
282.74
239.52
130.78
90.33
95
100
148.06
157.02
189.66
191.42
66.86
91.86
104.79
261.53