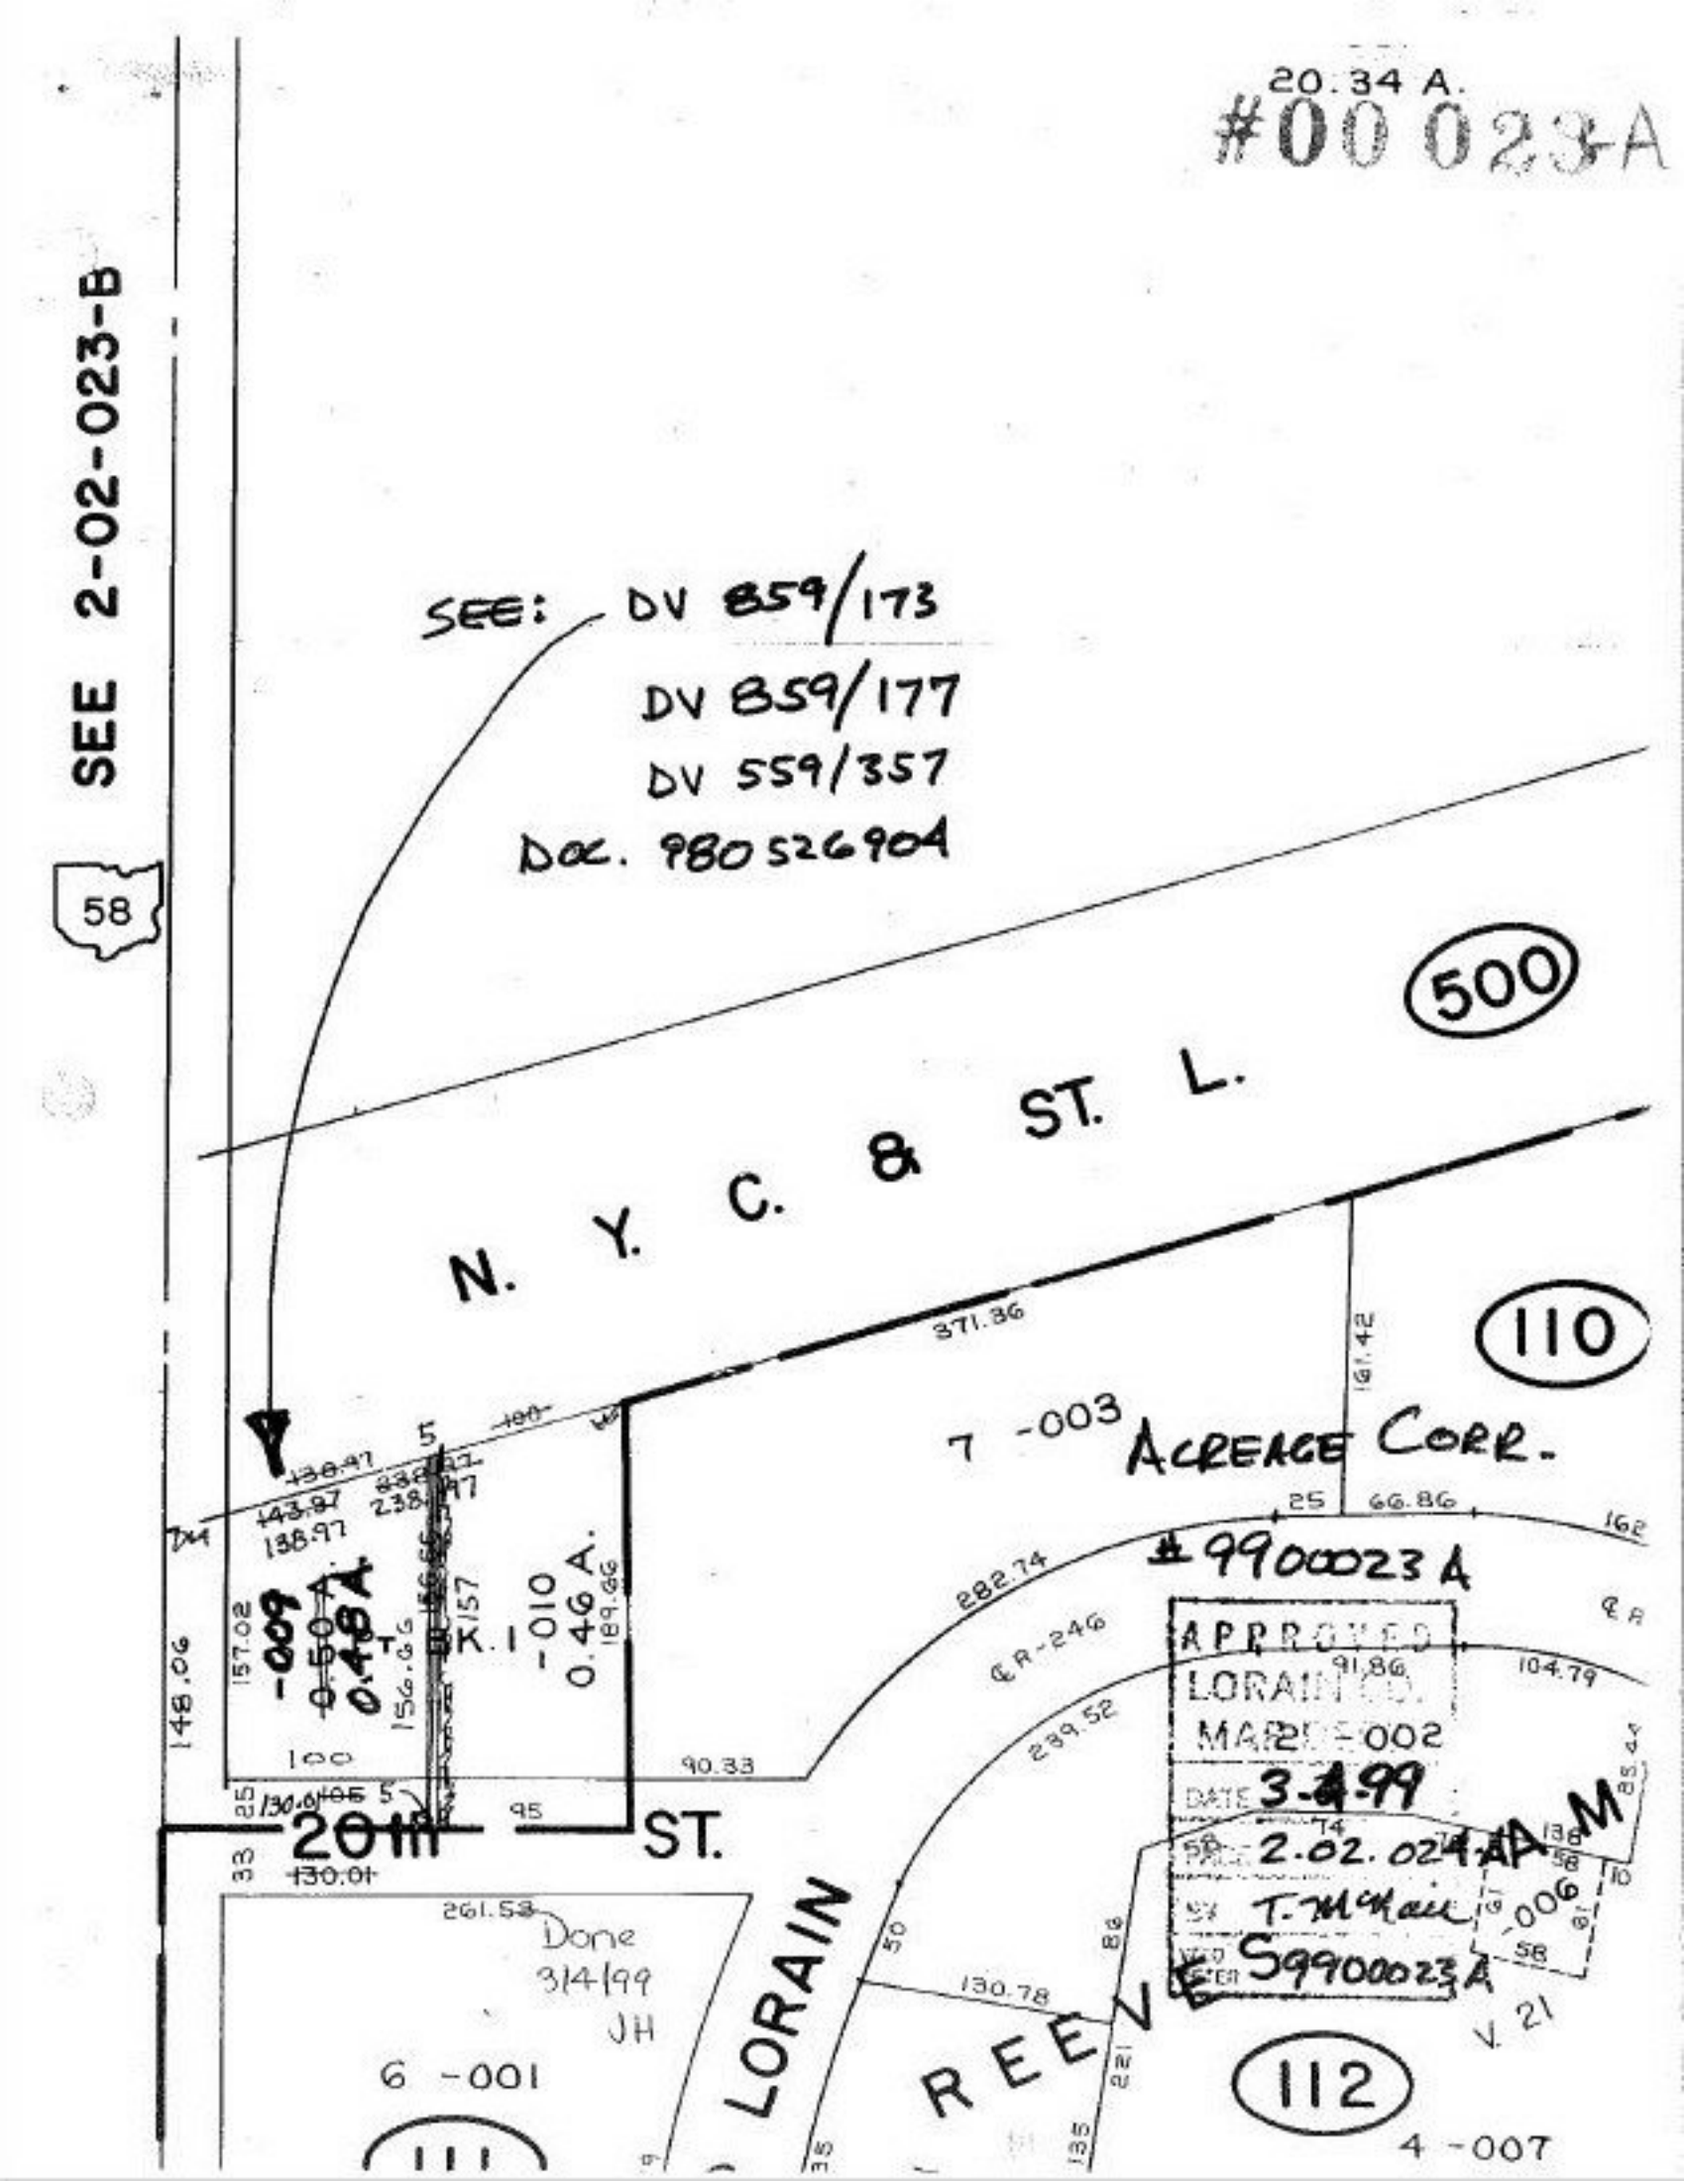
20.34 A.
#00 023-A
SEE 2-02-023-B
58
SEE: DV 859/173
DV 859/177
DV 559/357
DOC. 980526904
500
N. Y. C. & ST. L.
110
371.36
161.42
7 -003
ACREAGE CORR.
25
66.86
162
#9900023 A
282.74
℄ R-246
91.86
104.79
239.52
148.06
157.02
-009
0.50 A.
0.48 A.
156.66
BK. 1
-010
0.46 A.
189.66
100
90.33
130.01
95
20th ST.
261.53
Done
3/4/99
JH
6 -001
111
LORAIN
REEVE
130.78
221
135
112
4 -007
V. 21
-006
APPROVED
LORAIN CO.
MAR 2 -002
DATE 3-4-99
PAGE 2.02.024 A.M.
BY T. McKain
VOID
S9900023A