PARENT PARCEL: 20-05-009-000-009
CHILD PARCEL: 20-05-009-000-041 THRU -043
STARTING POINT: MON. BOX. CL OF QUARRY RD. & CL OF BURSLEY

NO. 00024

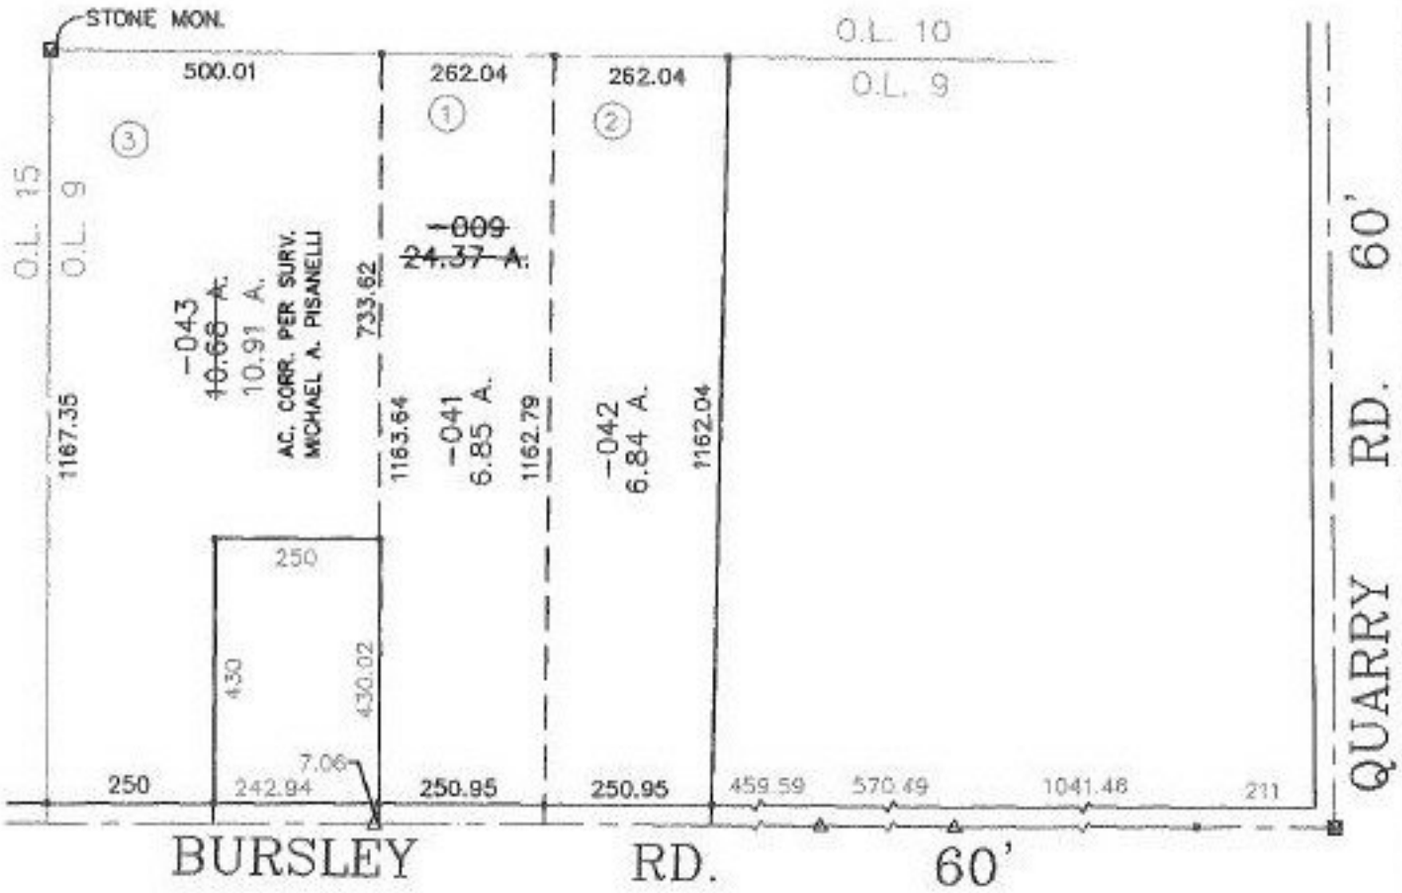

SPLITS/DEEDS PROCESSED
LORAIN COUNTY TAX MAP DEPARTMENT
226 MIDDLE AVE. ELYRIA, OHIO

SURVEYED BY: MICHAEL A. PISANELLI
CLOSURE: 0.03 : 10,000
MAP PAGE(S): 20-D
APPROVED BY: TJS DATE: 03/08/99
SCALE: 1" = 300 PRIOR INSTRUMENT: OR 454/204