PARENT PARCEL: 15-00-050-000-004
CHILD PARCEL: 16-00-042-000-007
STARTING POINT: S.W. CORNER OF O.L. 42 IN GRAFTON TWP.

NO. 00055-X

MAP CORRECTION ONLY

CORRECTIONS PER DEEDS
OR 1125/83
&
OR 626/282

2-21-00

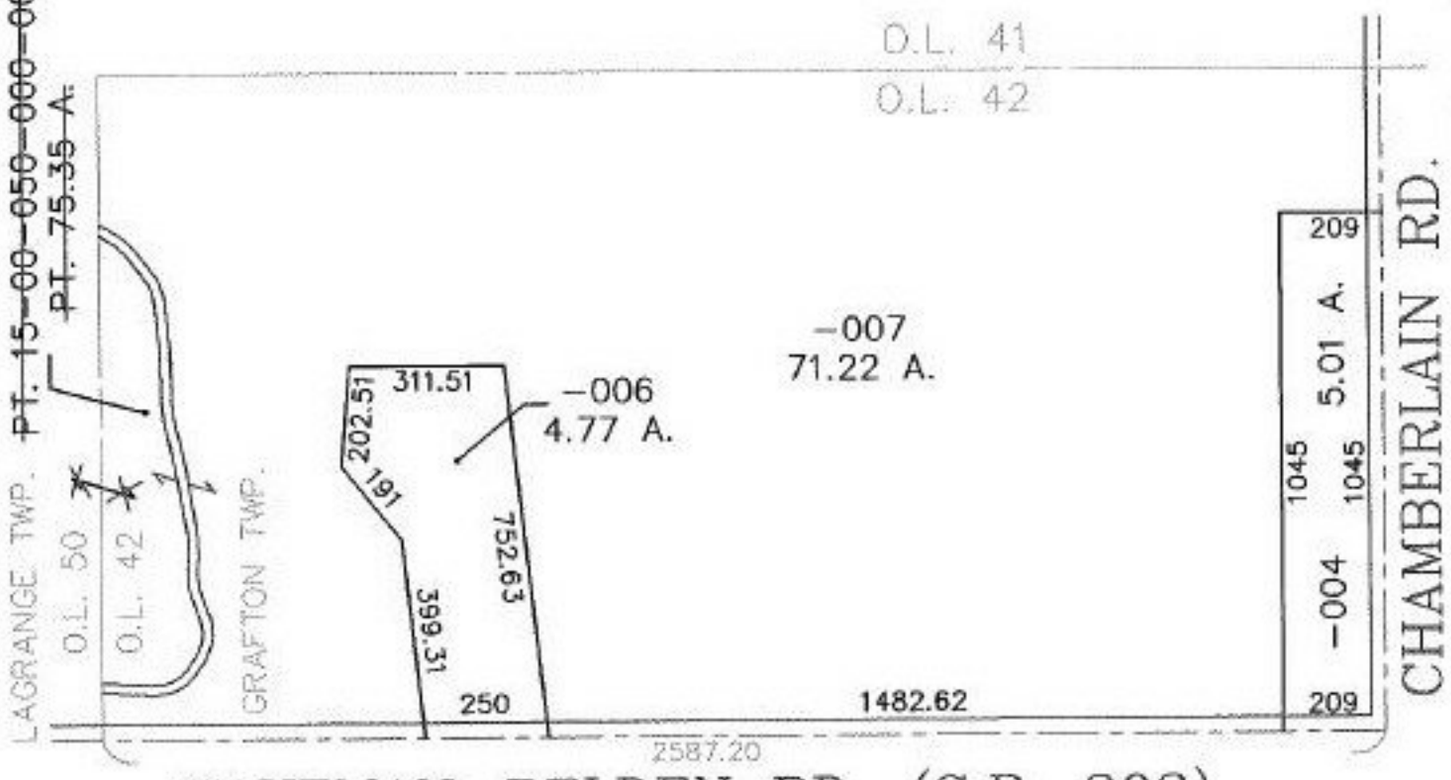

WAKEMAN-BELDEN RD. (S.R. 303)

PRIOR INSTRUMENT: OR 1125/83
PRIOR INSTRUMENT: OR 626/282

SPLITS/DEEDS PROCESSED
LORAIN COUNTY TAX MAP DEPARTMENT
226 MIDDLE AVE. ELYRIA, OHIO

SURVEYED BY: NONE
CLOSURE: CAN'T RUN
MAP PAGE(S): 15-D & 16-A
APPROVED BY: TJS DATE: 05/04/99
SCALE: 1"= 400