PARENT PARCEL: XX-XX-XXX-XXX-XXX
CHILD PARCEL: XX-XX-XXX-XXX-XXX
STARTING POINT: XXXXXX

NO. 00057-D

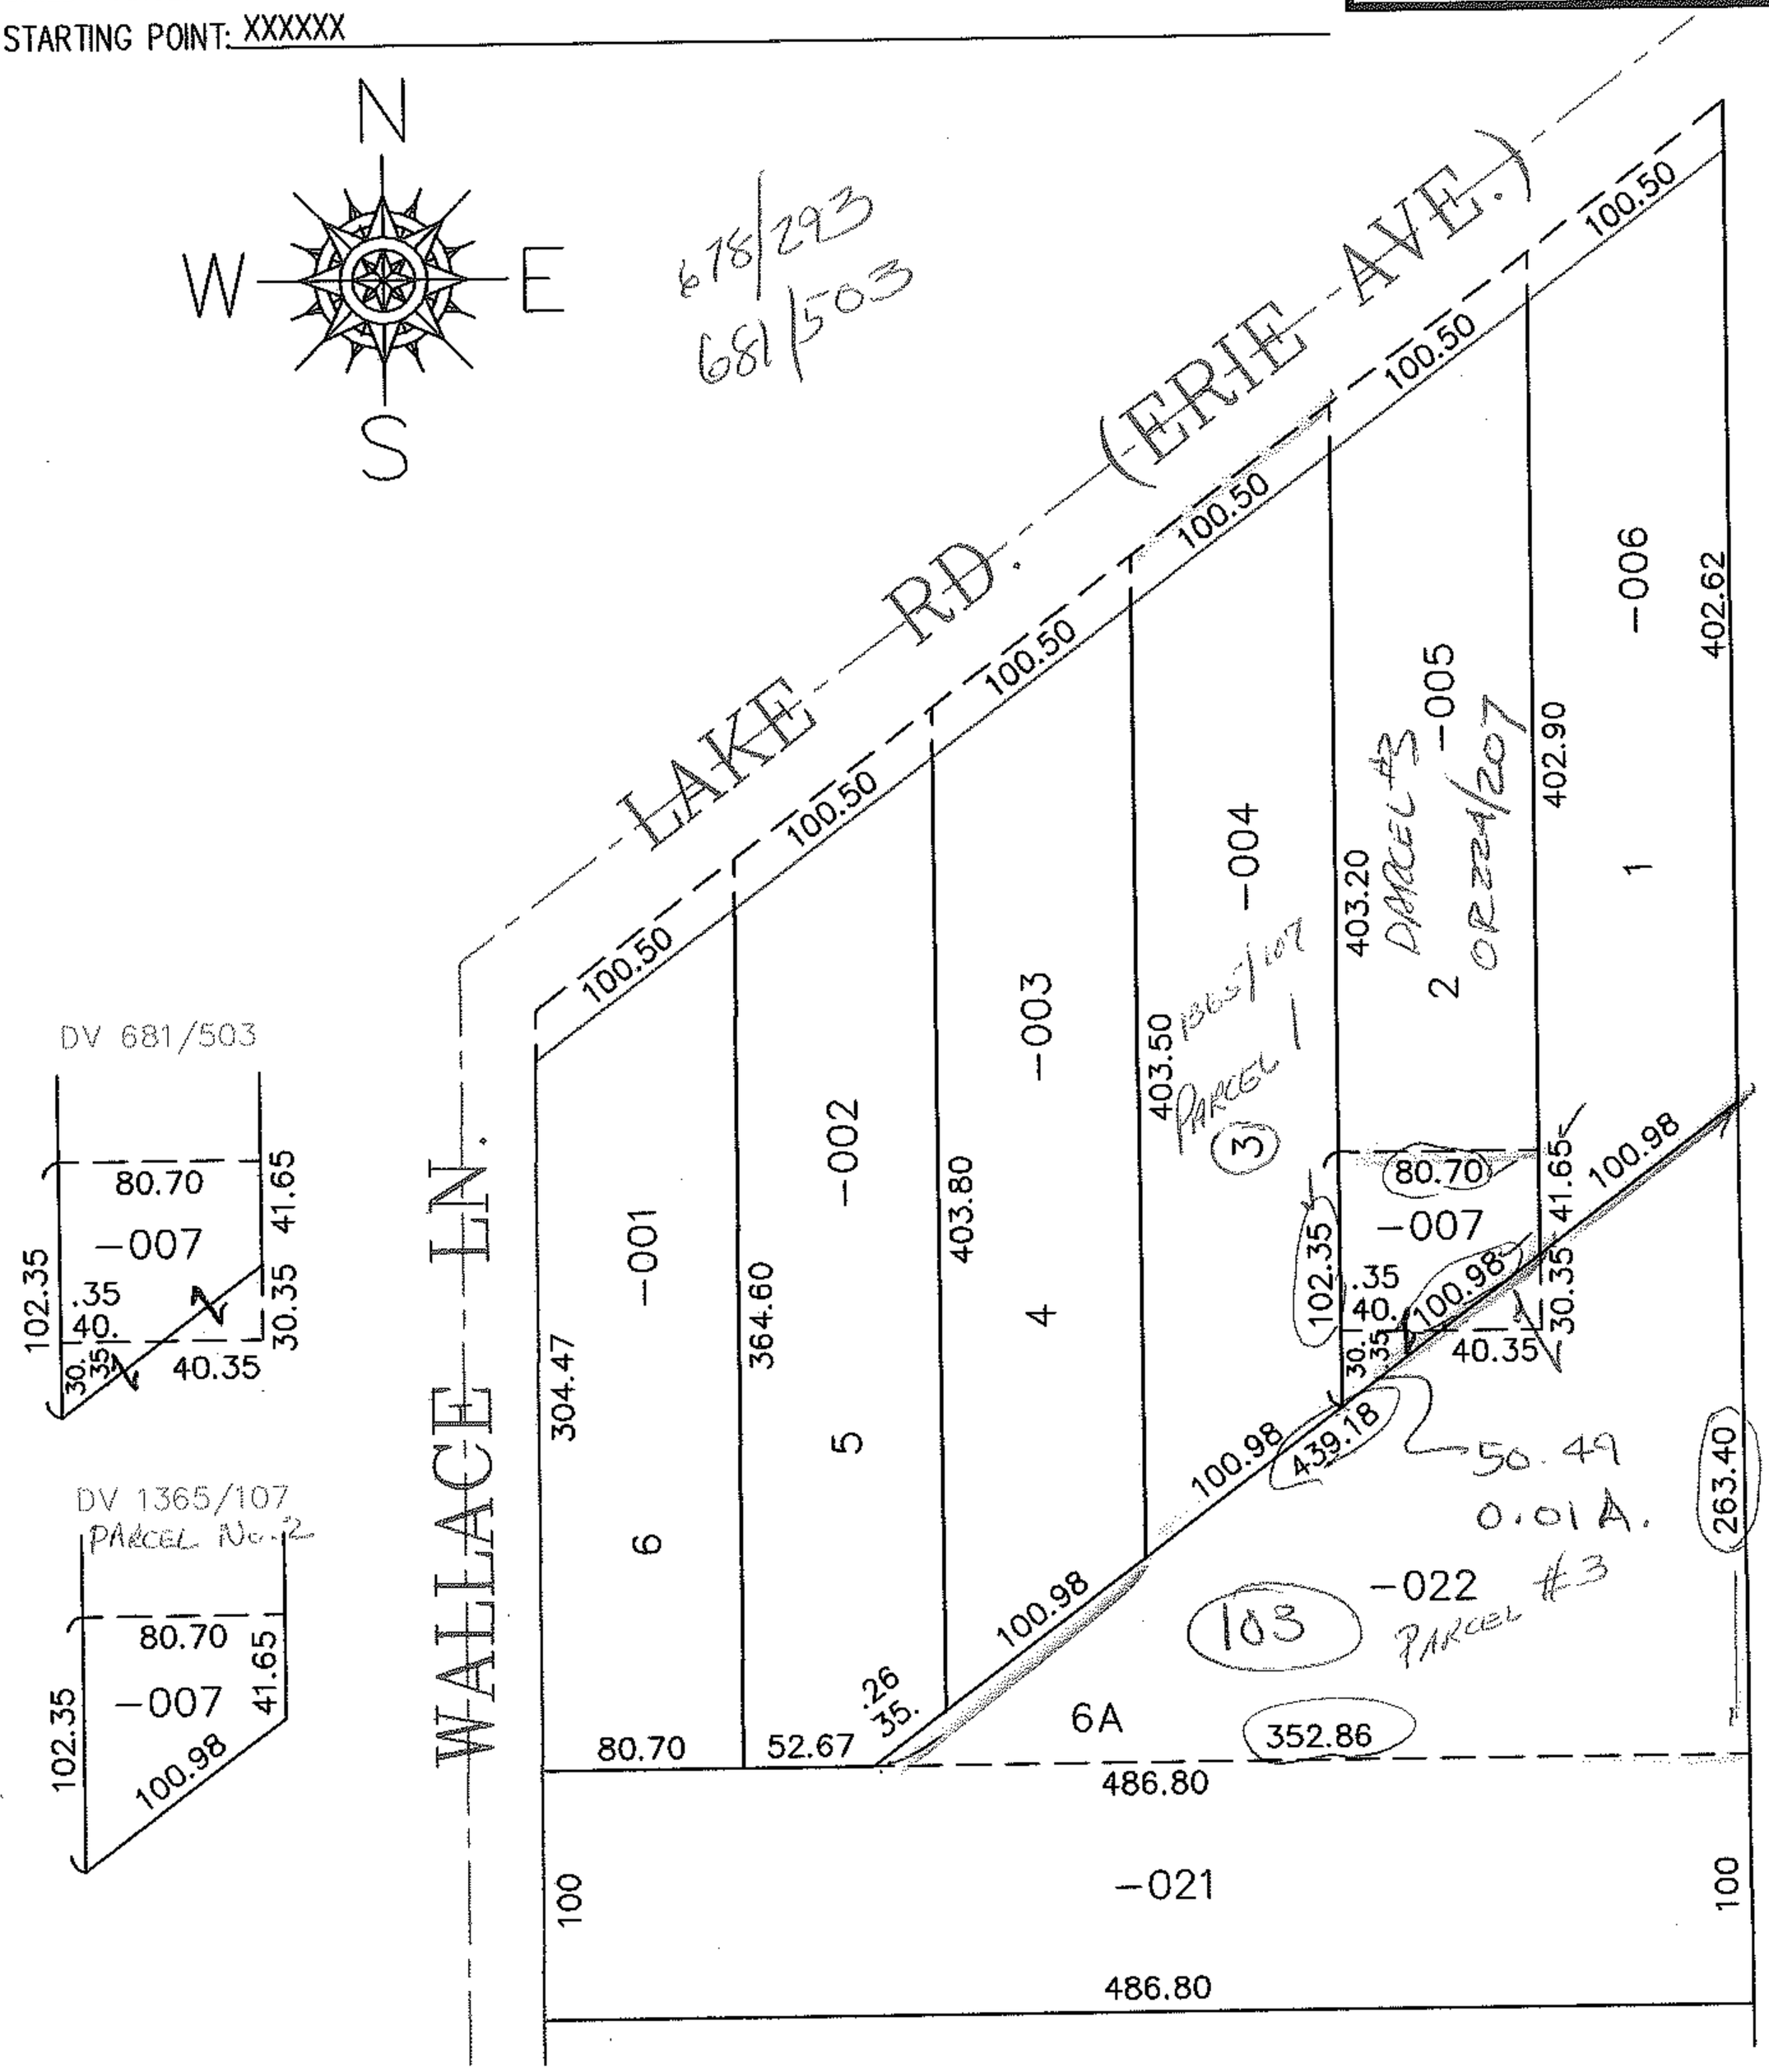

SPLITS/DEEDS PROCESSED

LORAIN COUNTY TAX MAP DEPARTMENT
226 MIDDLE AVE. ELYRIA, OHIO

SURVEYED BY: XXXXXXXXXX
CLOSURE: XXXXXX
MAP PAGE(S): XX-XX-XXX 2-02-022
APPROVED BY: XXX DATE: XX/XX/XX
SCALE: 1"= 100 PRIOR INSTRUMENT: DV XXXX/XXX