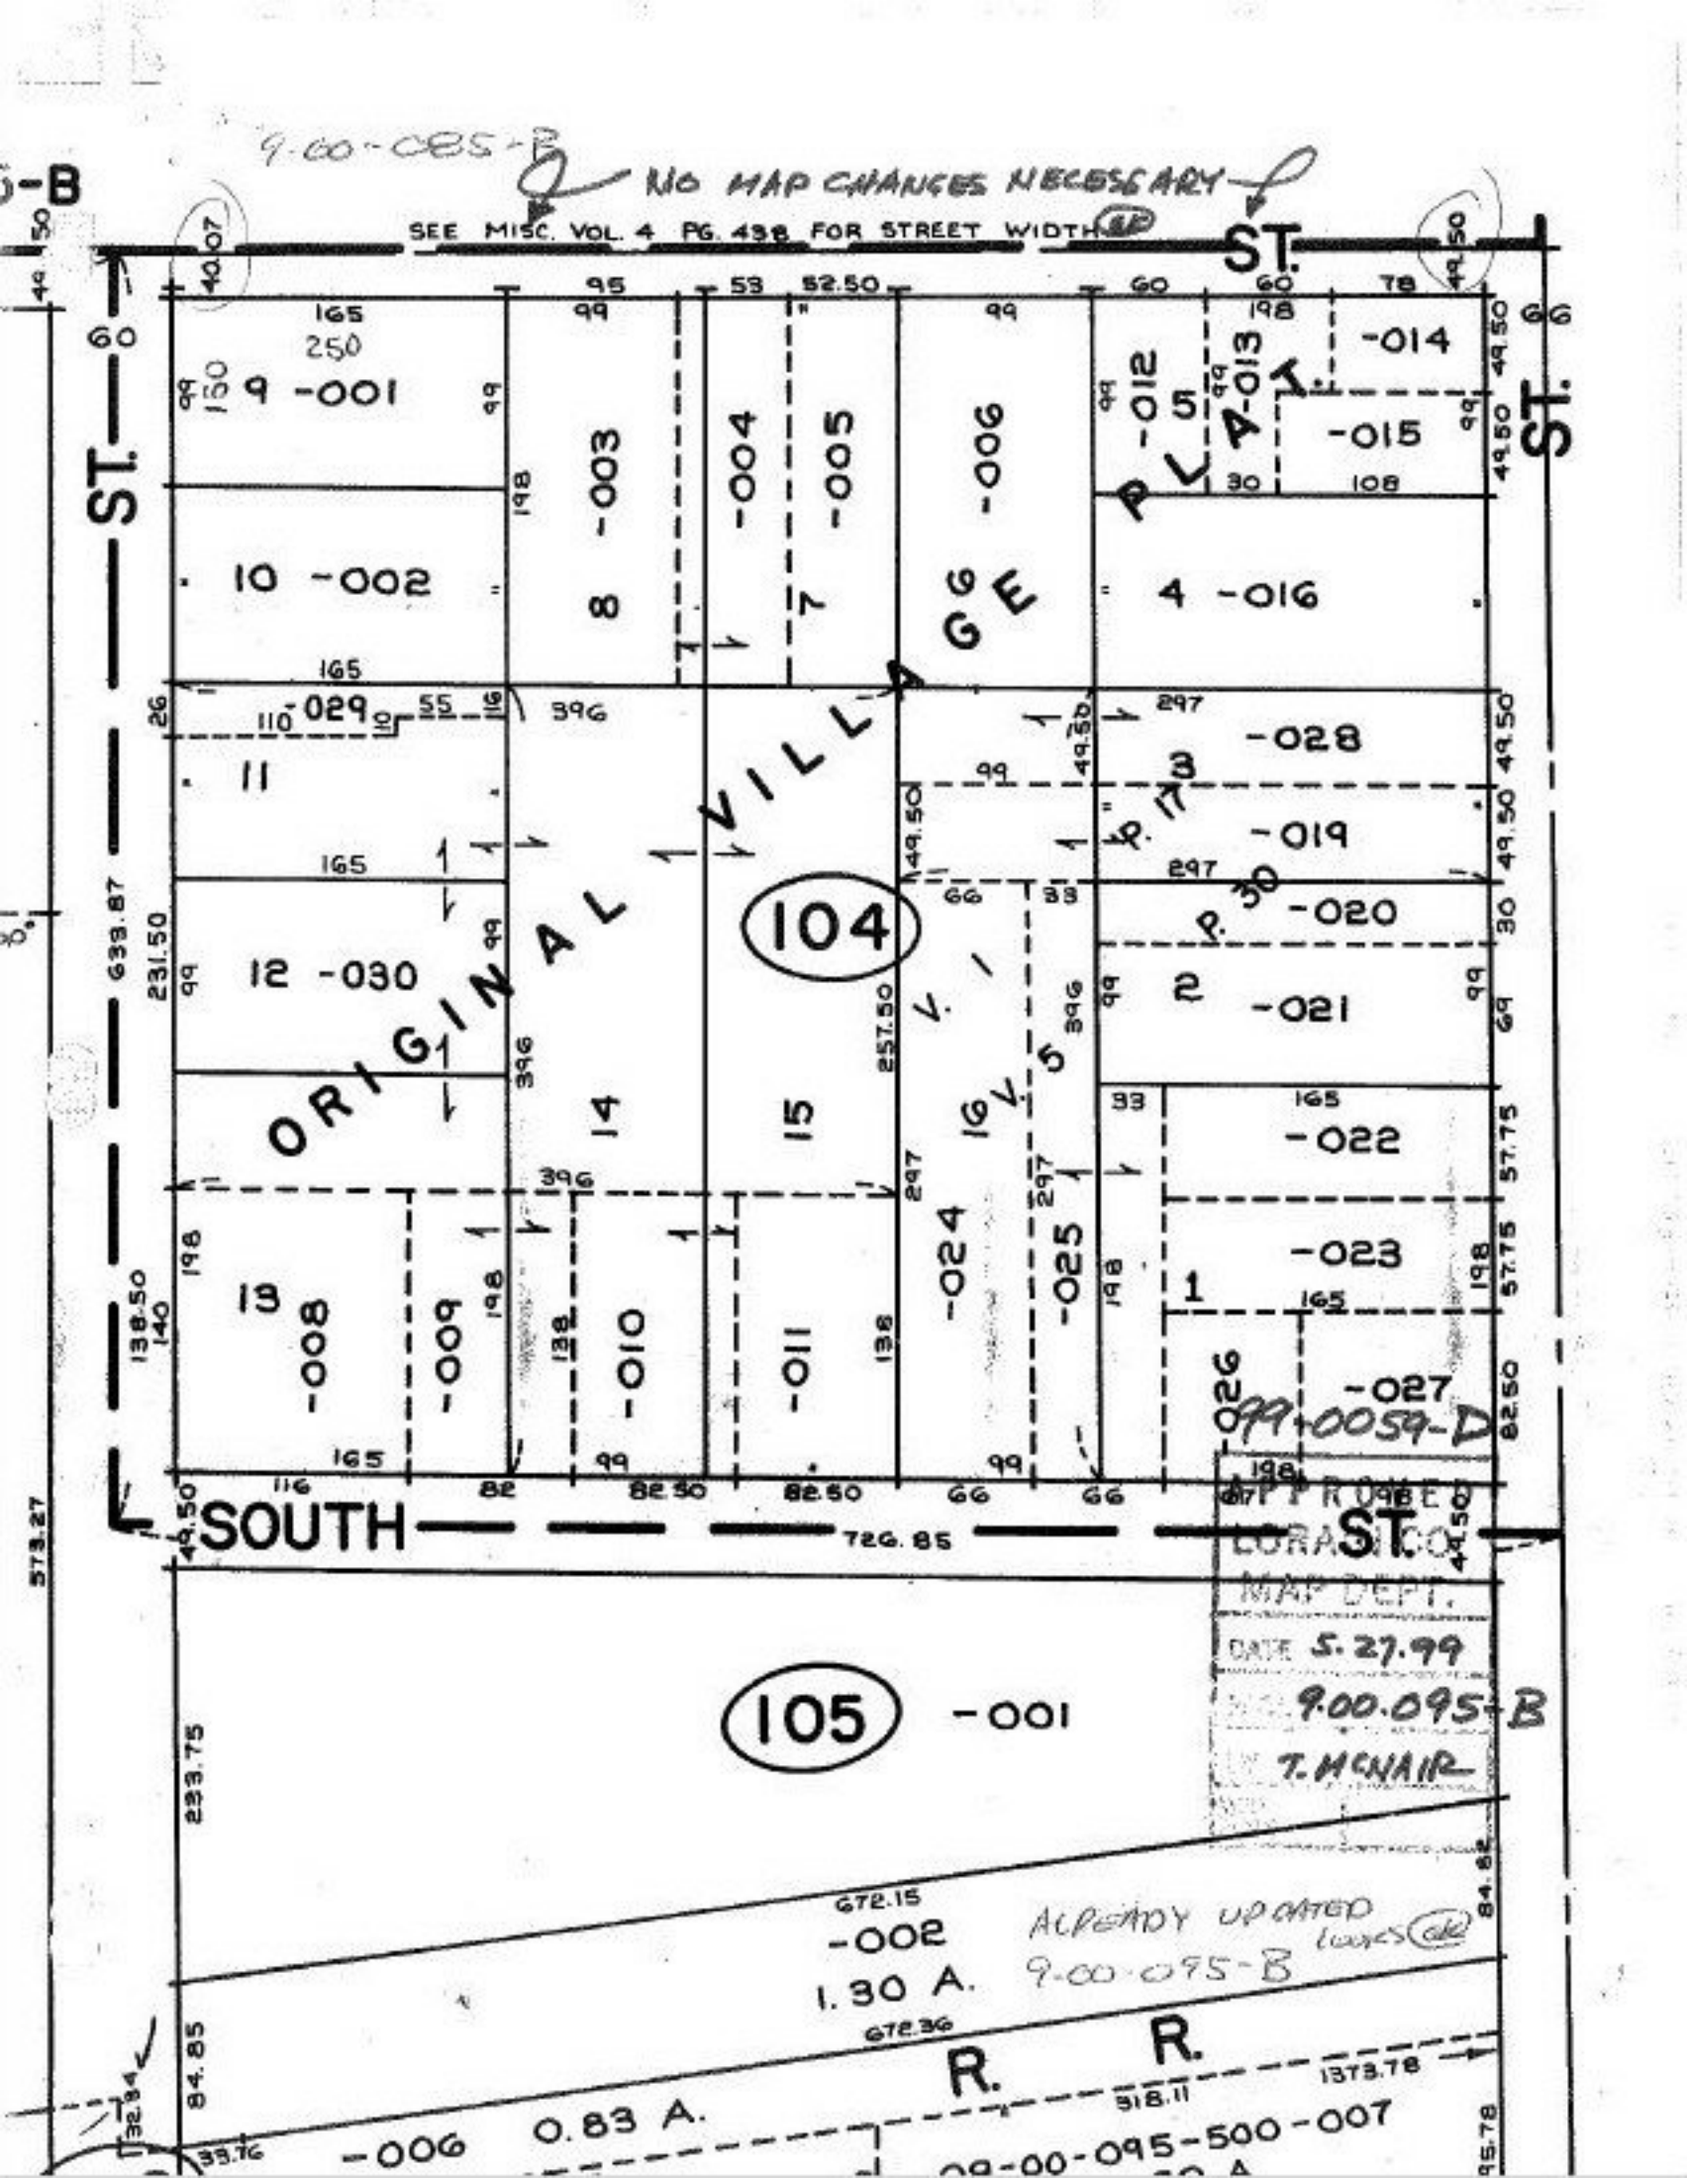
9-00-085-B
NO MAP CHANGES NECESSARY
SEE MISC. VOL. 4 PG. 438 FOR STREET WIDTH
ST.
ST.
ST.
ST.
SOUTH
ORIGINAL VILLAGE
PLAT 5
PLAT 3
PLAT 30
104
105
-001
-002
-003
-004
-005
-006
-008
-009
-010
-011
-012
-013
-014
-015
-016
-019
-020
-021
-022
-023
-024
-025
-026
-027
-028
-029
-030
99-0059-D
PROPER
MAP DEPT.
DATE 5.27.99
9.00.095-B
T. McNAIR
ALREADY UPDATED
9-00-095-B
0.83 A.
1.30 A.
R.
R.
09-00-095-500-007