PARENT PARCEL: 06-24-029-101-085 & -091

CHILD PARCEL: 06-24-029-101-092 THRU -094

STARTING POINT: C/Ls WEST RIVER ROAD & DAVID DRIVE

NO. 00060

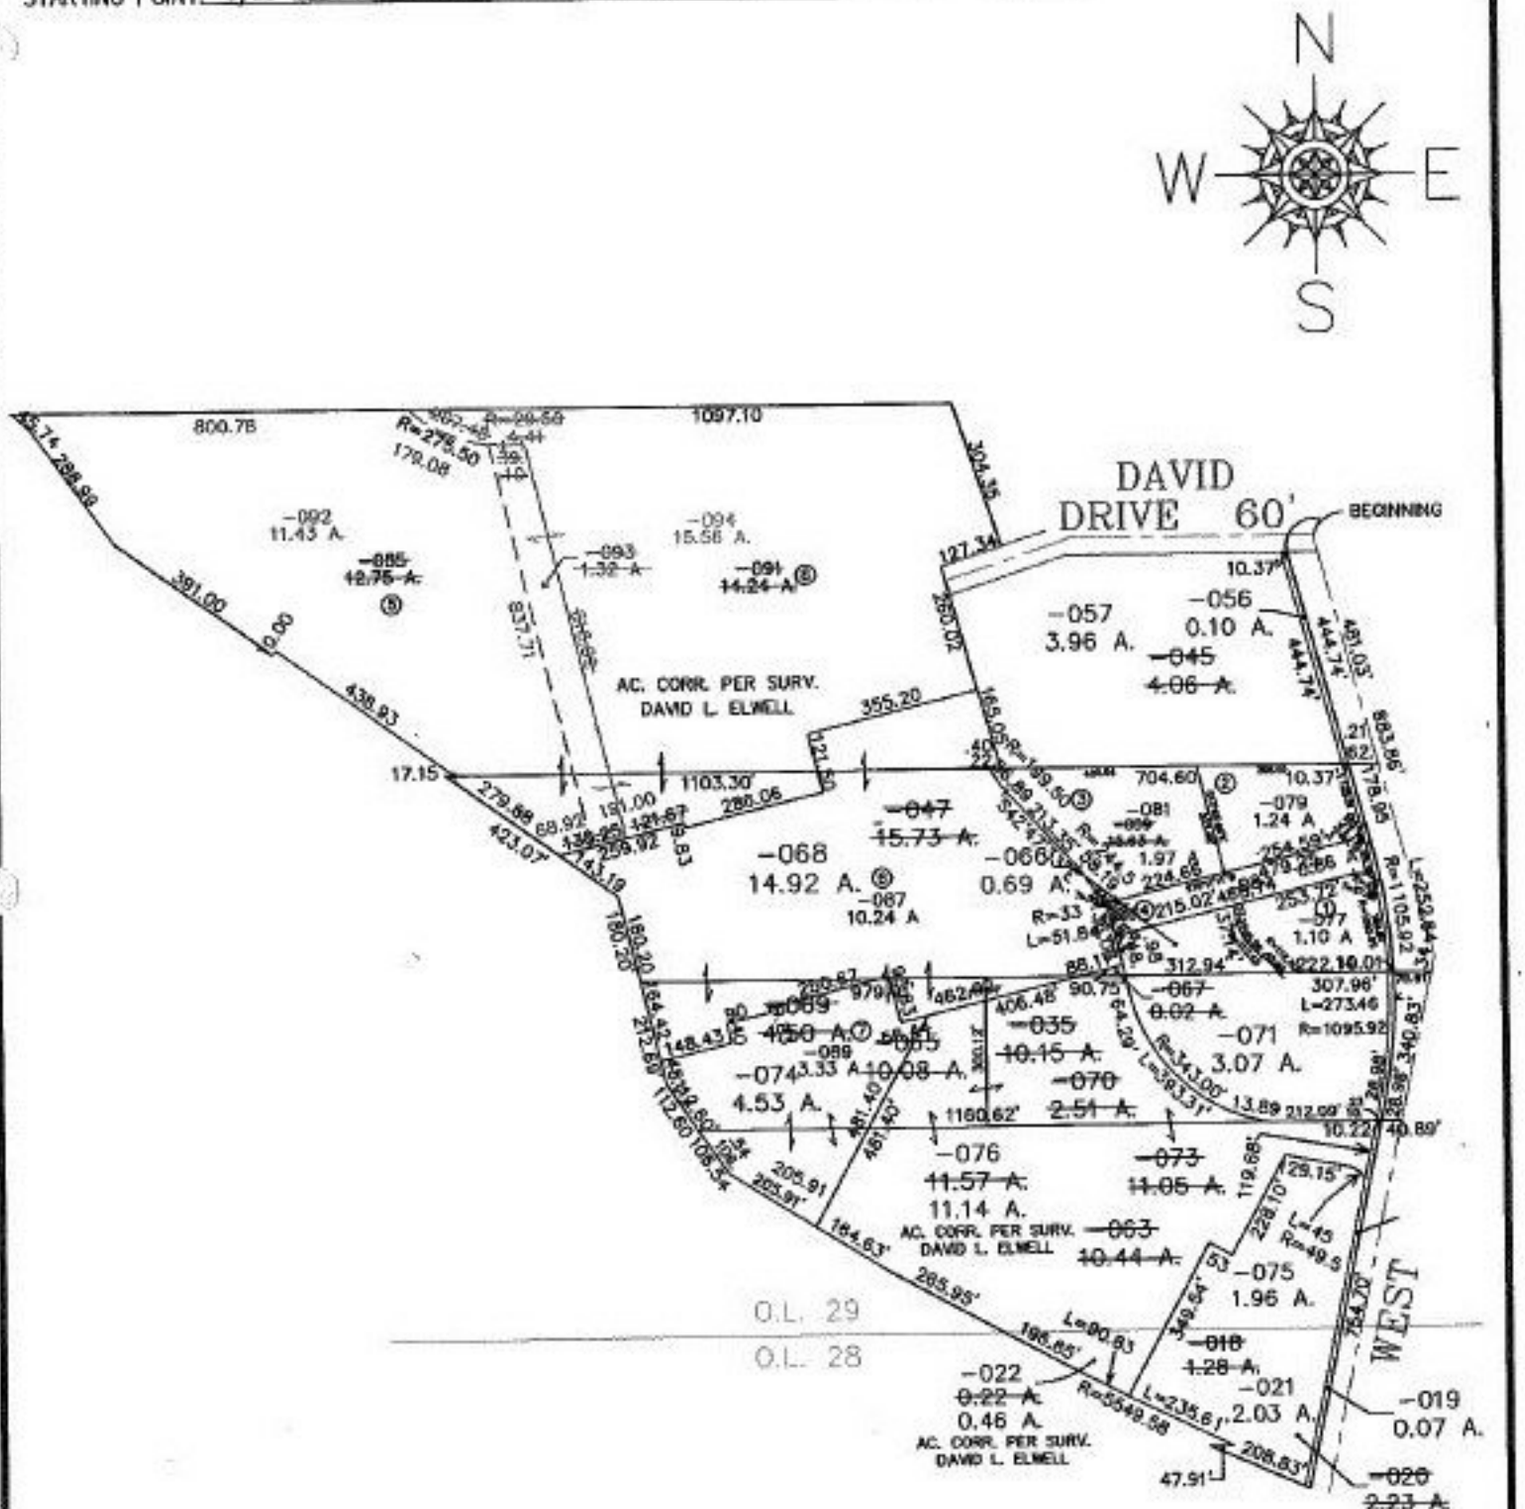

SPLITS/DEEDS PROCESSED

LORAIN COUNTY TAX MAP DEPARTMENT
226 MIDDLE AVE. ELYRIA, OHIO

SURVEYED BY: DAVID L ELWELL

CLOSURE: 0.04 : 10,000

MAP PAGE(S): 6-64 & 6-65

APPROVED BY: TJS DATE: 04/08/99

SCALE: 1" = 400 PRIOR INSTRUMENT: 980583728