PARENT PARCEL: 05-00-060-101-047, & 05-00-060-104-015
CHILD PARCEL: XX-XX-XXX-XXX-XXX
STARTING POINT: XXXXXX

NO. 00061-D

DEED CHECK

05-00-060-101-047
0.47 A.
SURVEY & UPDATE LEGAL

05-00-060-104-015
MAP 0.76 A.
DEED 0.77 A.
SURVEY & UPDATE LEGAL

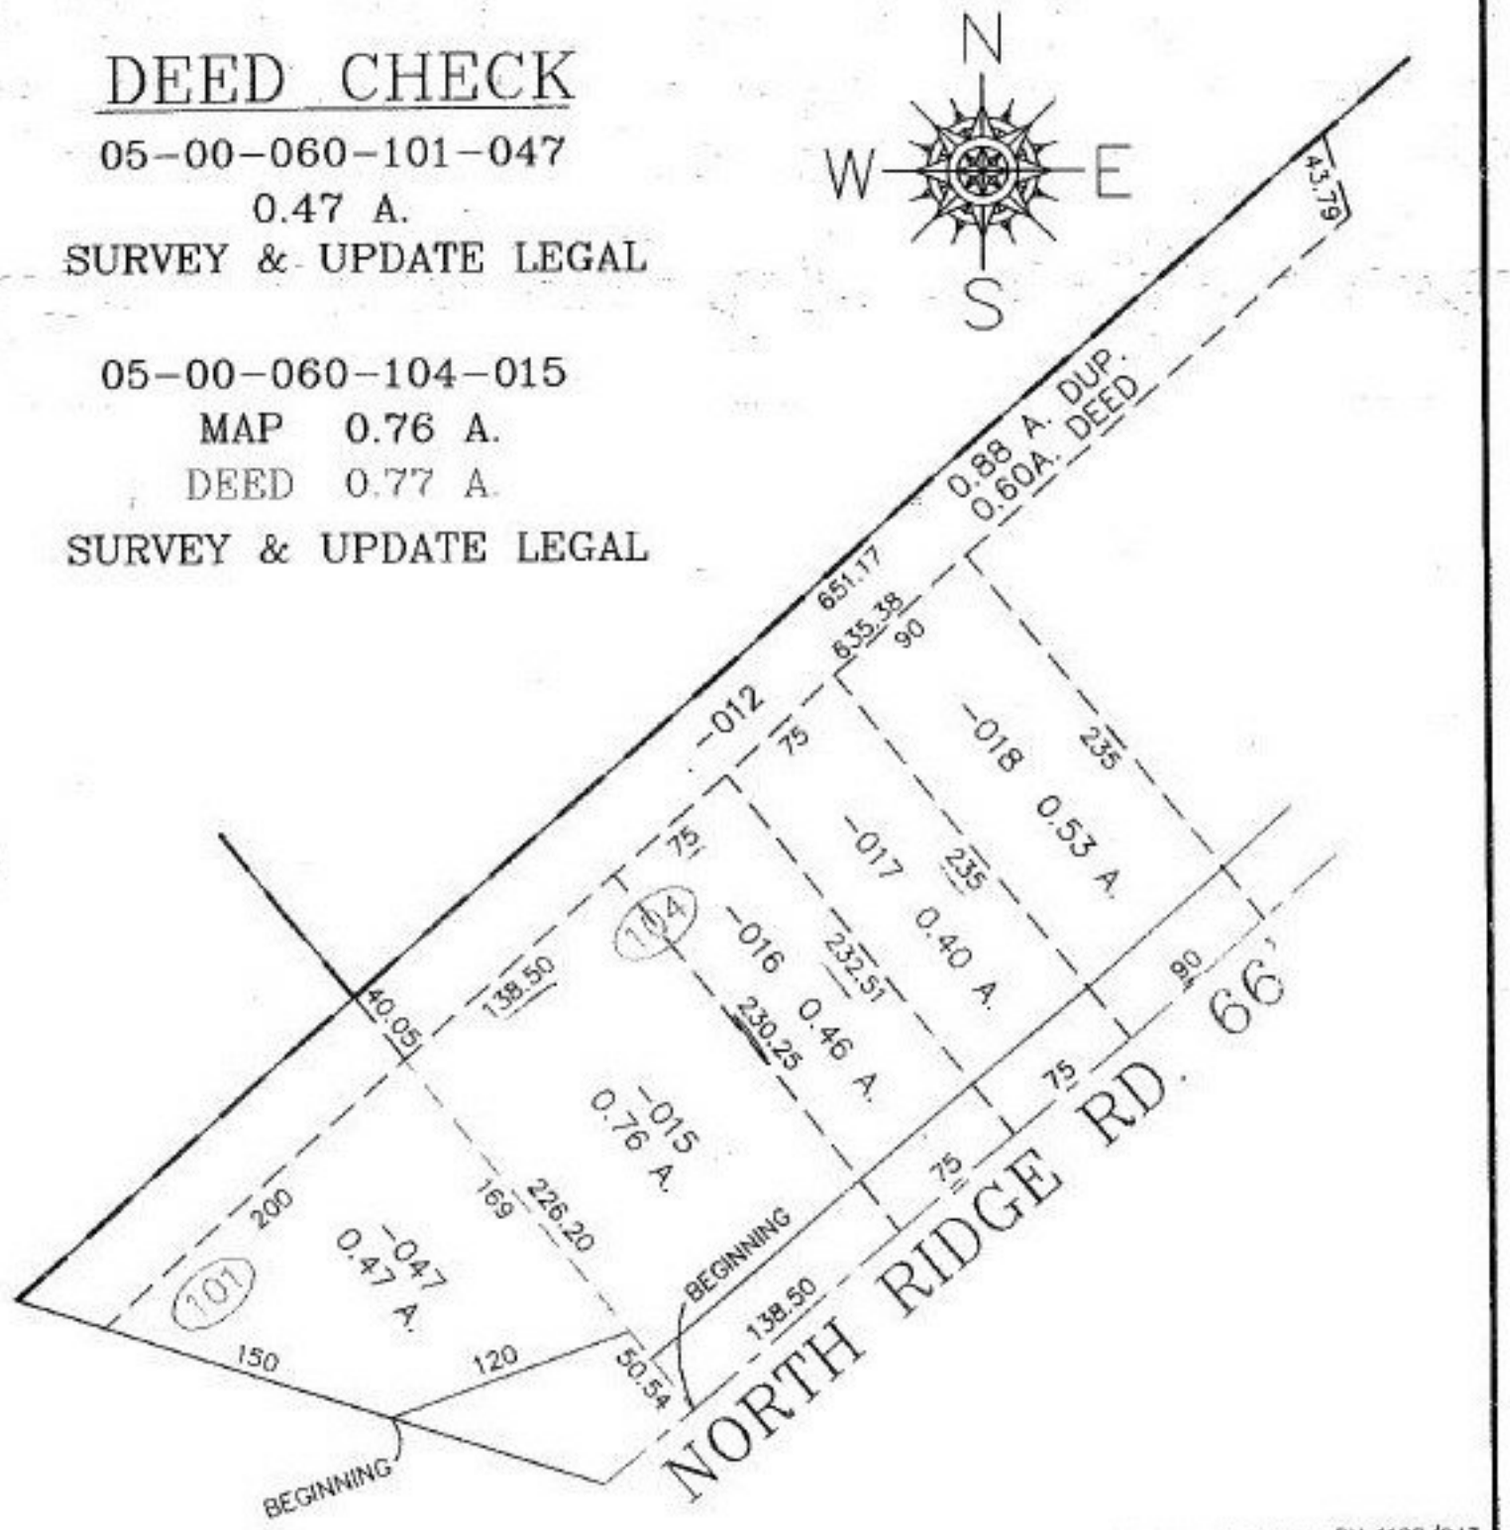

PRIOR INSTRUMENT: DV 1108/943
PRIOR INSTRUMENT: OR 1174/195

SPLITS/DEEDS PROCESSED
LORAIN COUNTY TAX MAP DEPARTMENT
226 MIDDLE AVE. ELYRIA, OHIO

SURVEYED BY: NONE
CLOSURE: CAN'T RUN
MAP PAGE(S): 05-00-060-A & B
APPROVED BY: TJS DATE: 05/25/99
SCALE: 1" = 100