PARENT PARCEL: 18-00-009-000-058
CHILD PARCEL: 18-00-009-000-060 thru -062
STARTING POINT: CL OF HAWLEY RD. & N.W. CORNER OF O.L. 9

NO. 00074

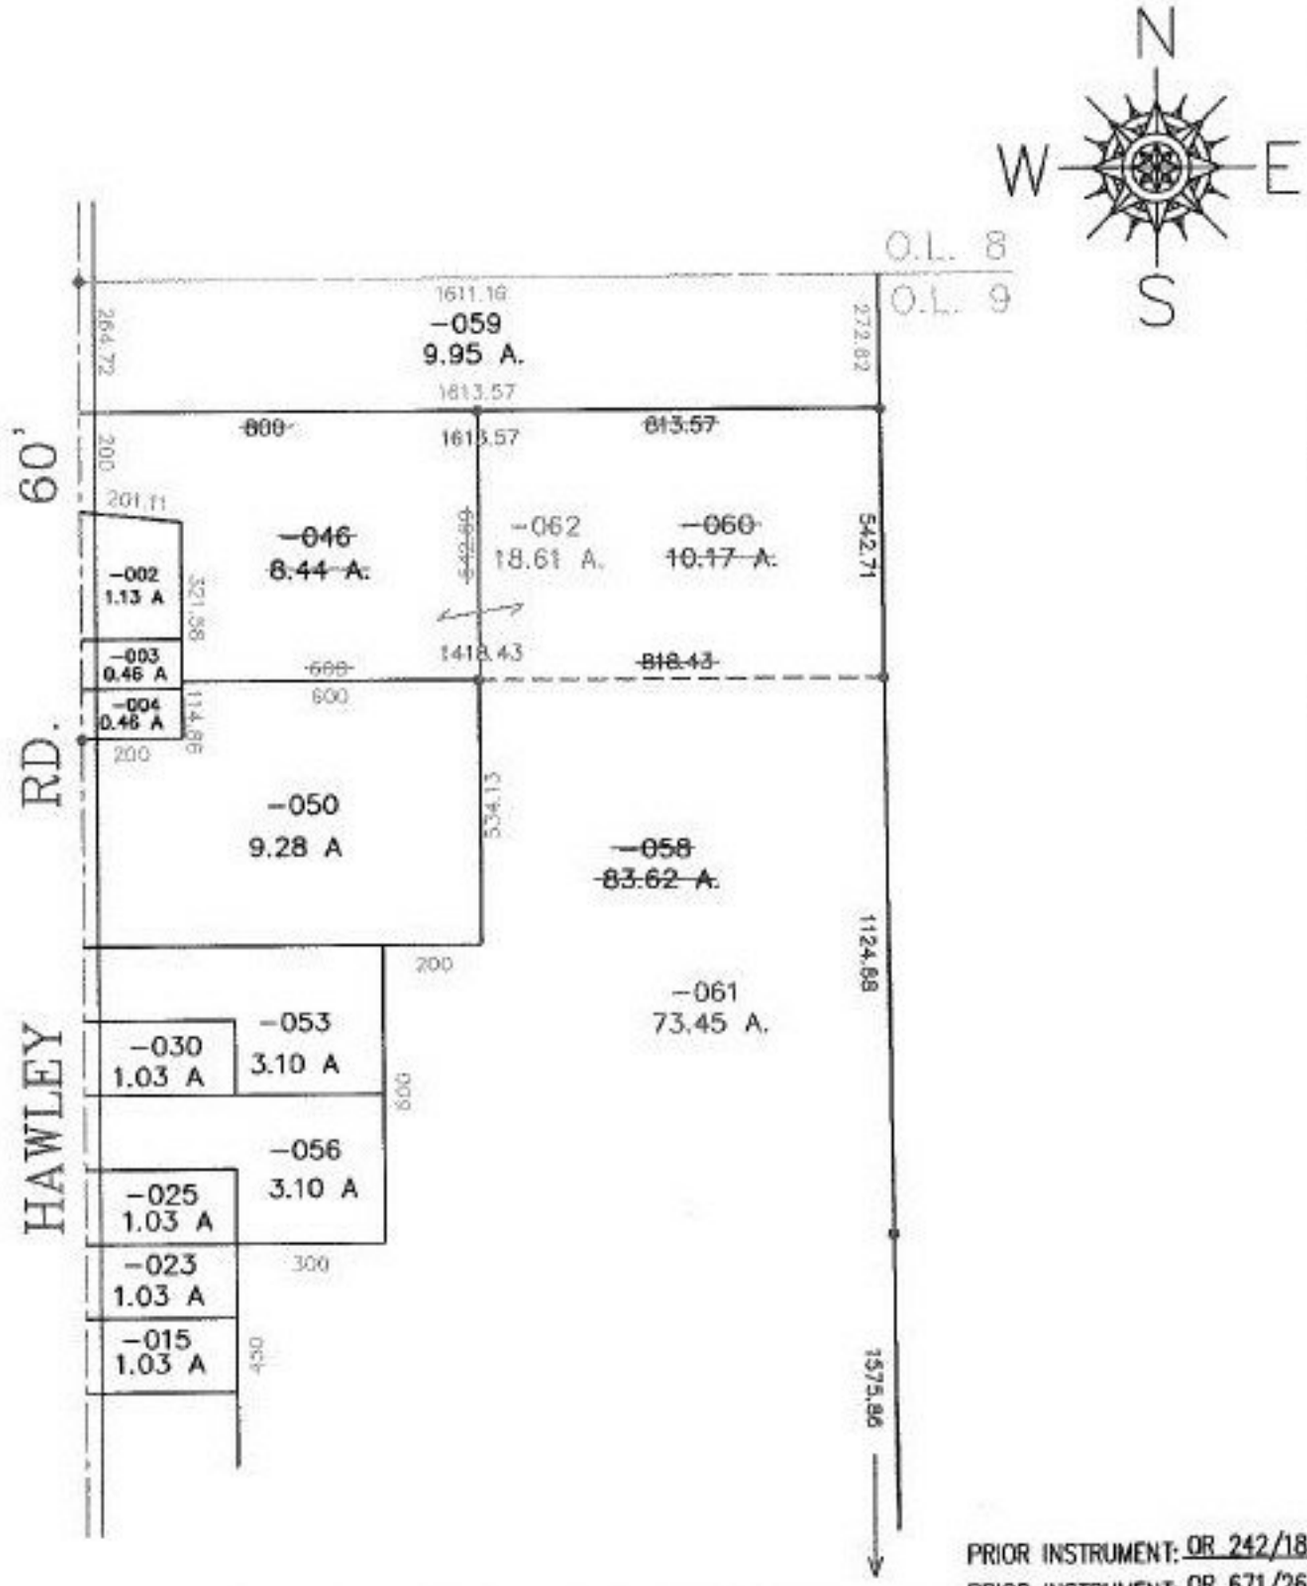

PRIOR INSTRUMENT: OR 242/183
PRIOR INSTRUMENT: OR 671/264

SPLITS/DEEDS PROCESSED
LORAIN COUNTY TAX MAP DEPARTMENT
226 MIDDLE AVE. ELYRIA, OHIO

SURVEYED BY: RODGER G. SIMON
CLOSURE: 0.02 : 10,000
MAP PAGE(S): 18-D
APPROVED BY: TJS DATE: 04/26/99
SCALE: 1" = 400