TAKE NUMBER OUT — TAKED UNDER NUMBER → 05-00-091-106-[redacted]012

REMOVE P.P.No. ADD HOOK

MARKED IN MASTER REG. AS NOT USED

SEE 9-00-002-A

THIS P.P. No. IS NOT IN REGISTER OR ON TAX DUP.

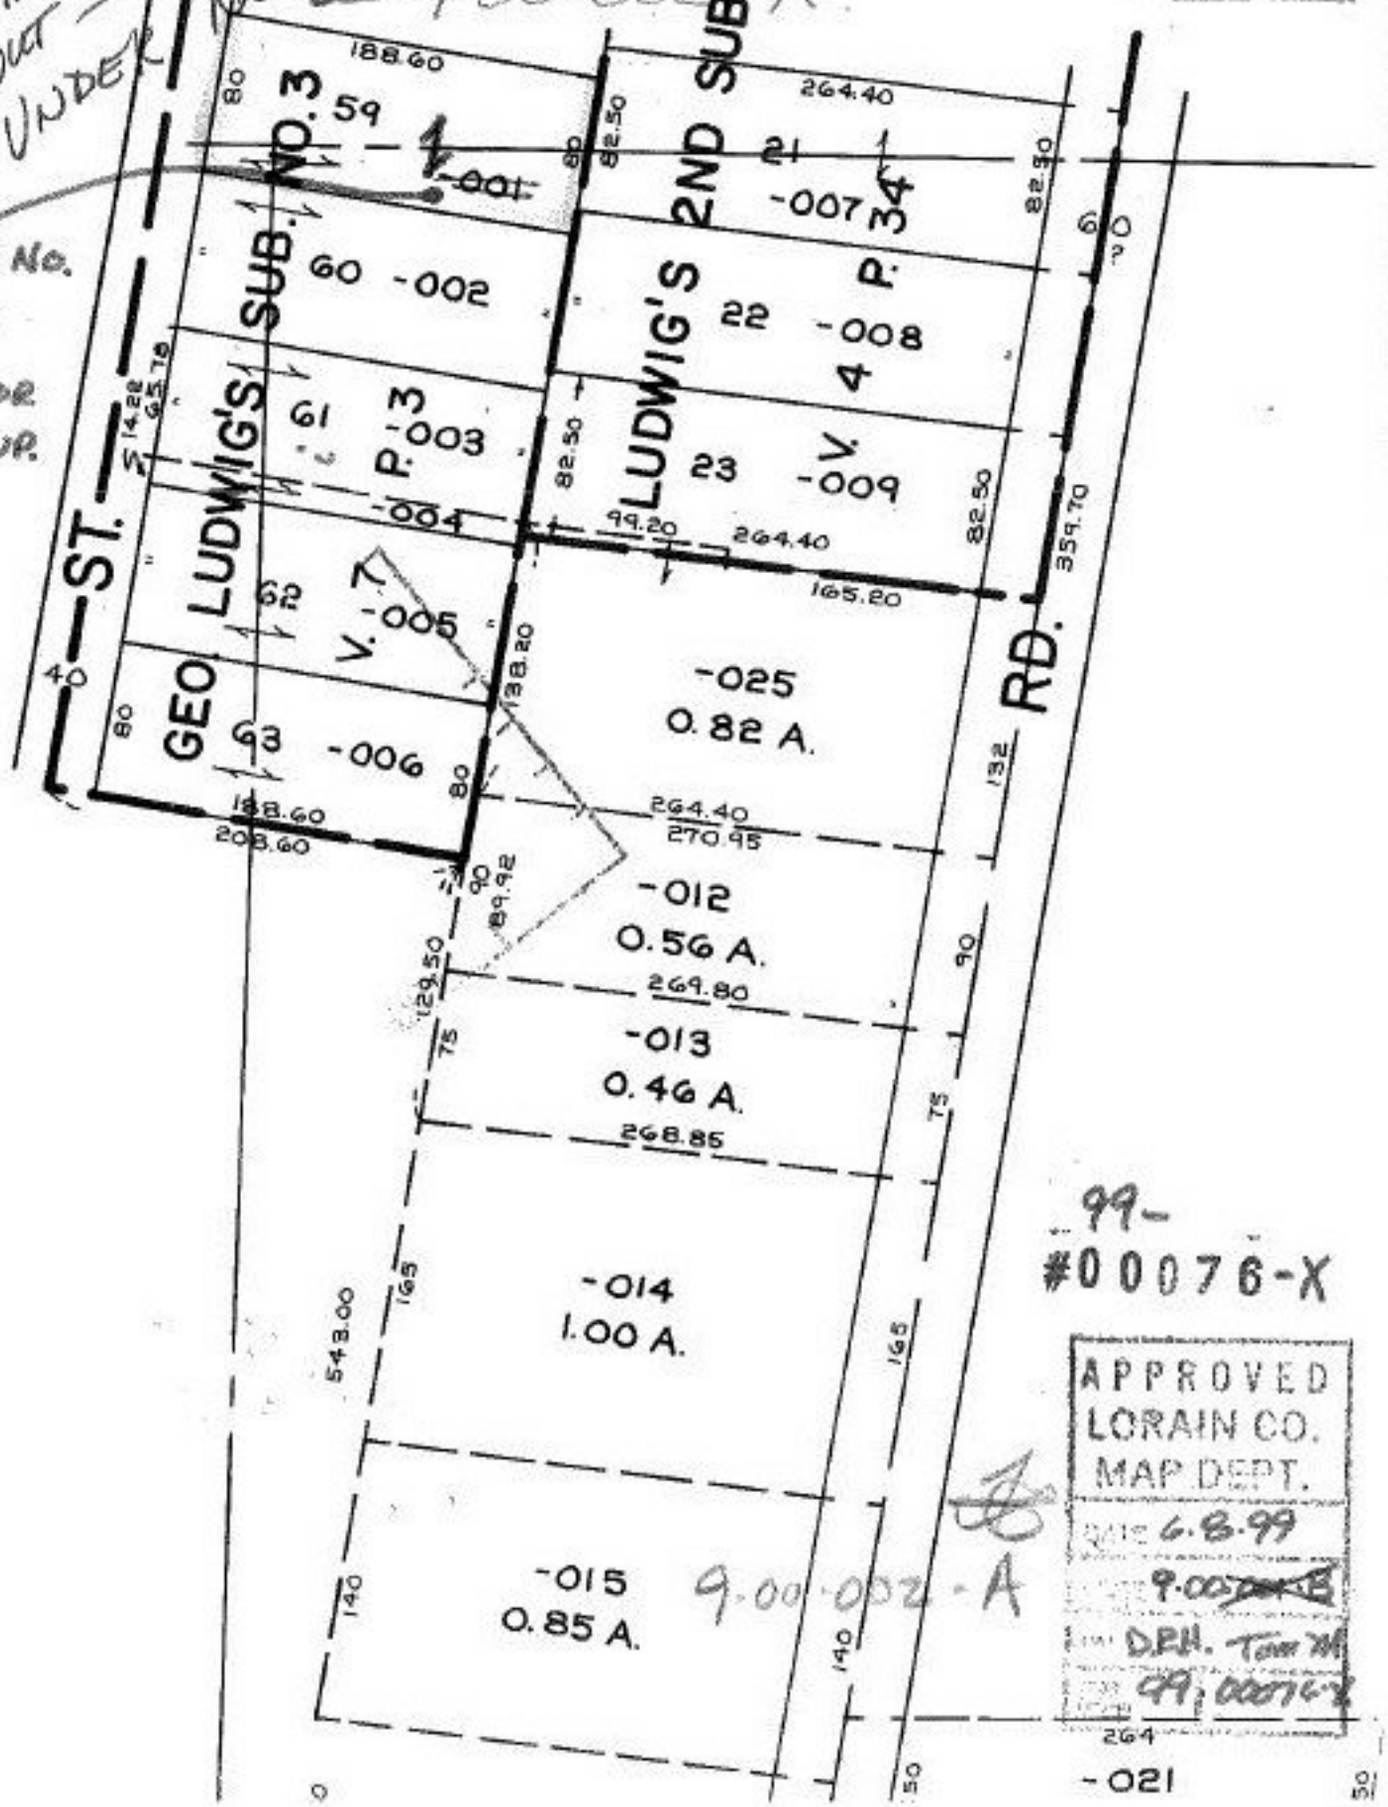

99-
#00076-X

APPROVED
LORAIN CO.
MAP DEPT.
DATE 6.8.99
9.00
D.P.H. Tom M
99-00076-X

9-00-002-A