PARENT PARCEL: 02-02-025-102-005
CHILD PARCEL: XX-XX-XXX-XXX-XXX
STARTING POINT: BEING S\L 39, & HALF OF VACATED ALLEY

NO. 00086-X

DEPTH CORRECTION

02-02-025-102-005

~~50 X 150~~

50 X 158

CORR. FEE DEED

9805[illegible]

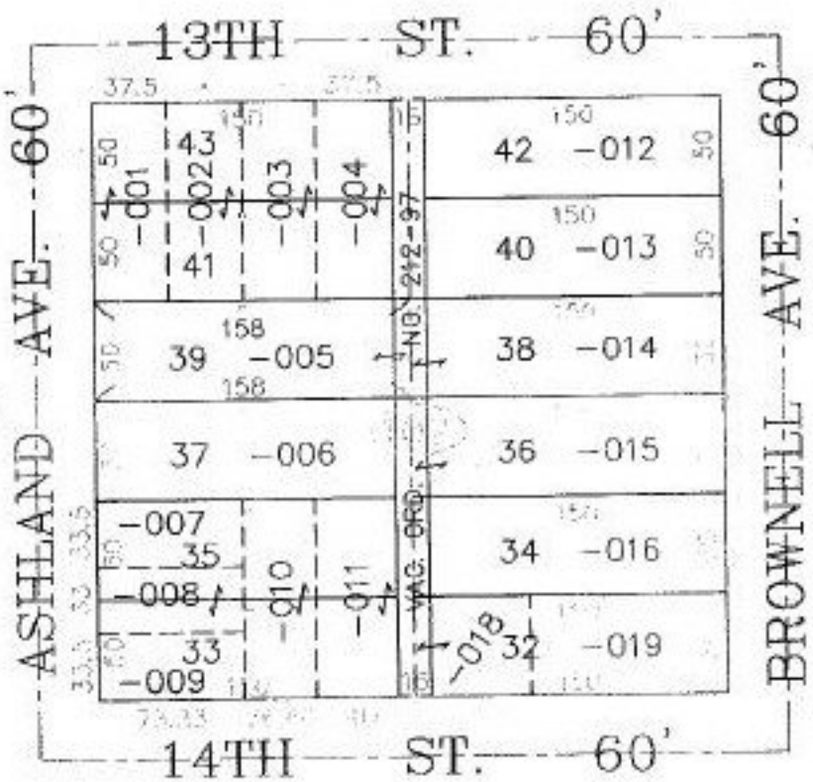

SPLITS/DEEDS PROCESSED

LORAIN COUNTY TAX MAP DEPARTMENT
226 MIDDLE AVE. ELYRIA, OHIO

SURVEYED BY: NONE
CLOSURE: CAN'T RUN
MAP PAGE(S): 02-02-025-B
APPROVED BY: TJS DATE: 06/28/99
SCALE: 1" = 100 PRIOR INSTRUMENT: OR 1320/564