PARENT PARCEL: 15-00-056-101-037 & -047

CHILD PARCEL: 15-00-056-101-053 THRU -055

STARTING POINT: I.P. IN THE CL OF S.R. 303 & N.W.CORNER OF O.L. 56

NO. 00096

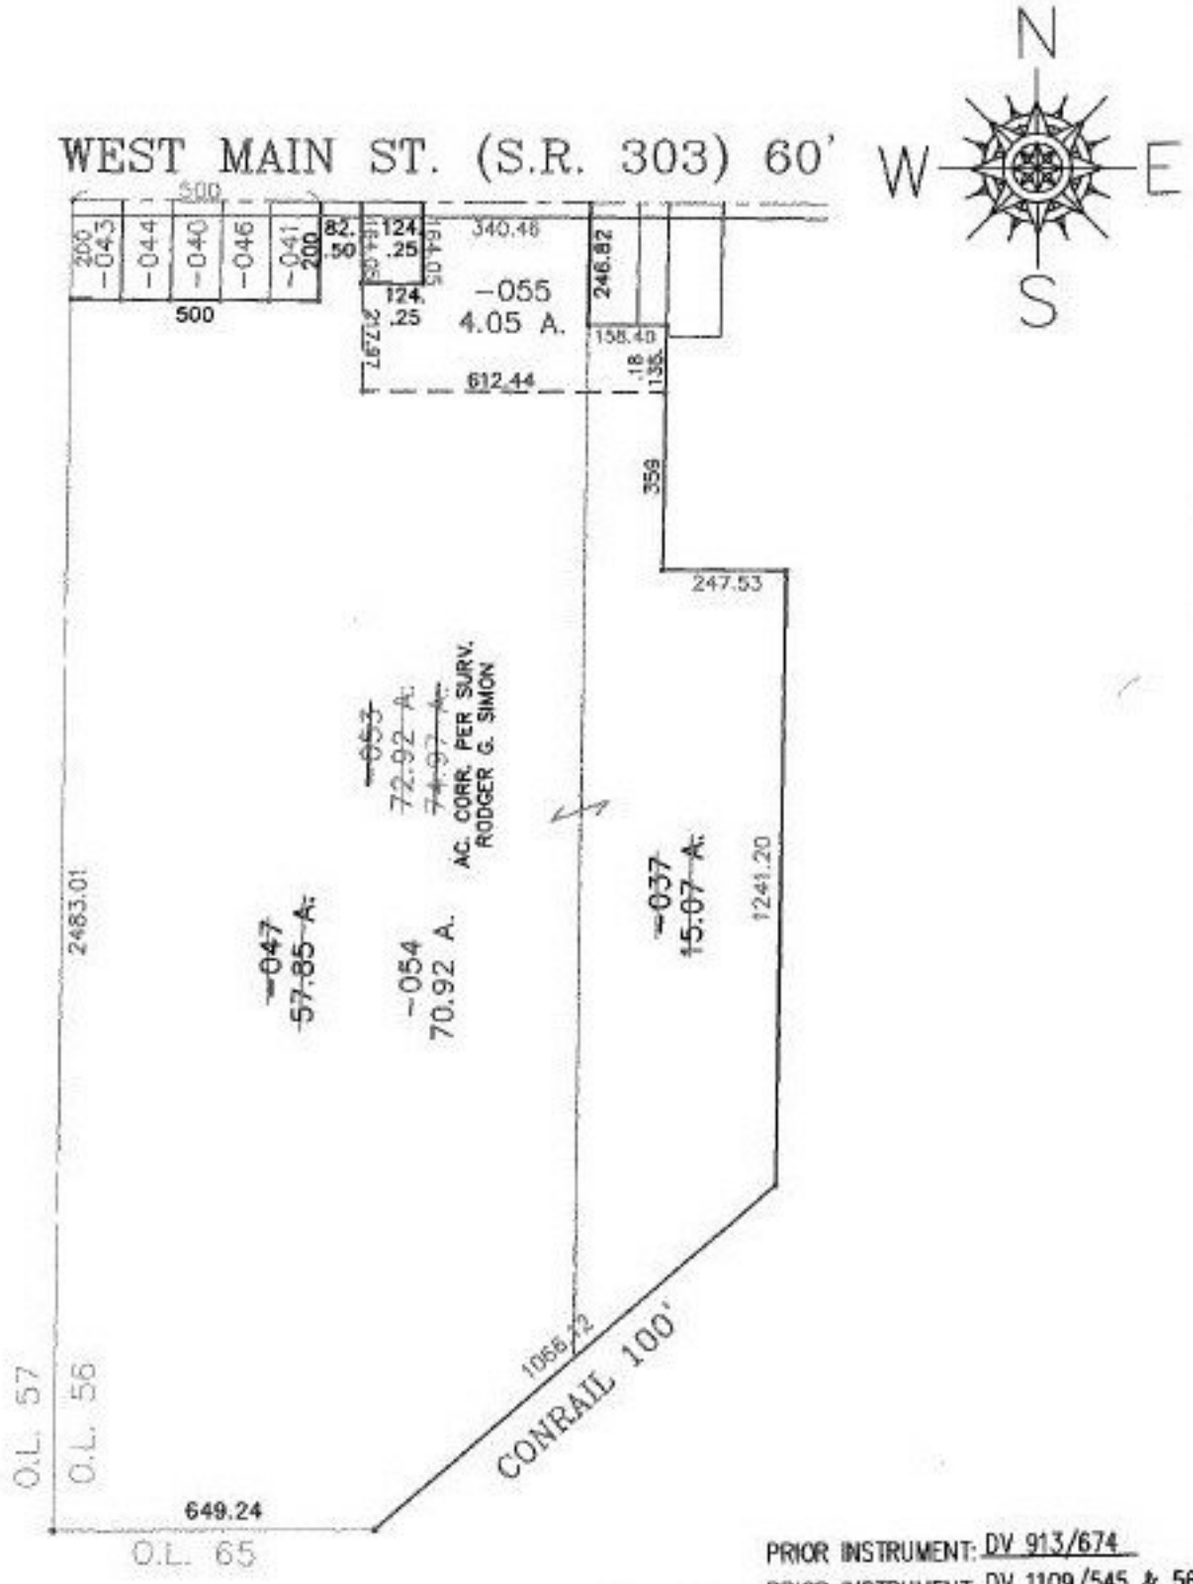

PRIOR INSTRUMENT: DV 913/674

PRIOR INSTRUMENT: DV 1109/545 & 567

SPLITS/DEEDS PROCESSED

LORAIN COUNTY TAX MAP DEPARTMENT

226 MIDDLE AVE. ELYRIA, OHIO

SURVEYED BY: RODGER G. SIMON

CLOSURE: 0.02 : 10.000

MAP PAGE(S): 15-00-056-A

APPROVED BY: TJS DATE: 05/20/99

SCALE: 1" = 400