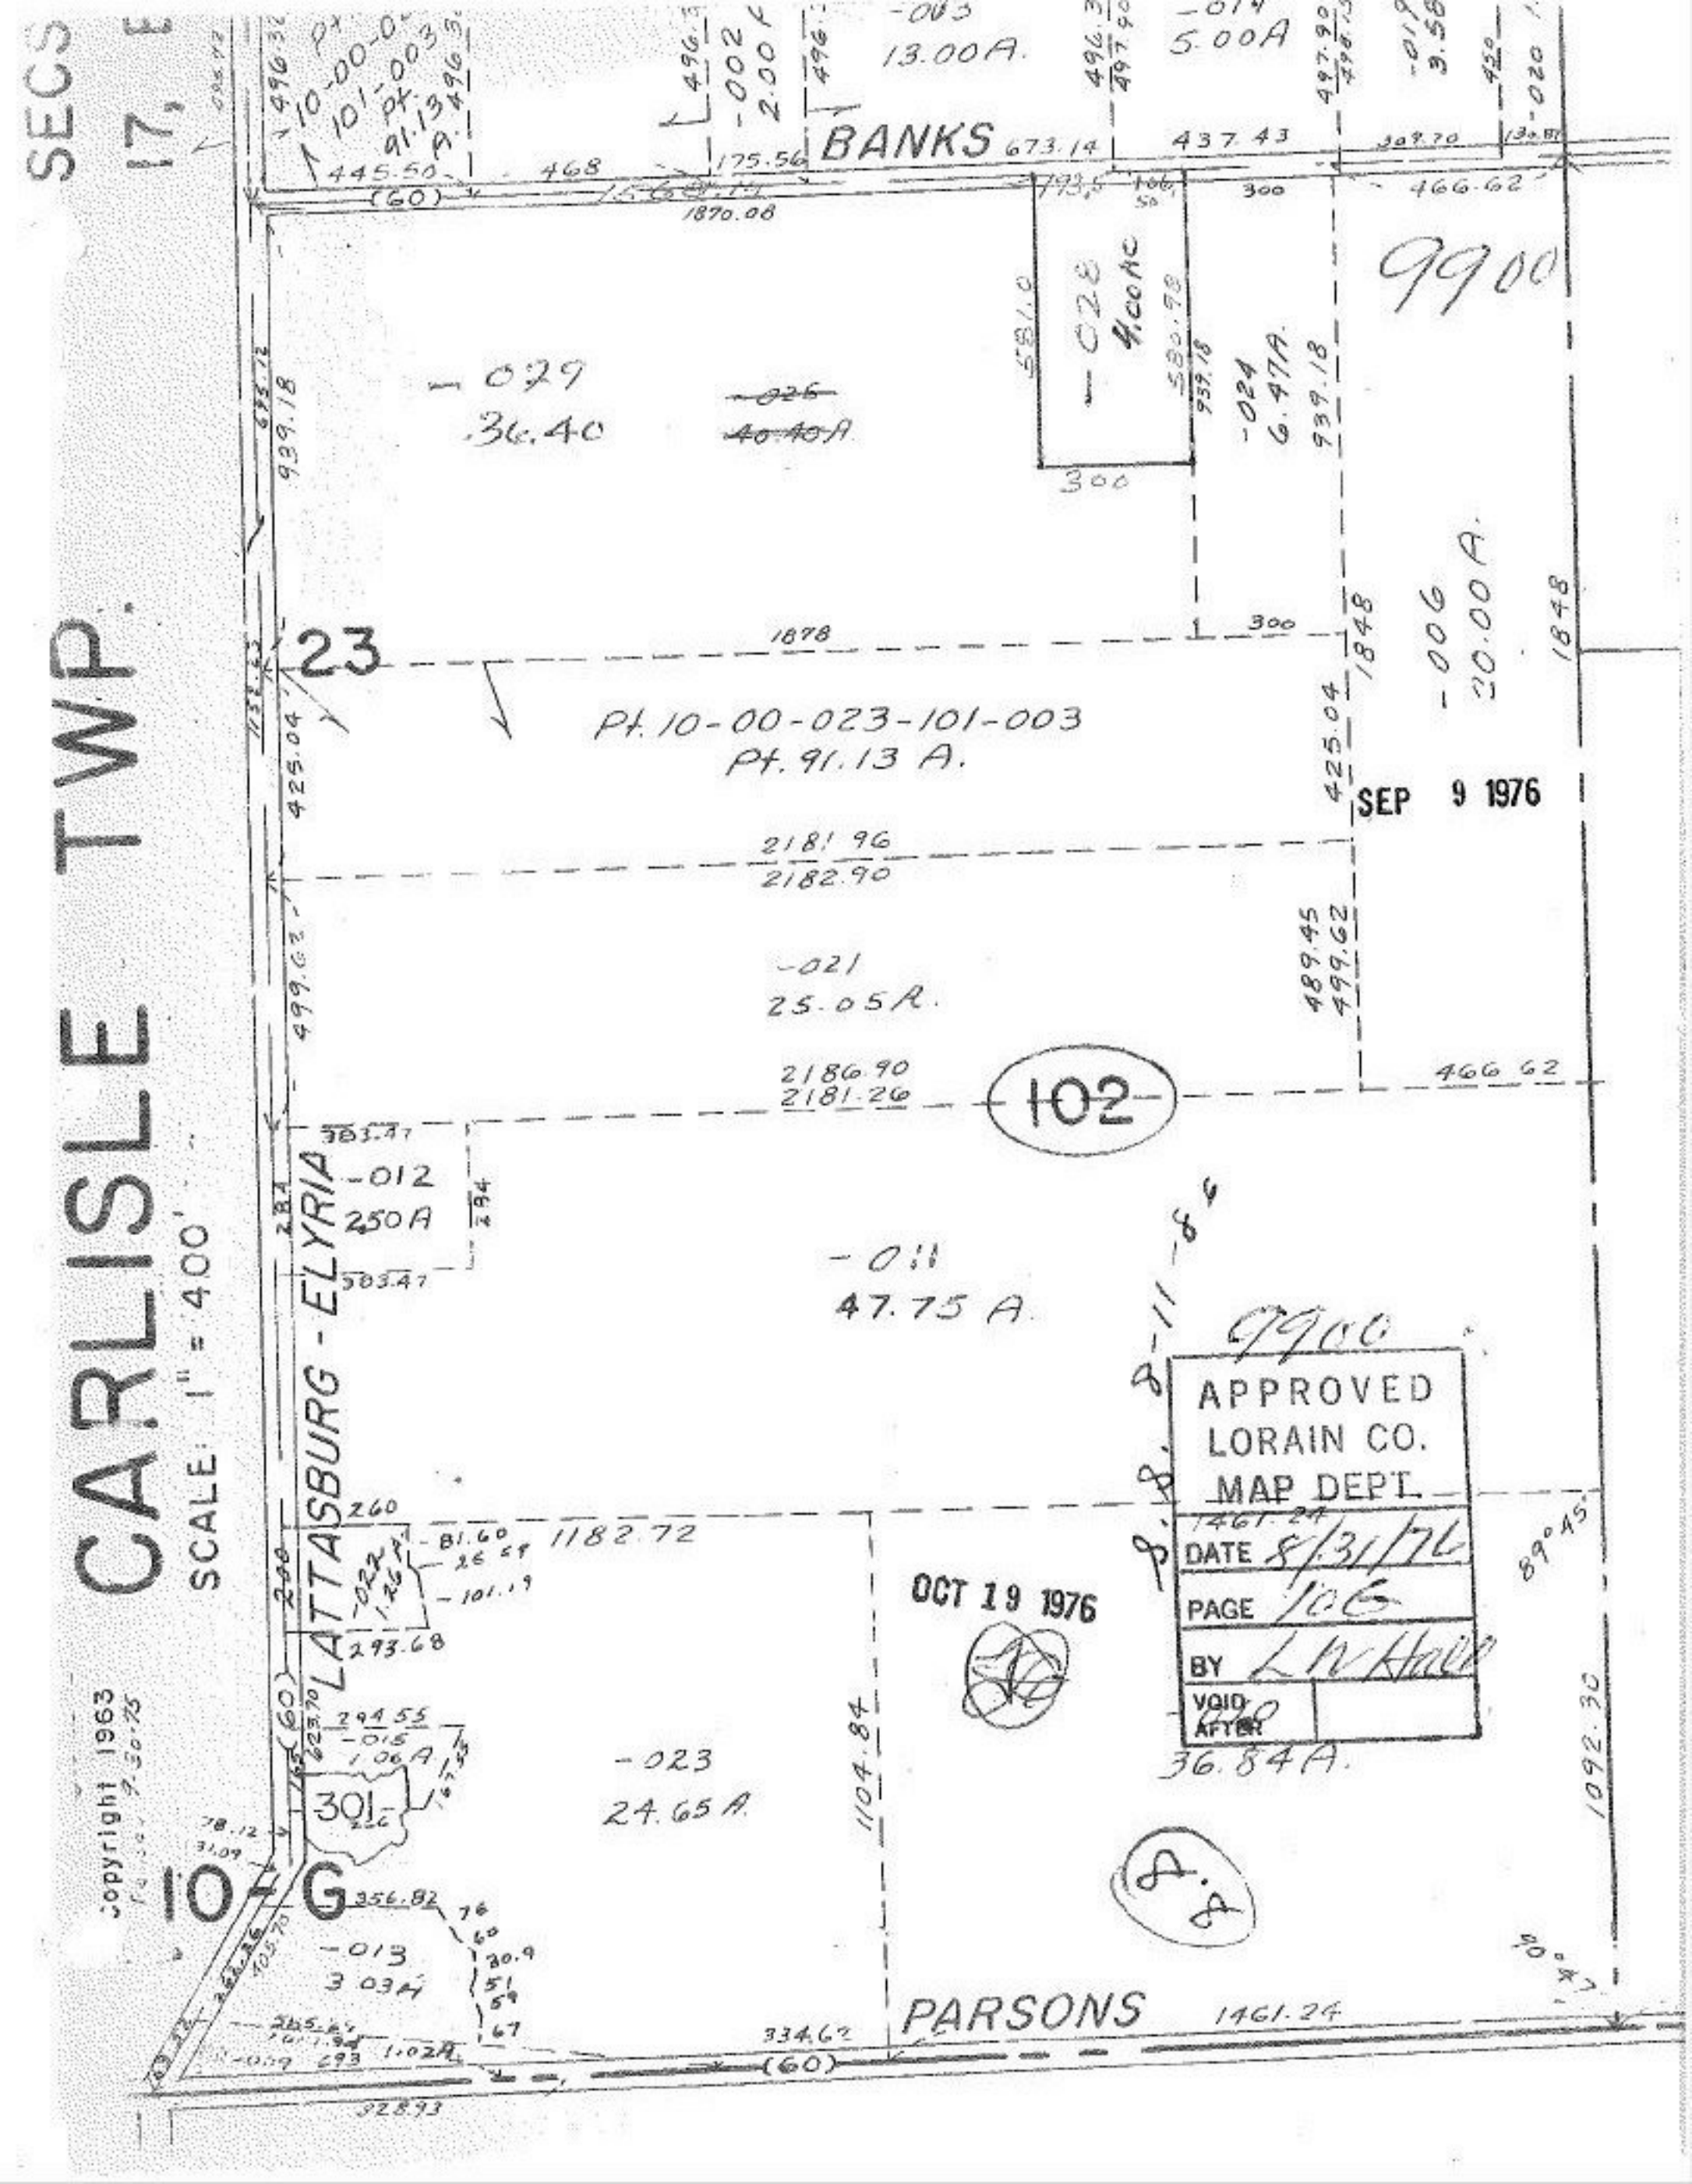

CARLISLE TWP.
SCALE: 1" = 400'
SECS 17, E
BANKS
LATTASBURG - ELYRIA
PARSONS
23
102
10-G
301
Pt. 10-00-023-101-003
Pt. 91.13 A.
-029
36.40
-028
4.00 AC
-024
6.47 A.
-006
20.00 A.
-021
25.05 A.
-012
2.50 A
-011
47.75 A.
-023
24.65 A.
-013
3.03 A
-015
1.06 A
-022
1.26 A
-003
13.00 A.
-014
5.00 A
-002
2.00 A
-020
3.58
9900
9900
APPROVED
LORAIN CO.
MAP DEPT.
DATE 8/31/76
PAGE 106
BY L.W. Hall
VOID AFTER
OCT 19 1976
SEP 9 1976
8.8.8-11-86
Copyright 1963