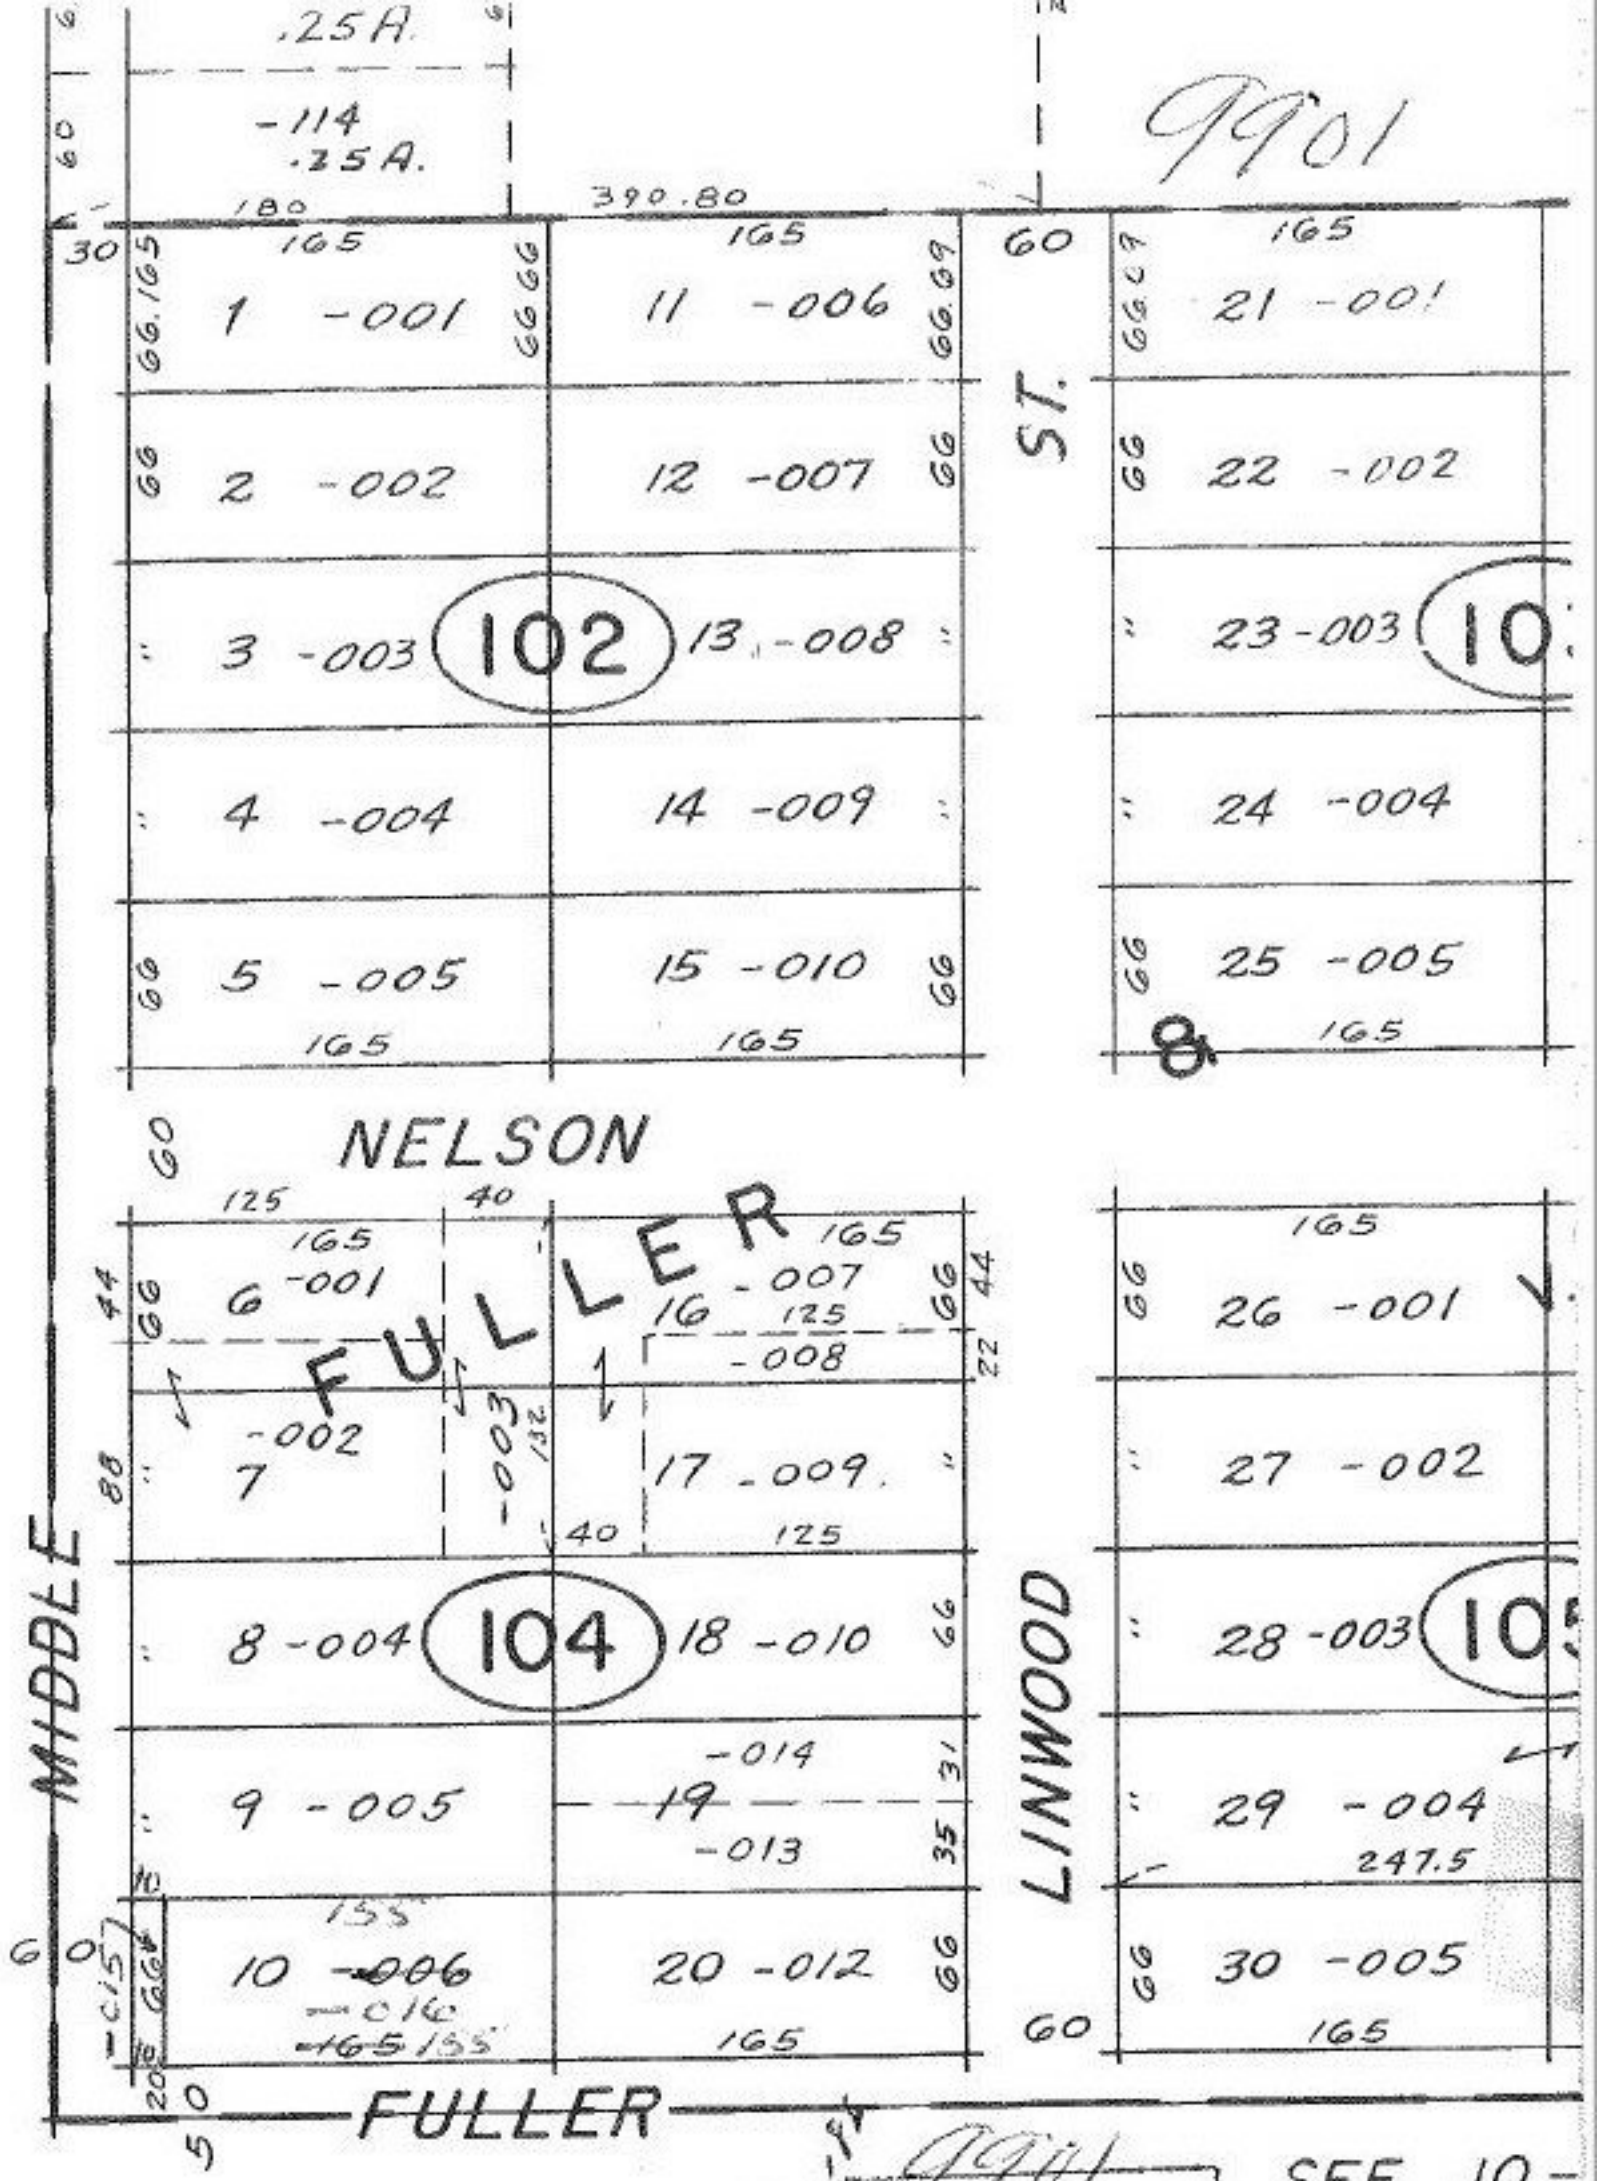

OCT 19 1976

SEP 1 1976

9901

APPROVED
LORAIN CO.
MAP DEPT.
DATE 8/31/76
PAGE 10-00-004A
BY LW Hall
VOID AFTER

CARLISLE TWP.