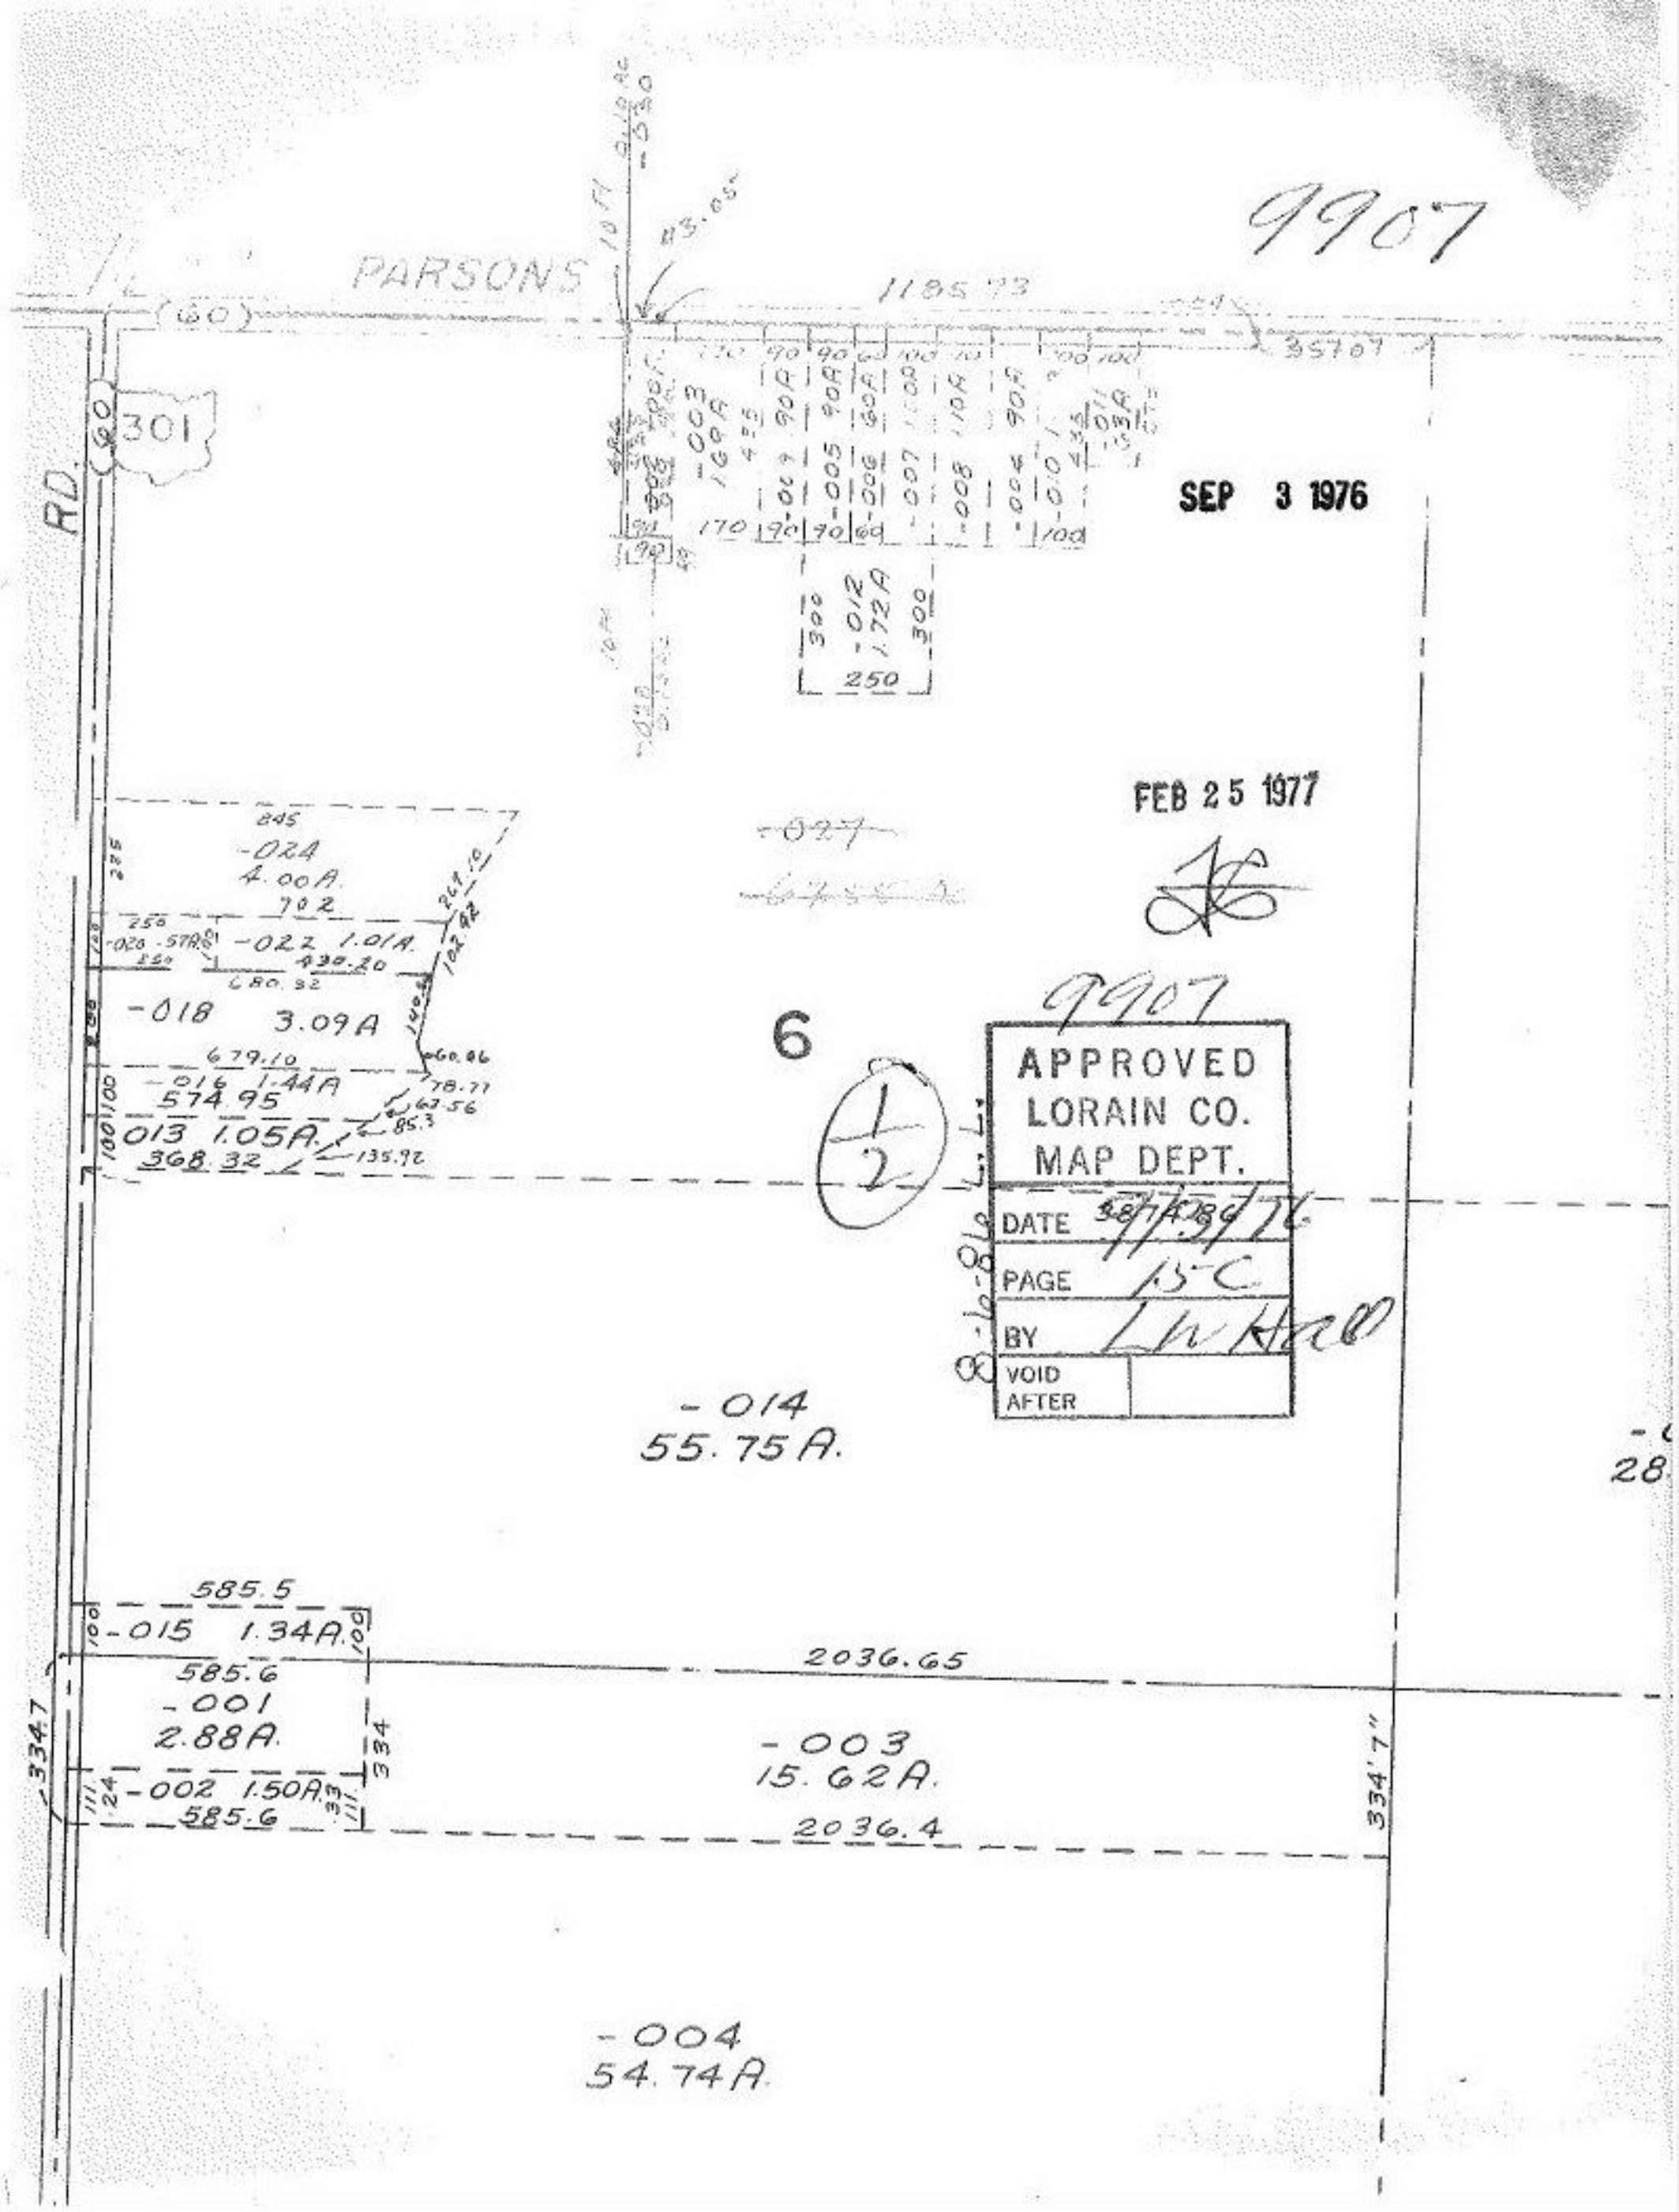
9907
PARSONS
RD.
301
SEP 3 1976
FEB 25 1977
6
1/2
APPROVED
LORAIN CO.
MAP DEPT.
DATE
PAGE 15C
BY
VOID AFTER
-014
55.75A.
-015 1.34A.
-001
2.88A.
-002 1.50A.
-003
15.62A.
-004
54.74A.
2036.65
2036.4
334.7
334'7"
585.5
585.6
-018 3.09A
-016 1.44A
-013 1.05A.
-022 1.01A.
-024
4.00A.
-012
1.72A
-027