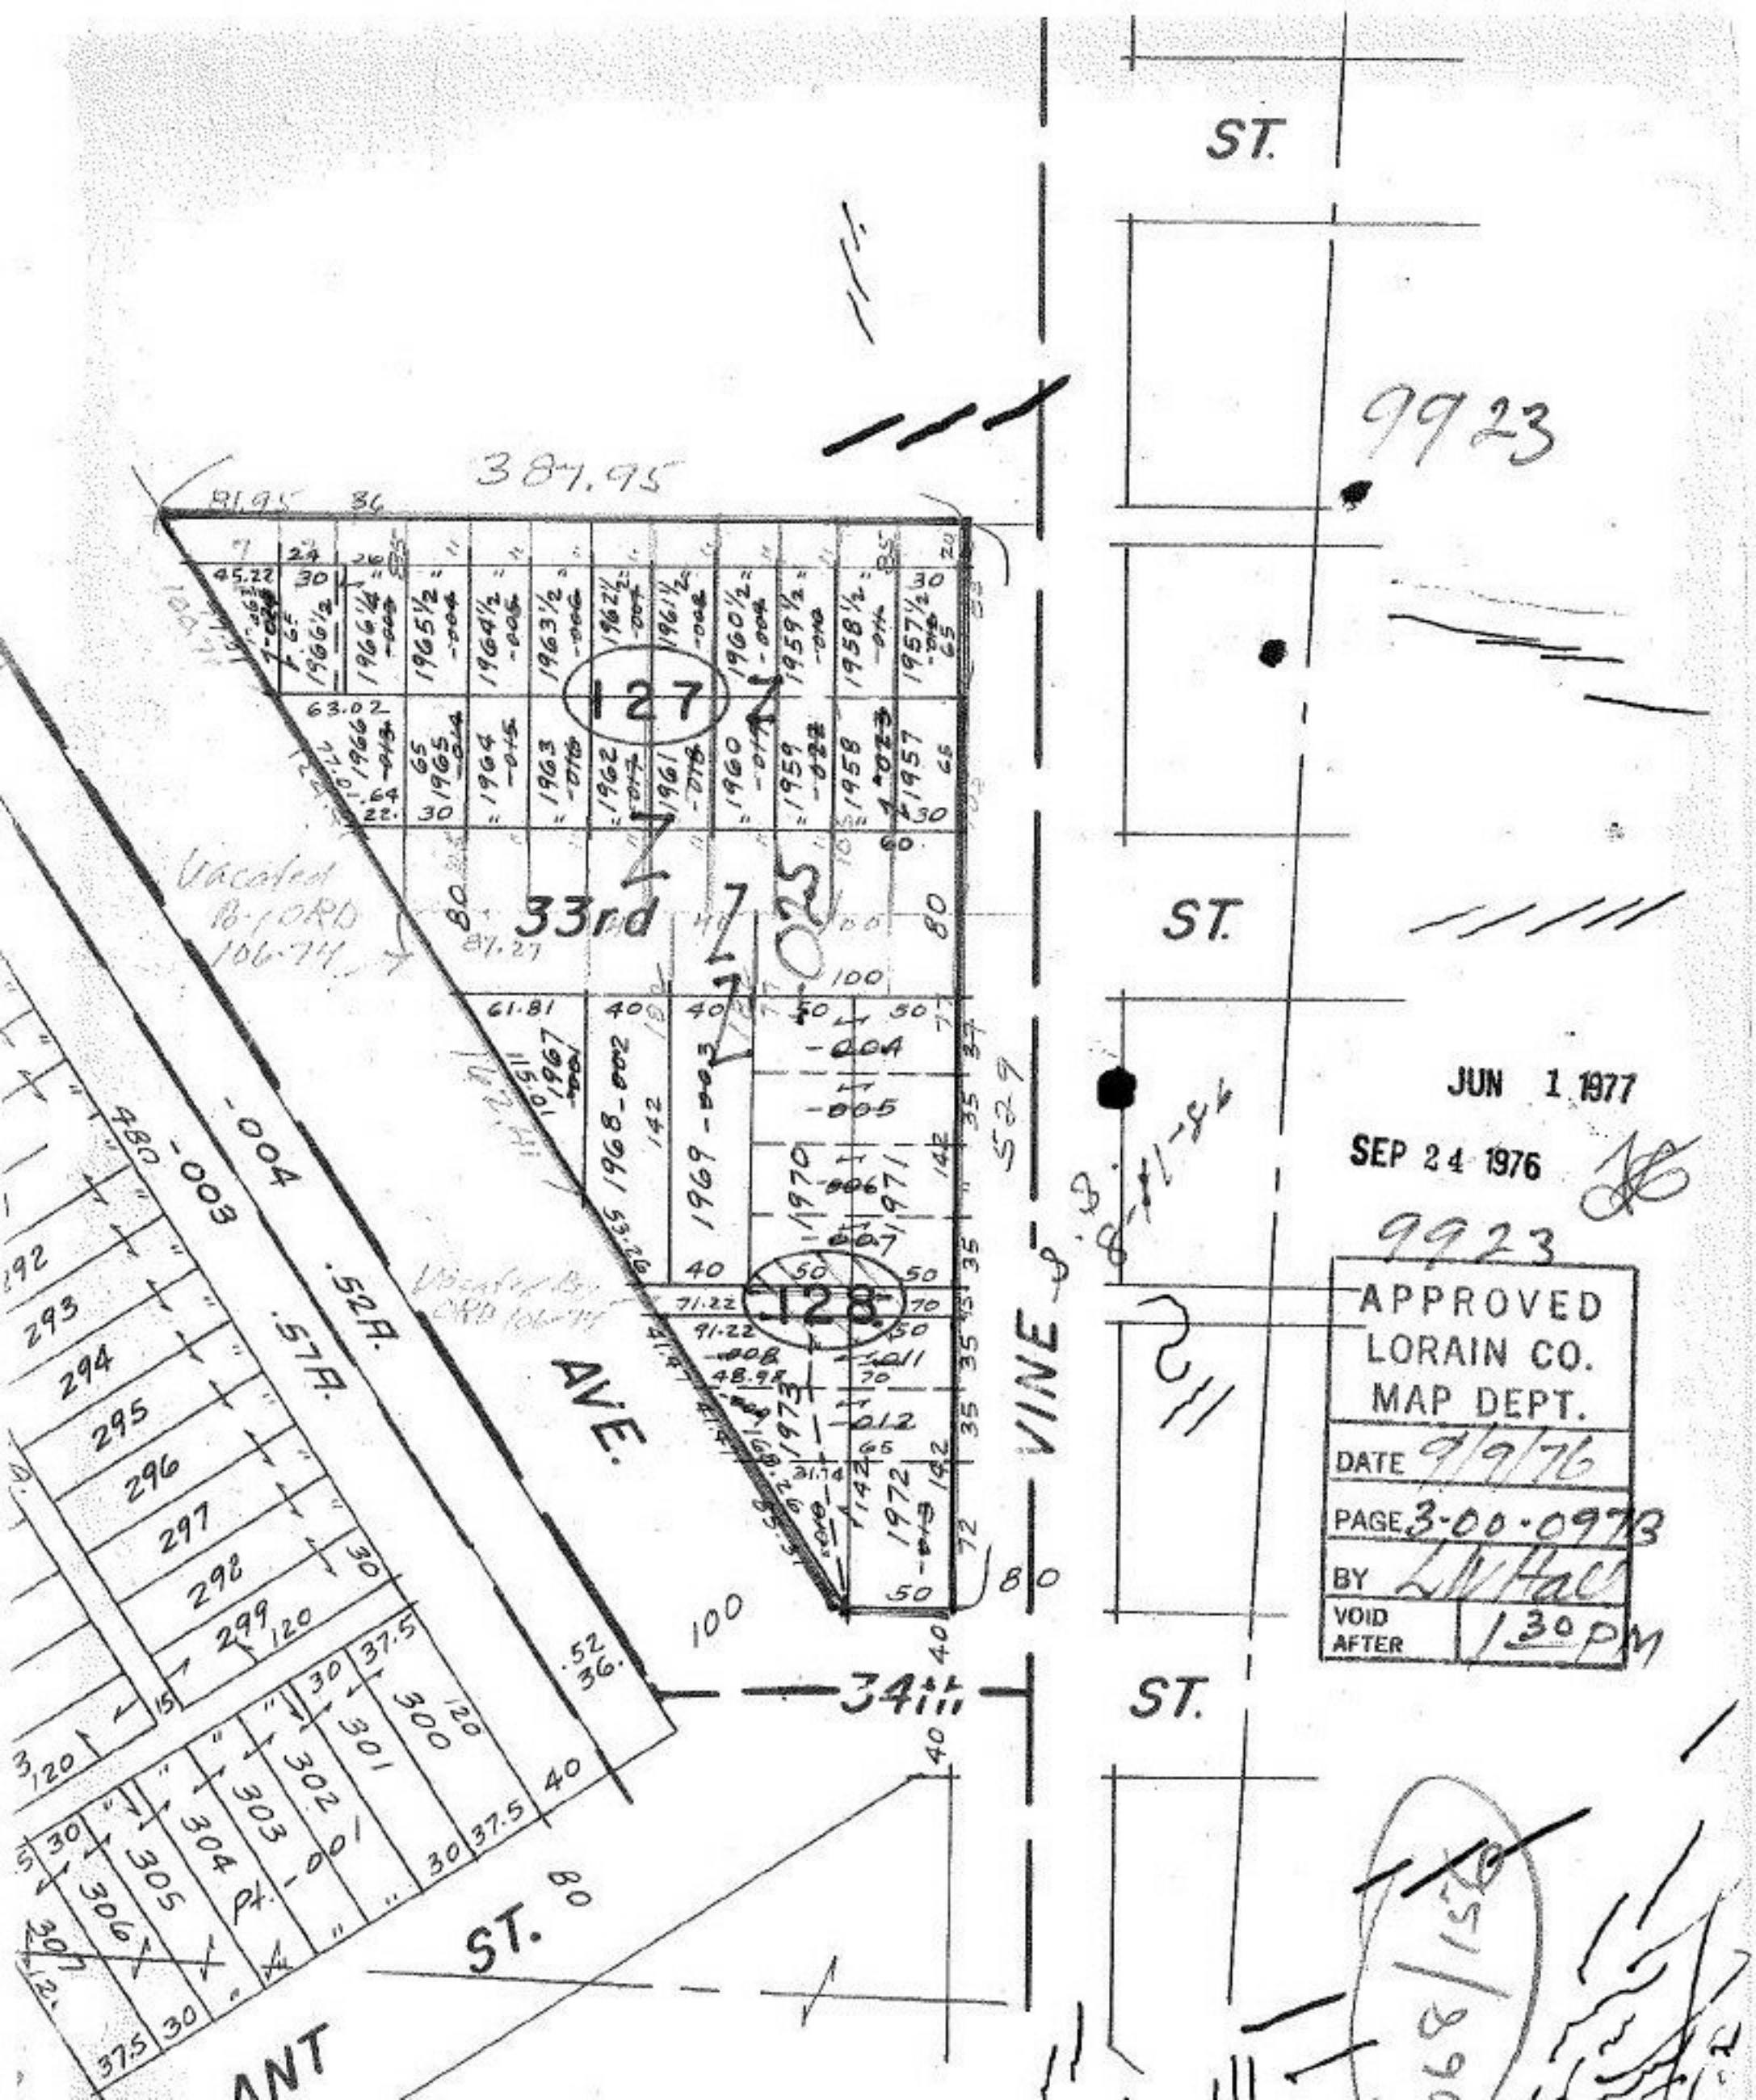

ST.
9923
387.95
127
33rd
ST.
Vacated By ORD 106-74
128
AVE.
VINE
34th
ST.
ANT
ST.
JUN 1 1977
SEP 24 1976
9923
APPROVED
LORAIN CO.
MAP DEPT.
DATE 9/9/76
PAGE 3-00-0973
BY L.W. Hall
VOID AFTER 1:30 PM