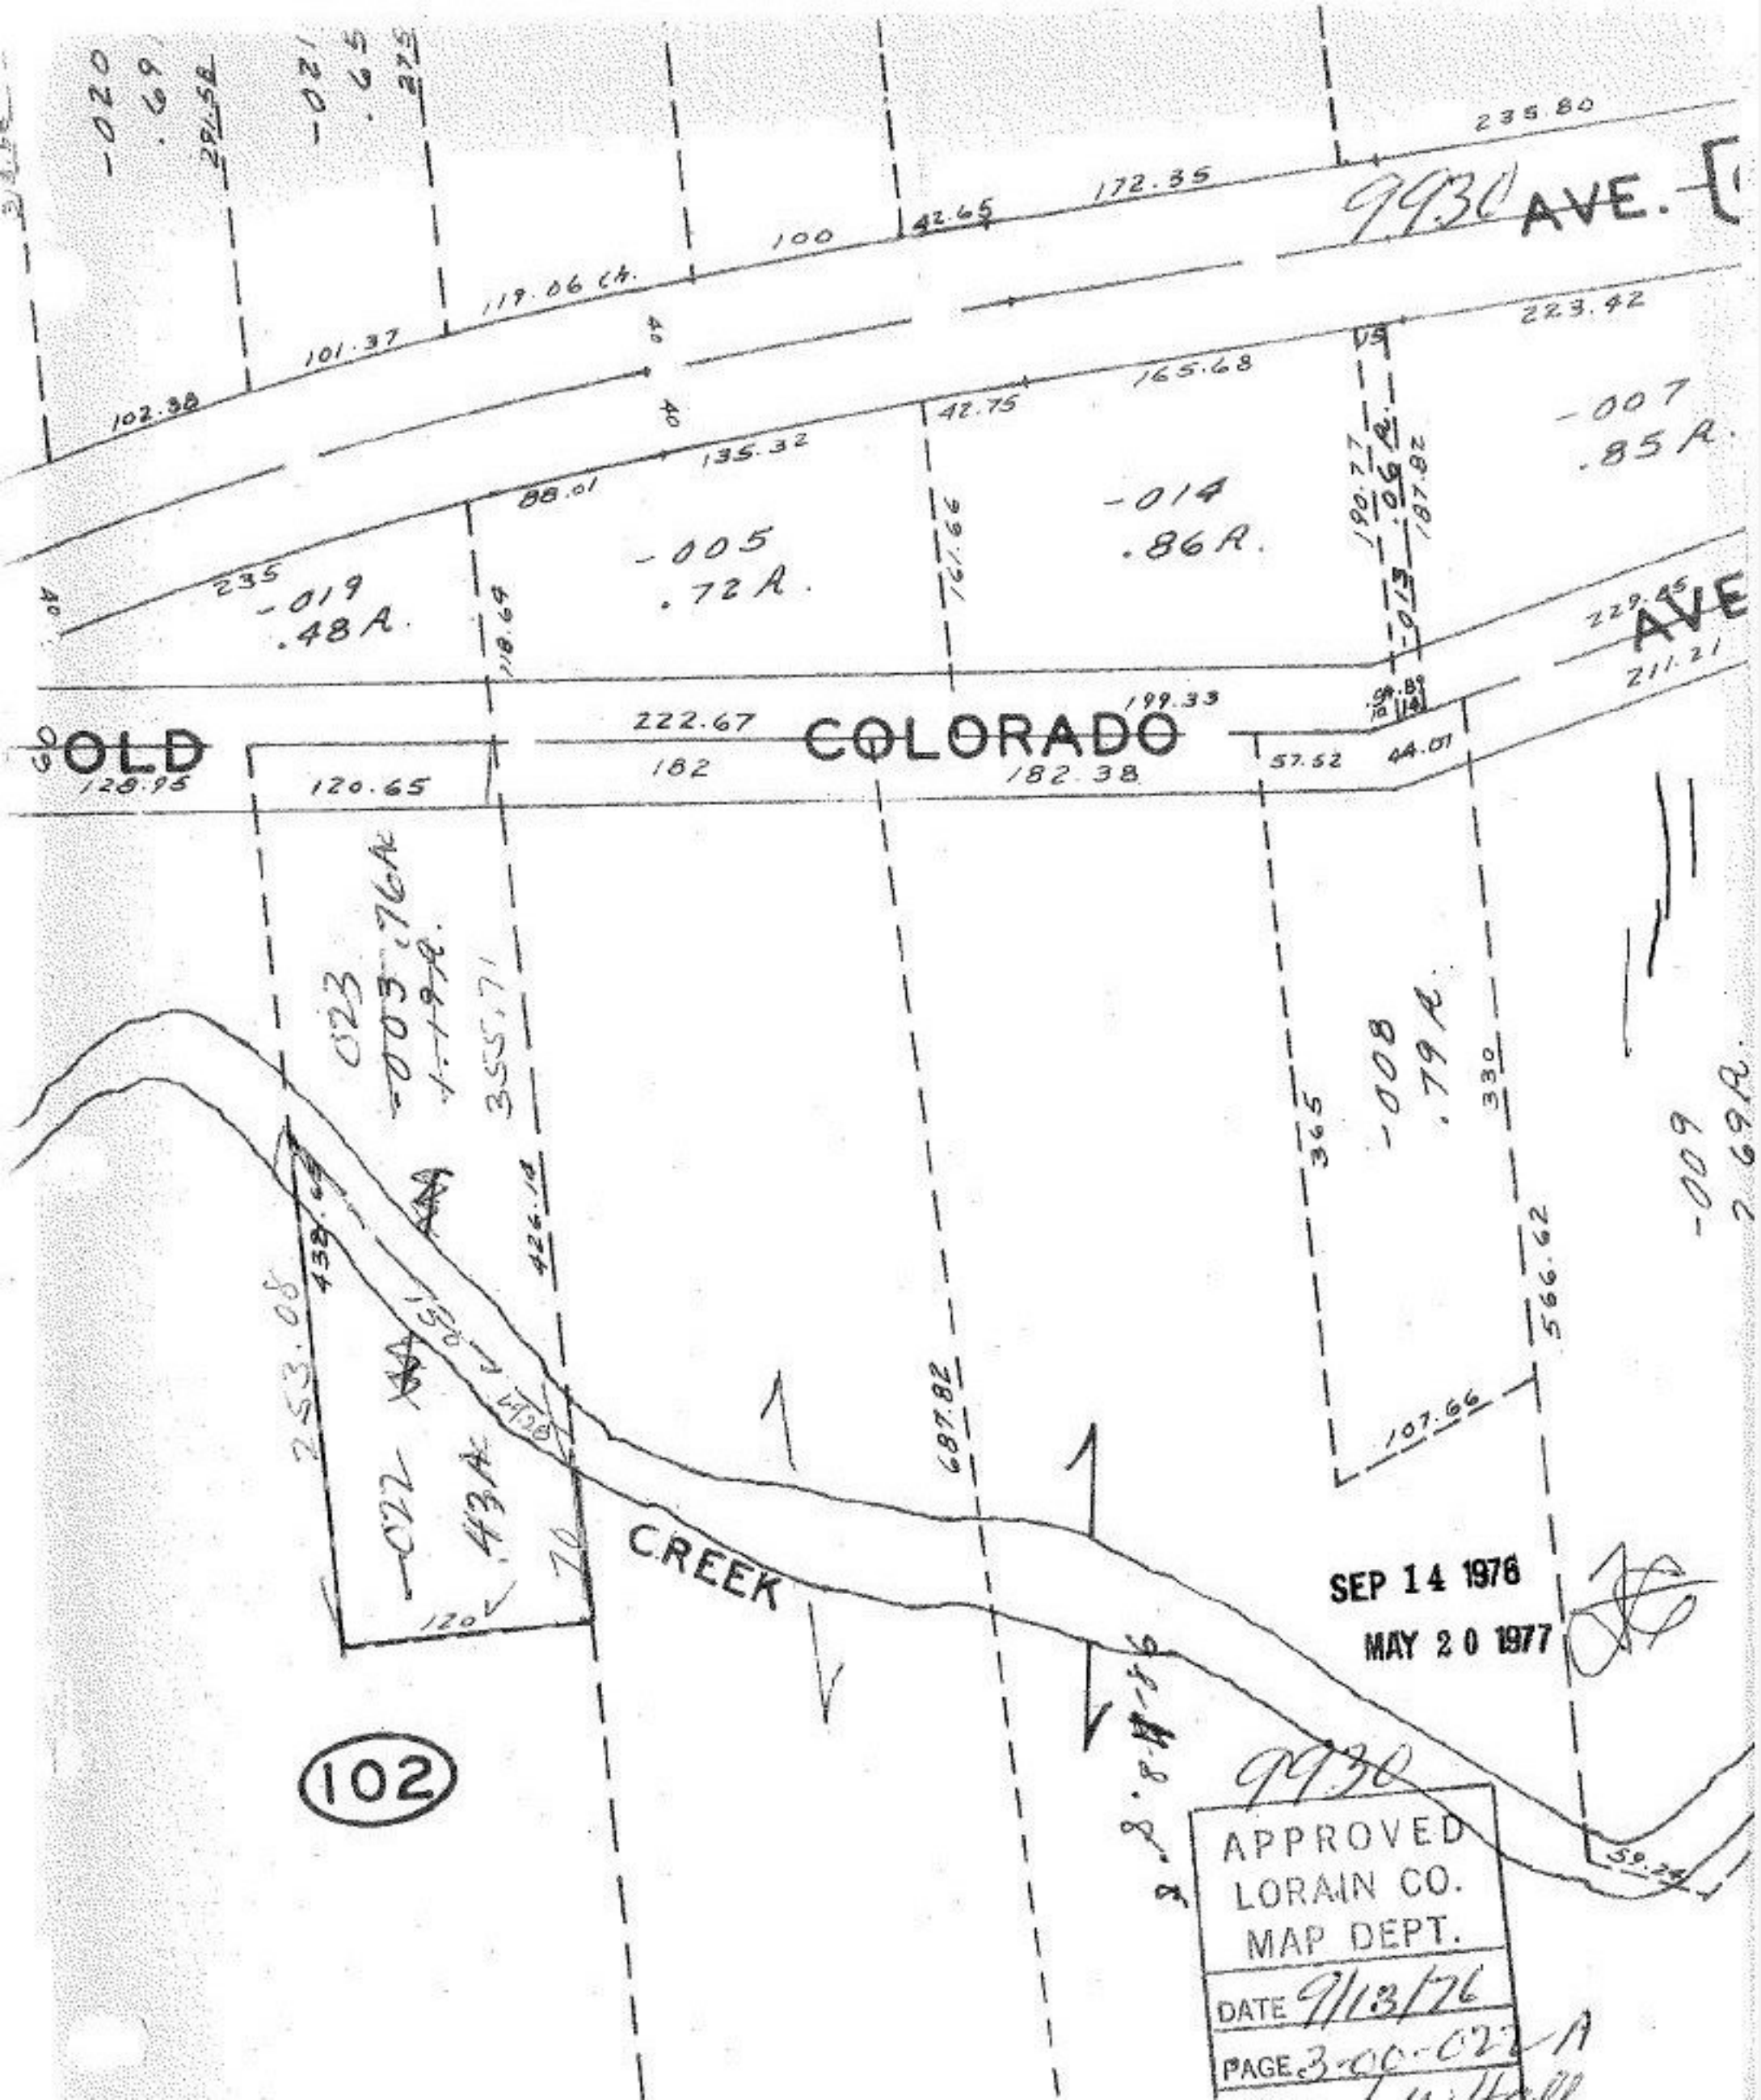

9930 AVE.
OLD COLORADO
AVE
CREEK
-020
.69
-021
.65
235.80
172.35
42.65
100
119.06 Ch.
101.37
102.38
223.42
165.68
42.75
135.32
88.01
-007
.85 A.
-014
.86 A.
-005
.72 A.
-019
.48 A.
235
229.45
211.21
199.33
222.67
182
182.38
57.52
44.01
128.95
120.65
-008
.79 A.
365
330
566.62
107.66
687.82
426.14
355.71
253.08
-022
.43 A.
120
SEP 14 1976
MAY 20 1977
102
9930
APPROVED
LORAIN CO.
MAP DEPT.
DATE 9/13/76
PAGE 3-00-022-A