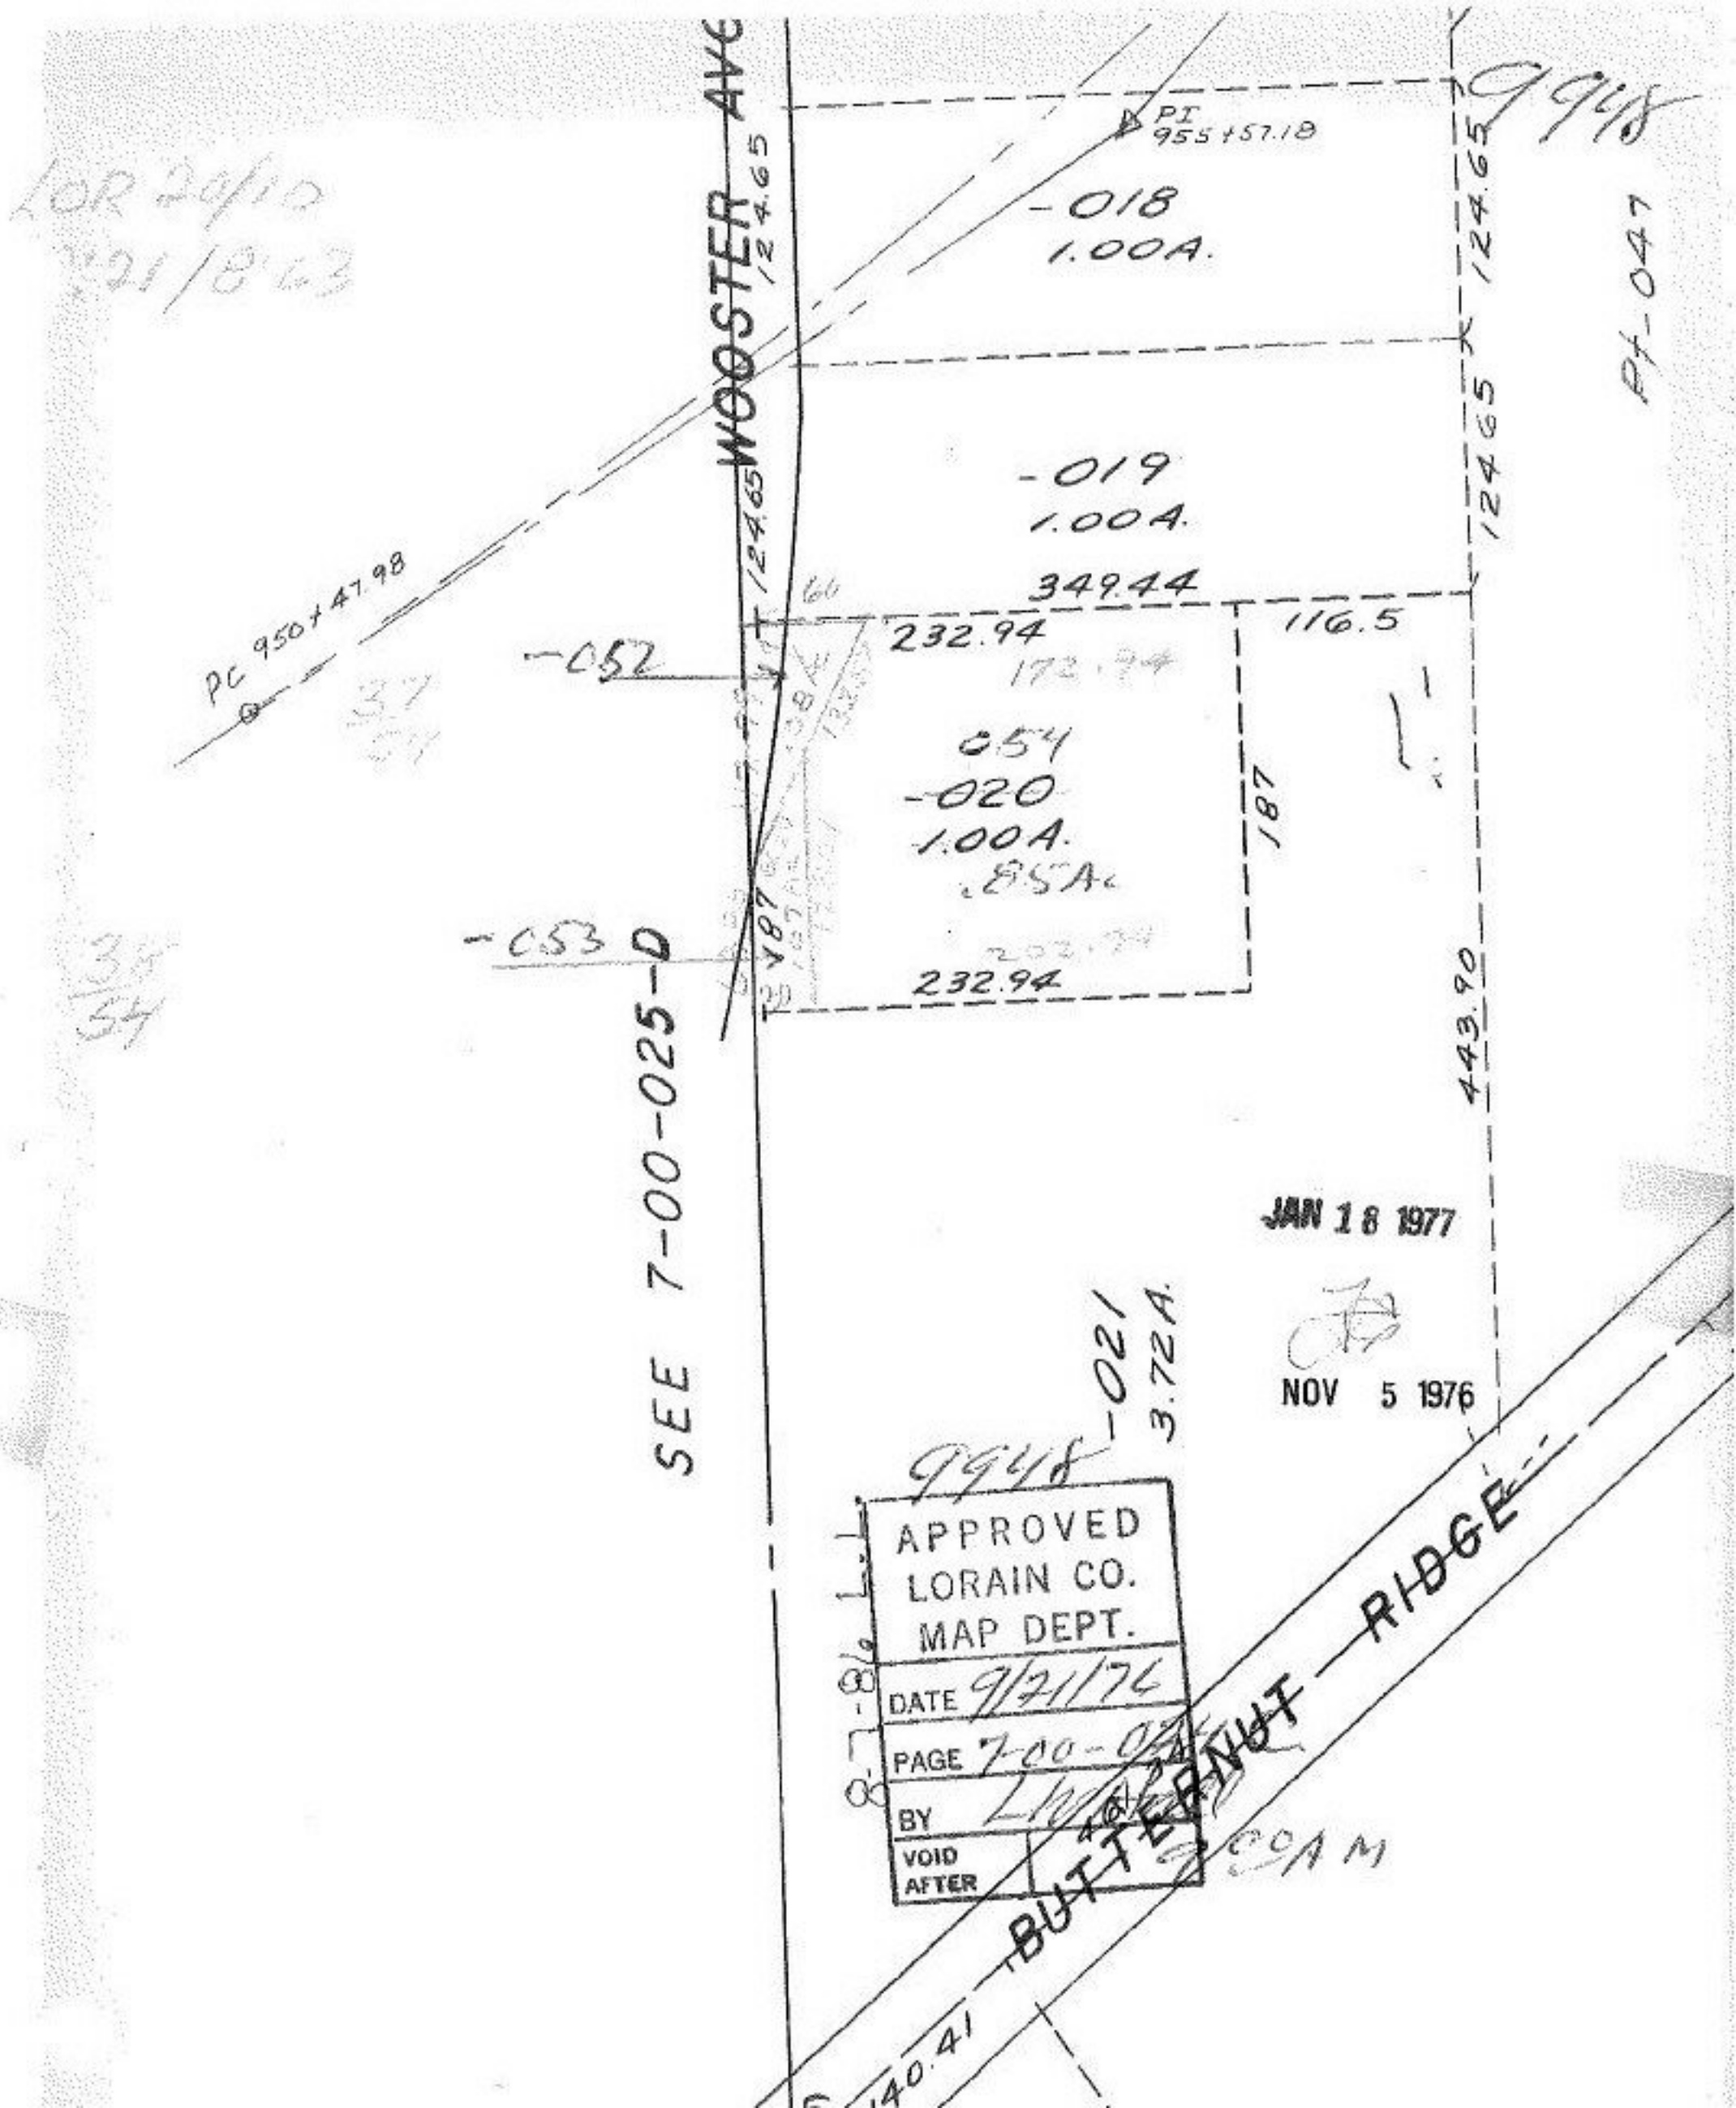

LOR 20/10
9948
PI 955+57.18
-018
1.00A.
124.65
WOOSTER AVE
-019
1.00A.
349.44
116.5
232.94
PC 950+47.98
-052
-054
-020
1.00A.
.85A.
187
-053
232.94
443.90
SEE 7-00-025-D
JAN 18 1977
NOV 5 1976
-021
3.72A.
9948
APPROVED
LORAIN CO.
MAP DEPT.
DATE 9/21/76
PAGE 7-00-024
BY
VOID AFTER
BUTTERNUT RIDGE
140.41