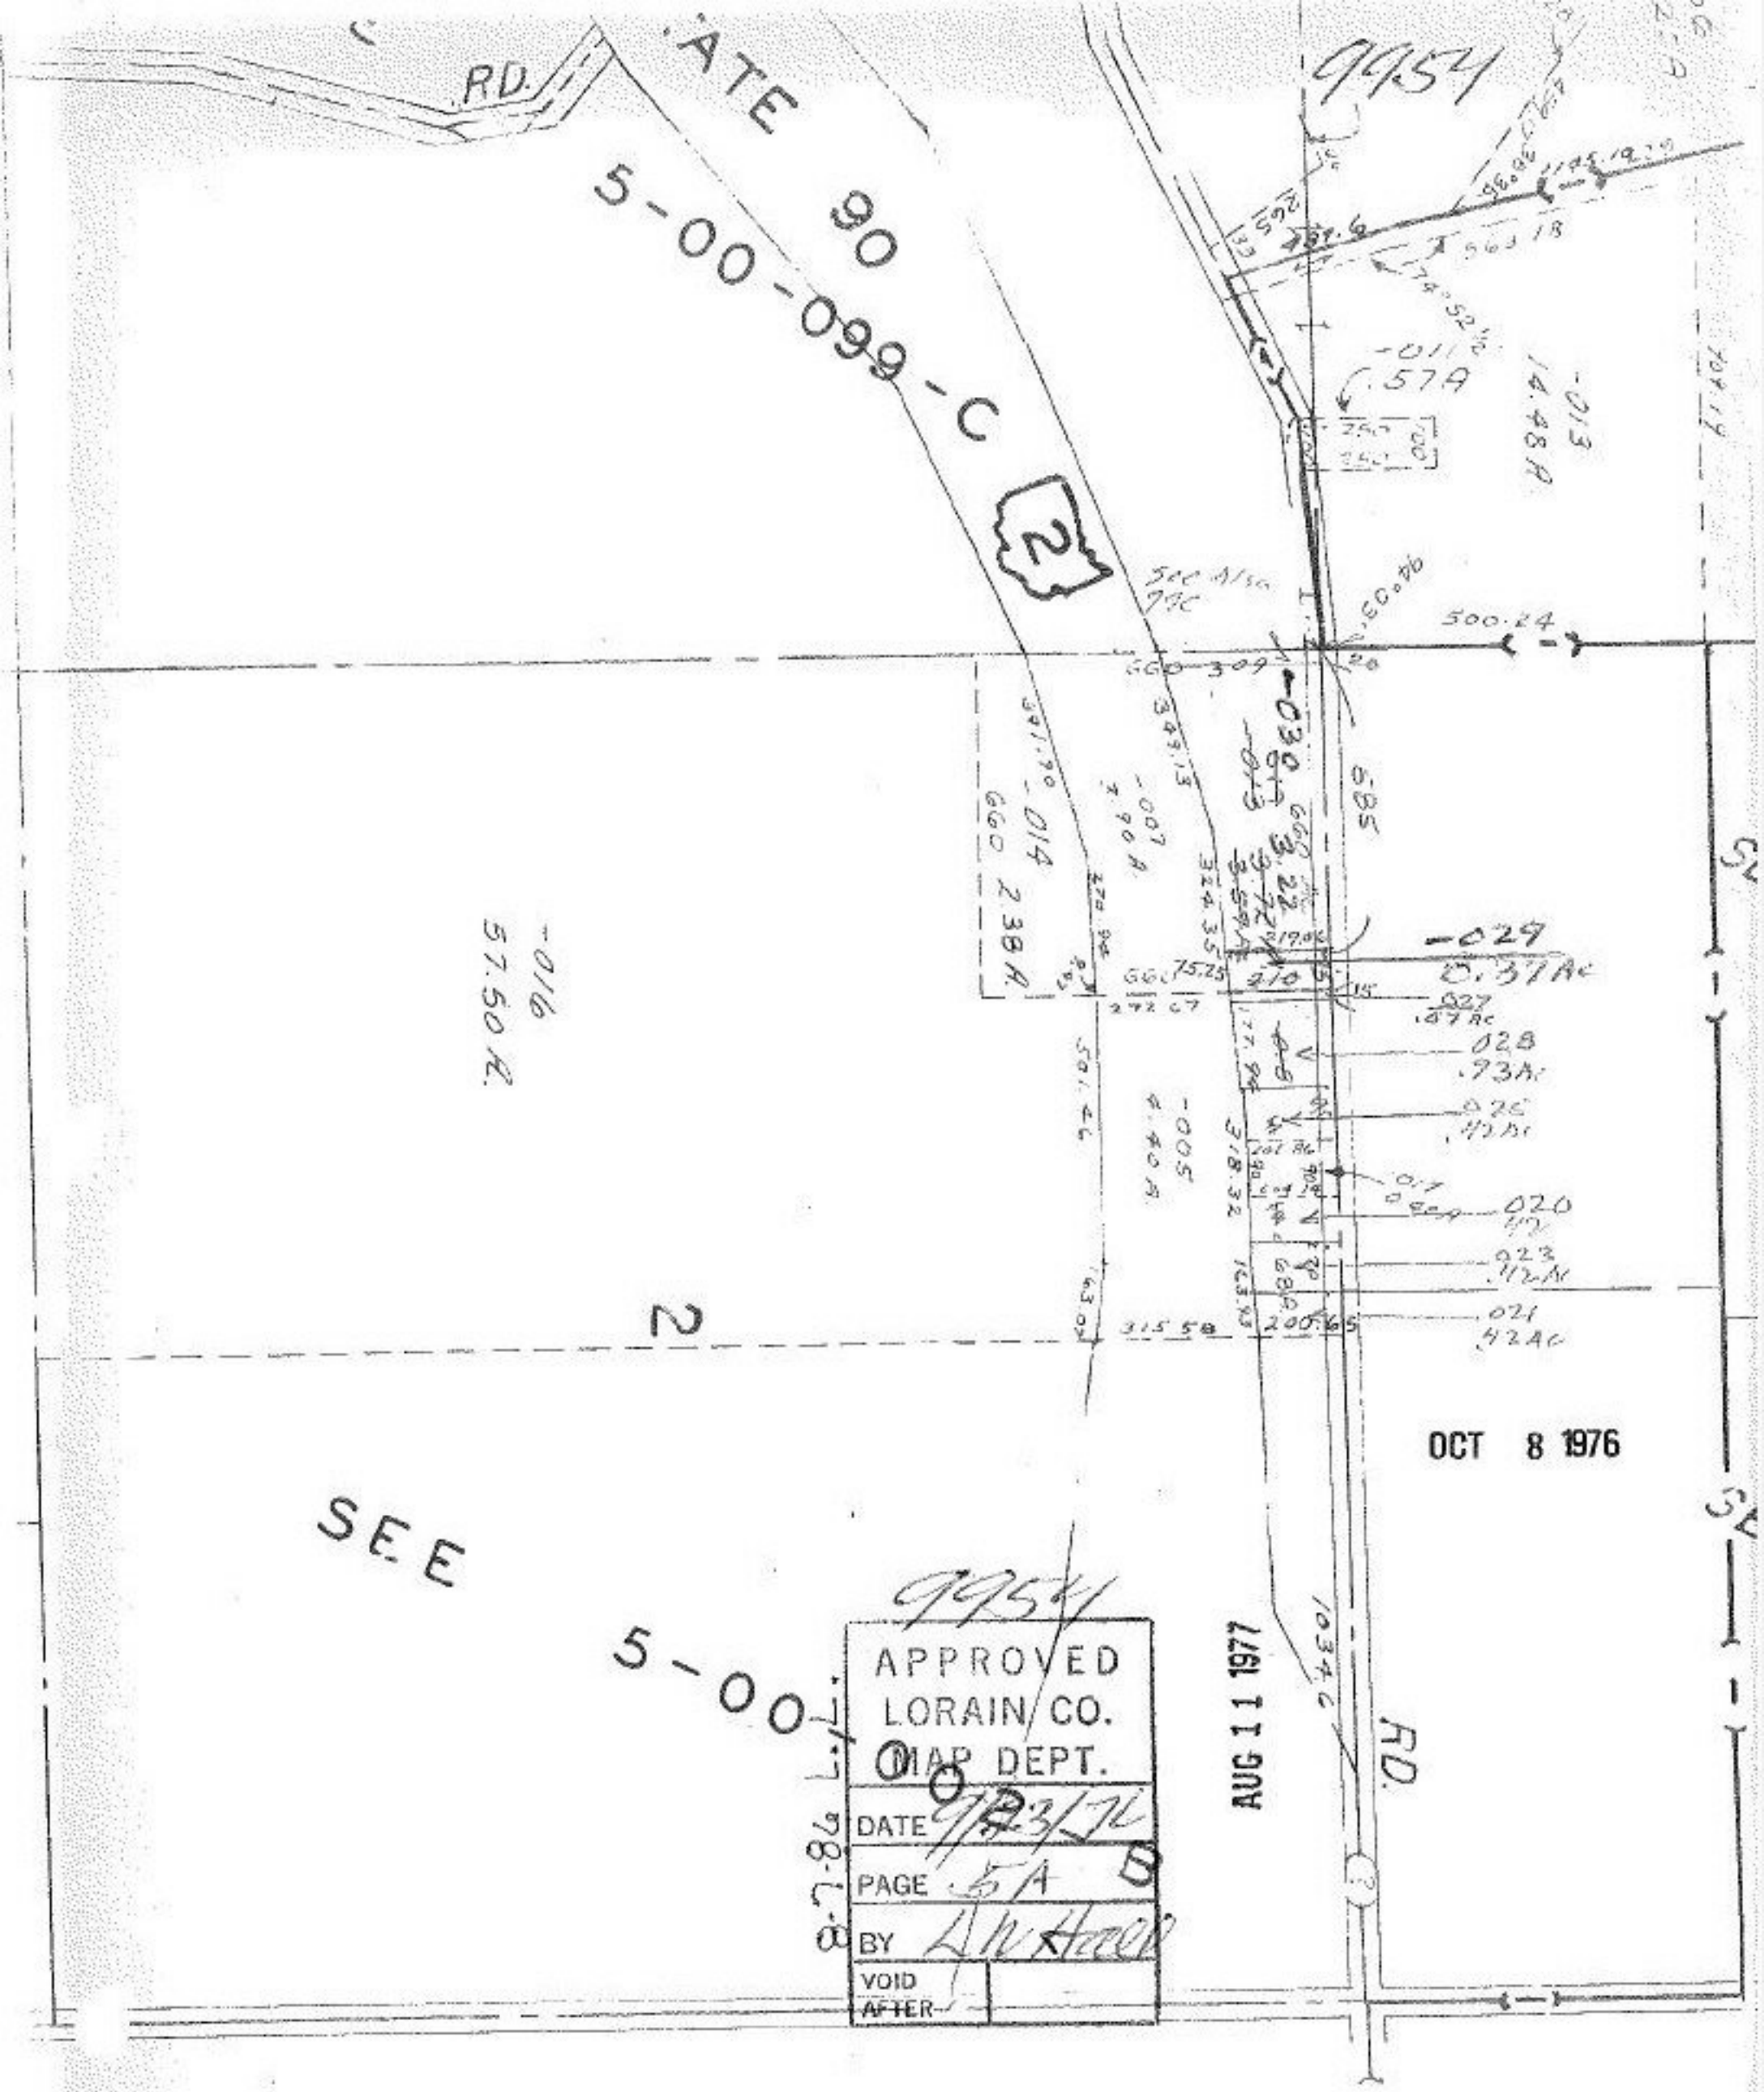

RD.
ATE 90
5-00-099-C
2
9954
-011
.57A
14.48A
-013
500.24
-030
-029
0.37Ac
-028
.93Ac
-020
-023
.42Ac
-021
.42Ac
-016
57.50 A.
2
SEE
5-00-00
OCT 8 1976
AUG 11 1977
RD.
APPROVED
LORAIN CO.
MAP DEPT.
DATE 9/23/76
PAGE 5A
BY
VOID
AFTER