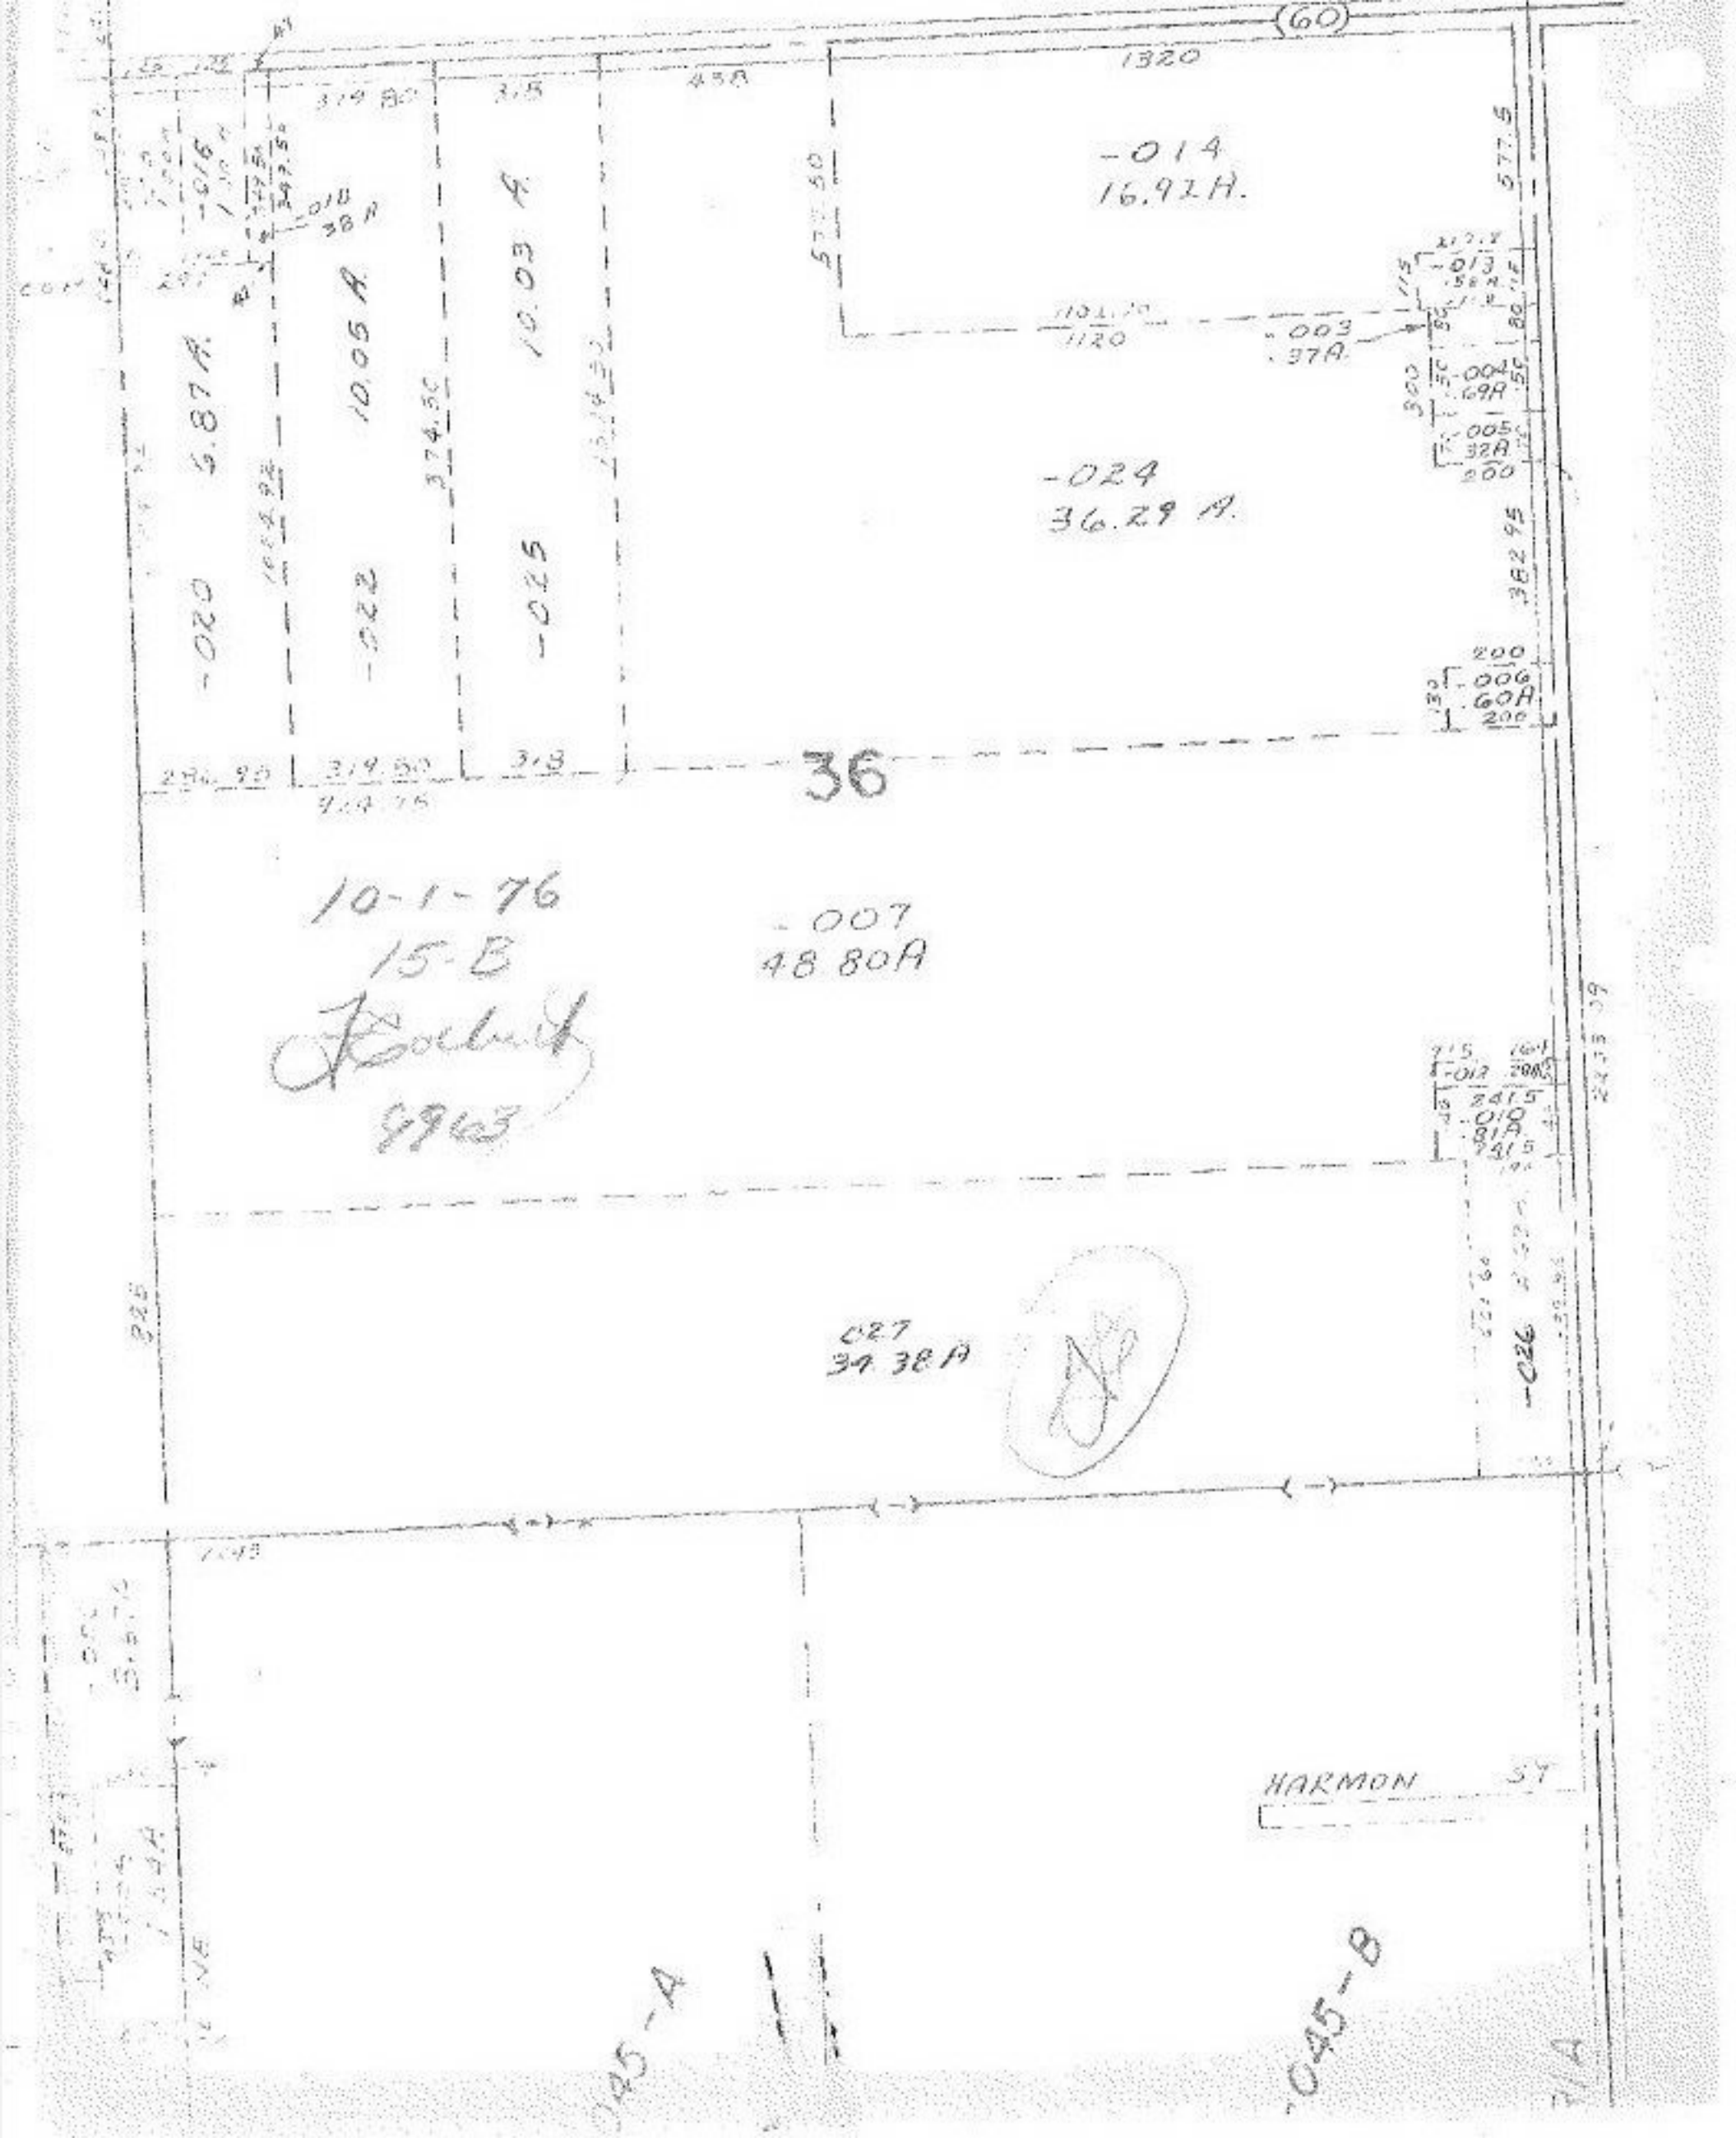

(60)
1320
-014
16.92A.
-013
-003
.37A.
-004
.69A
-005
.32A
-024
36.29 A.
-020
6.87 A.
-022
10.05 A.
-025
10.03 A.
36
10-1-76
15-B
-007
48.80A
-012
-010
.81A
-026
-027
34.38A
HARMON ST
-045-A
-045-B